IREDELL COUNTY HEALTH DEPARTMENT

SC

STATESVILLE 704-878-5305 MOORESVILLE 704-664-5281

IMPROVEMENT PERMIT / AUTHORIZATION TO CONSTRUCT / OPERATION PERMIT / EXISTING SYSTEM INSPECTION

PERMIT # 152865 PIN # 4607645758 1 DATE 10/22/08

OWNER or APPLICANT CMH Homes / Joseph Henderson PHONE: Business 704-746-4778 Home: 704-528-7960

OWNER or APPLICANT ADDRESS 189 oakbrook Dr. mooresville, NC 28115

LOCATION / DIRECTIONS Linwood Rd, TL Brumley, TR woodwinds, TR Oak Brook, on left

SUBDIVISION Quail Hill BLOCK / SECTION LOT # 59 LOT AREA DESIGN FLOW 360 gpd/day L.T.A.R. 0.3

Septic Tank existing Gallons: STB existing Date existing

Pump Tank Gallons: P T Date

Pump Make Model Serial #

Nitrification Field No Fields 1 No Lines 5 (to new) Linear Feet 250

Trench Width 36" Max. Trench Bottom Depth 36" Gravel Depth —

☐ New System ☐ Repair ☒ Expansion System Type I (II) III IV V VI

System Description: existing gravel conv. + gravity 25% reduction

Repair System Description: gravity 25%

Maintenance Agreement Required ☐ YES ☒ NO

☐ GRAVITY ☐ PRESSURE

☒ Residence No. Bedrooms 3

☐ Business No. Persons

☐ Other No. Employees

☐ Slab ☒ Crawl Space

☐ Basement w/plumbing ☐ Basement w/o plumbing

Water Supply: ☒ Private ☐ Public ☐ Community


Comments / Conditions

* Adding 2 new lines, 50' in length, 25% reduction (100' total)
* maintain all setbacks, install on contour

Comments / Conditions

* Disconnect trailer when new 3bd is connected

INITIAL SITE SKETCH

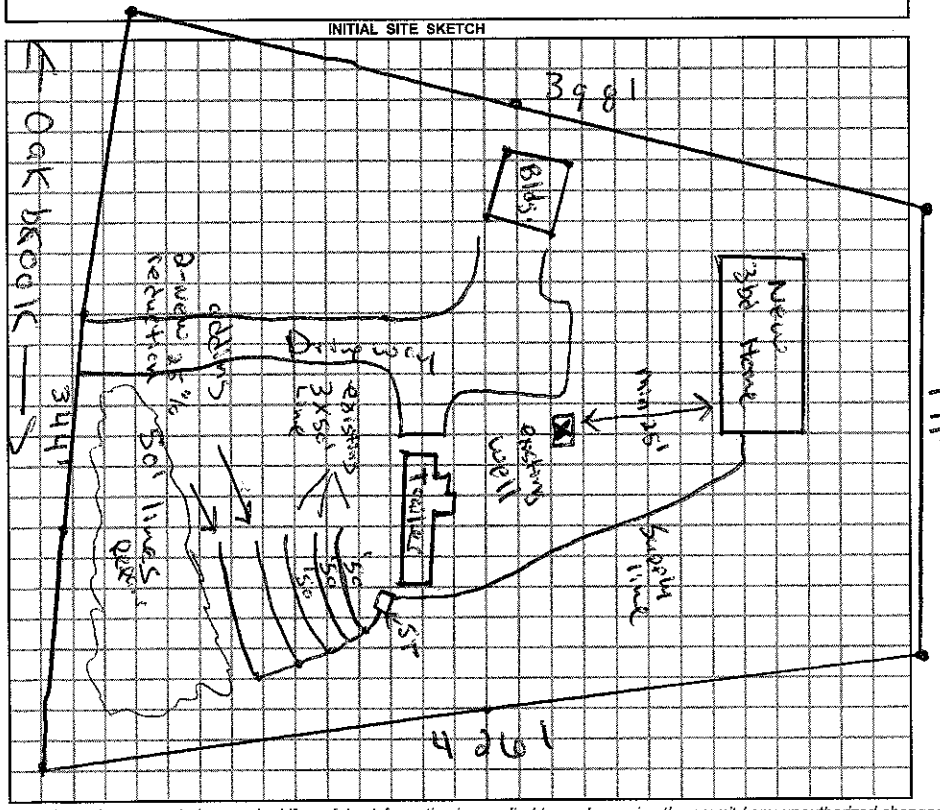

AS BUILT SKETCH

Permit can be suspended or revoked if any false information is supplied toward securing the permit / any unauthorized changes are made to the site / any unauthorized changes are made in the installation of the system.

☐ *IMPROVEMENT PERMIT w / plat valid without expiration.* ☒ *IMPROVEMENT PERMIT w / site plan valid for 60 mos.* ☒ *AUTHORIZATION TO CONSTRUCT valid for period equal to IMPROVEMENT PERMIT-not to exceed 60 mo.*

Owner / Applicant Signature: [signature] Date 10-22-08

Improvement Permit by: Randy Moore Date 10/22/08

Authorzation to Construct by: Randy Moore Date 10/22/08

YOU SHOULD CONTACT A LOCATOR SERVICE PRIOR TO ANY EXCAVATION.

Installed by: A1

Operation Permit by: Randy Moore Date: 10/27/08

Existing System Inspected by: Date:

WHITE COPY Environmental Health YELLOW COPY (Final) Owner / Applicant PINK COPY (Initial) Owner / Applicant