11:30

IREDELL COUNTY HEALTH DEPARTMENT

AUTHORIZATION TO CONSTRUCT

STATESVILLE 704-878-5305 MOORESVILLE 704-664-5281

IMPROVEMENT PERMIT / ~~CERTIFICATE OF COMPLETION~~ / OPERATION PERMIT / EXISTING SYSTEM INSPECTION

PROPERTY DESCRIPTION NO. 25057 DATE 10/4/96 TAX MAP NO. 11-11-4-26 Watershed: ☑ Yes ☐ No

OWNER OR CONTRACTOR JAY [redacted] HARDIN PHONE: Business _____ Home 4676-46-0854

ADDRESS 9416 ETHEL ST GIBSONTON, FLA. 33534

LOCATION LINWOOD - TL BRAMLEY - TR QUAIL HILL DR. - ≈ 500' ON RT.

SUBDIVISION QUAIL HILL BLOCK / SECTION _____ LOT 56 LOT AREA _____ SITE CLASS. PS DESIGN FLOW 360 GPD L.T.A.R. .36 GPD/FT²

Septic Tank: 1000 Gallons; STB [redacted] 794 Date 10-9-96

Pump Tank: _____ Gallons; PT [redacted] 27 Date 11-10-96

Pump Make: _____ Model _____ Serial No. _____

Nitrification Field: No Fields 1 Square Feet 1200 Linear Feet 400

No Lines 4 Trench Width 36" Max Trench Bottom Depth 36" Gravel Depth 12"

☑ New System ☐ Repair System Type: I, II, (III) IV, V, VI

System Description: PUMP CONVENTIONAL

Repair System Description: PUMP PANEL

Maintenance Agreement Required: ☐ Yes ☑ No

☐ House/Mod. Home ☑ Mobile Home ☐ Business ☐ Other

No. Bedrooms 3 No. Bathrooms 2 No. Employees _____


☐ Slab ☑ Crawl Space ☐ Basement w/plumbing ☐ Basement wo/plumbing

Water Supply: ☑ Individual ☐ Community ☐ Public


Comments: Soil 9-1 7-11 6-4 6-5

Comments: Lines - Tanks checked 12/27/96 CBF
PRESSURE CHECKED 1-7-97

INITIAL SITE SKETCH (NOT TO SCALE)

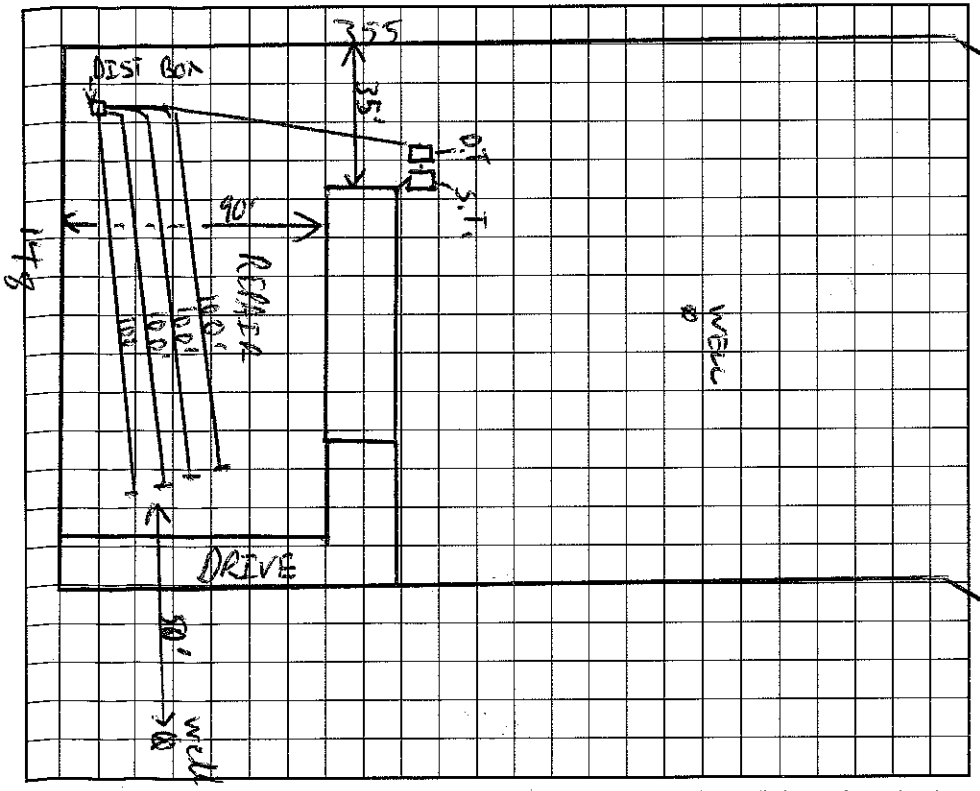

AS BUILT SKETCH

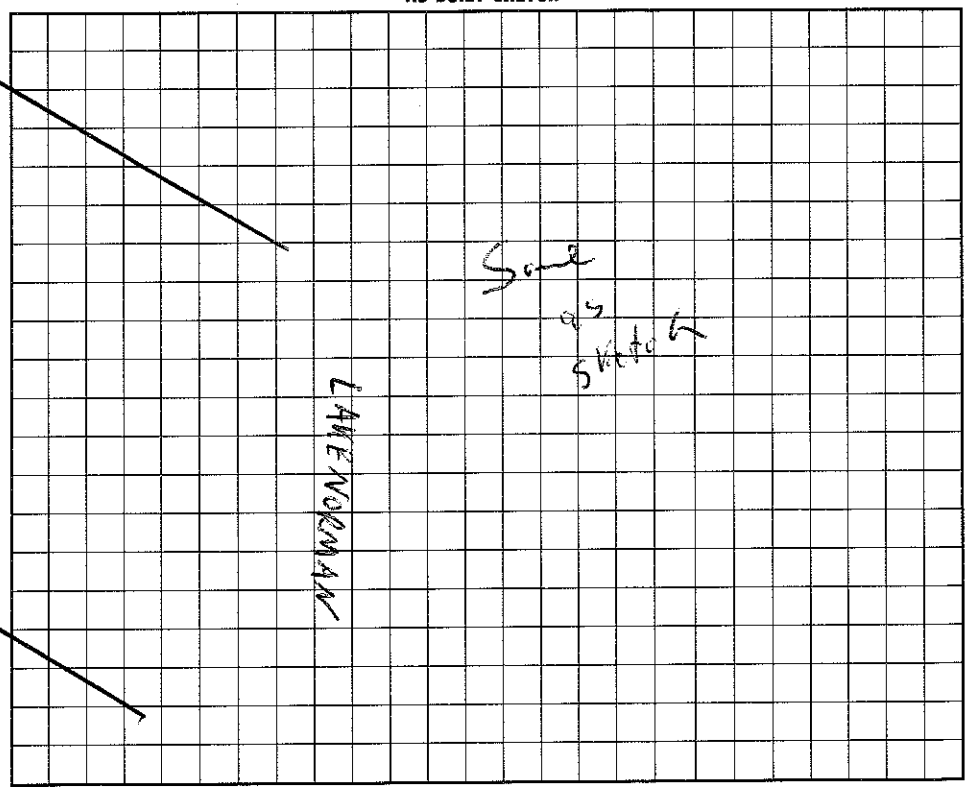

I understand that this permit can be suspended or revoked if any false information is supplied toward securing the permit/any unauthorized changes are made to the site/any unauthorized changes are made in the installation of the system.

Signed: [signature]

Improvement Permit by: C. B. Green EHSI date 10/4/96

AUTHORIZATION TO CONSTRUCT ~~Existing System Inspection by:~~ C. B. Green EHSI date 10/4/96

Installed by: LEVON BENTON

Certificate of Completion by: _____ date _____

Operation Permit by: C. B. Green date 7/15/08

HEALTH DEPT. COPY: WHITE INSPECTION COPY (FINAL): GREEN OWNER COPY (FINAL): YELLOW INSPECTION COPY (INITIAL): PINK OWNER COPY (INITIAL): GOLD