IREDELL COUNTY HEALTH DEPARTMENT

STATESVILLE 704-878-5305 MOORESVILLE 704-664-5281

IMPROVEMENT PERMIT / CERTIFICATE OF COMPLETION / OPERATION PERMIT / EXISTING SYSTEM INSPECTION

PROPERTY DESCRIPTION NO. 24146 DATE 6/27/96 TAX MAP NO. 1H 11A 25 Watershed: [X] Yes [ ] No

OWNER OR CONTRACTOR Patricia Gabriel PHONE: Business Home 664-9196

ADDRESS 142 Quail Hill Dr. Mooresville, NC 28115 704-76-46-1938

LOCATION Bryan Cy Te Quail Hill to 5th drive on (R)

SUBDIVISION Quail Hill BLOCK / SECTION 1 LOT 25 LOT AREA ~1 AC SITE CLASS. DESIGN FLOW L.T.A.R.

Septic Tank: Existing Gallons; STB Date

Pump Tank: Gallons; PT Date

Pump Make: Model Serial No.

Nitrification Field: No Fields Square Feet Linear Feet

No Lines Trench Width Max Trench Bottom Depth Gravel Depth

[ ] New System [ ] Repair System Type: I II III IV V VI

System Description: Existing System

Repair System Description:

Maintenance Agreement Required: [ ] Yes [ ] No

[X] House/Mod. Home No. Bedrooms 3

[ ] Mobile Home No. Bathrooms 2

[ ] Business No. Employees

[ ] Other

[ ] Slab [ ] Crawl Space [ ] Basement w/plumbing [ ] Basement wo/plumbing


Water Supply:
[X] Individual
[ ] Community
[ ] Public

Comments:

Comments: No sign of malfunction

INITIAL SITE SKETCH

AS BUILT SKETCH

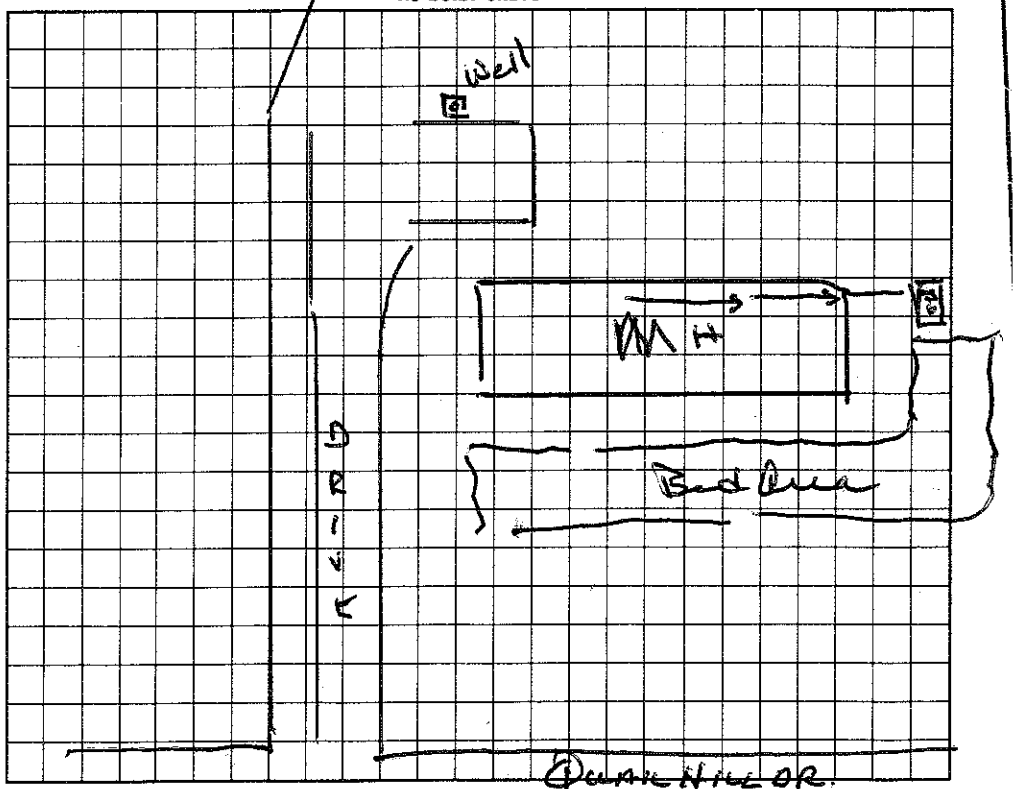

I understand that this permit can be suspended or revoked if any false information is supplied toward securing the permit/any unauthorized changes are made to the site/any unauthorized changes are made in the installation of the system.

Signed:

Improvement Permit by: date

Existing System Inspection by: date

Installed by: Existing System

Certificate of Completion by: Wesley Sparks R.S. date 6/27/96

Operation Permit by: date

HEALTH DEPT. COPY: WHITE INSPECTION COPY (FINAL): GREEN OWNER COPY (FINAL): YELLOW INSPECTION COPY (INITIAL): PINK OWNER COPY (INITIAL): GOLD