IREDELL COUNTY HEALTH DEPARTMENT - *ENVIRONMENTAL HEALTH* ☐ STATESVILLE OFFICE 704-878-5305 ☒ MOORESVILLE OFFICE 704-664-5281

IMPROVEMENT PERMIT / AUTHORIZATION TO CONSTRUCT / OPERATION PERMIT / EXISTING SYSTEM INSPECTION

PERMIT # 170332 PIN # 4676-47-0426 DATE 2-16-12

OWNER Emma Choate APPLICANT: SAME PHONE: Home/Cell # 704-663-5696 Business #

SITE ADDRESS 551 Brumley Rd OWNER / APPLICANT ADDRESS SAME

SITE DIRECTIONS Main Street, Linwood Rd, Brumley

SUBDIVISION Quail Hill BLOCK / SECTION 1 LOT # 3 & 3 LOT AREA .844 AC DESIGN FLOW 360 GPD L.T.A.R.

Septic Tank Ex. 1000 Gallons: STB Date

Pump Tank Gallons: P T Date

Pump Make Model Serial #

No. Nitrification Fields: No. Lines Linear Feet

Trench Width Max. Trench Bottom Depth Gravel Depth

☐ New System ☐ Repair ☐ Expansion System Type I (II) III IV V VI

System Description: CONVENTIONAL

Repair System Description:

Maintenance Agreement Required ☐ YES ☒ NO

EXISTING ☒ GRAVITY ☐ PRESSURE

☒ Residence No. Bedrooms 3

☐ Business No. Persons

☐ Other No. Employees

☐ Slab ☒ Crawl Space

☐ Basement w/plumbing ☐ Basement w/o plumbing

Water Supply

☒ Private

☐ Public


☐ Community

Comments / Conditions ① SYSTEM NOT FAILING @ TIME OF INSPECTION BUT SYSTEM WAS SATURATED WHEN PROBED ② NEW HOME MUST BE MIN 5' FROM TANK

INITIAL SITE SKETCH

1" = 50'

AS BUILT SKETCH

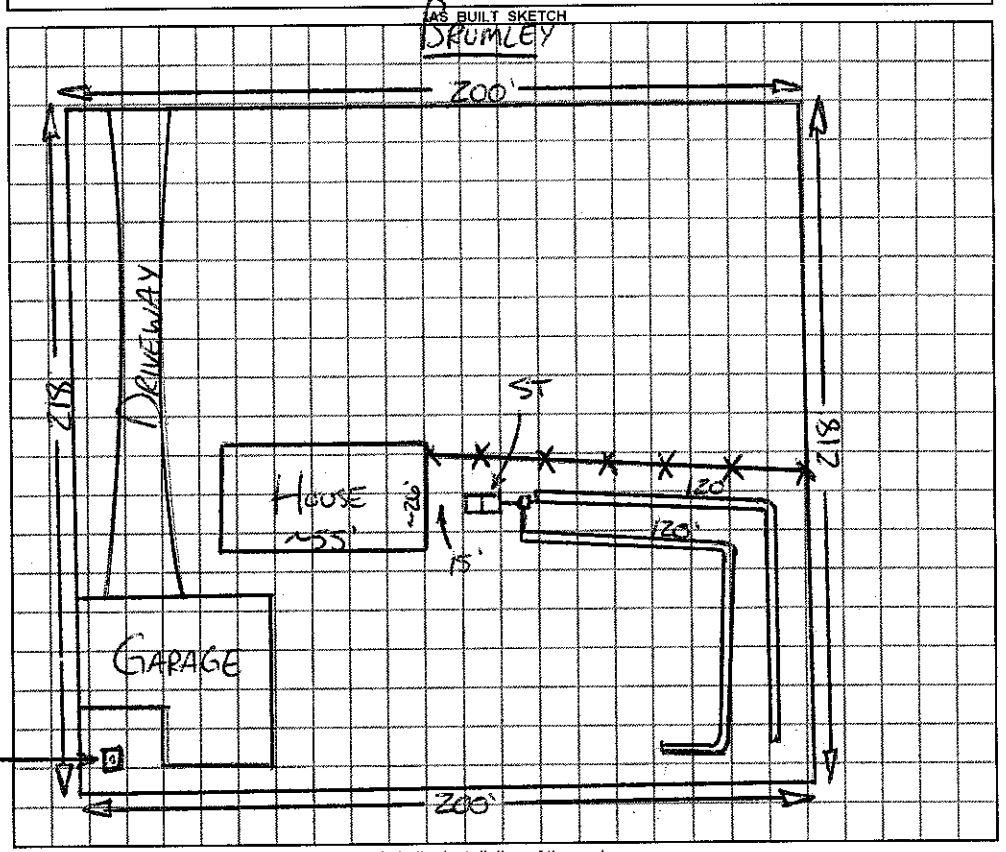

Permit can be suspended or revoked if any false information is supplied toward securing the permit / any unauthorized changes are made to the site / any unauthorized changes are made in the installation of the system.

☐ ***IMPROVEMENT PERMIT*** with plat valid without expiration. ☐ ***IMPROVEMENT PERMIT*** with ~~plat valid without expiration.~~ site plan valid 60 mo. ☐ ***AUTHORIZATION TO CONSTRUCT*** valid for period equal to IMPROVEMENT PERMIT--not to exceed 60 mo.

Owner / Applicant Signature X Emma Choate by Sandra Davis Date 3-8-12 Installed by:

IMPROVEMENT PERMIT by: REHS Date OPERATION PERMIT by: REHS Date

AUTHORIZATION TO CONSTRUCT by: REHS Date Existing System Inspected by: REHS Date 2-17-12

YOU SHOULD CONTACT A LOCATOR SERVICE PRIOR TO ANY EXCAVATION

White Copy -- Environmental Health YELLOW COPY (Final) Owner / Applicant PINK COPY (Initial) Owner / Applicant