IREDELL COUNTY HEALTH DEPARTMENT

Authorization to Construct

STATESVILLE 704-878-5305 MOORESVILLE 704-664-5281

IMPROVEMENT PERMIT / CERTIFICATE OF COMPLETION / OPERATION PERMIT / EXISTING SYSTEM INSPECTION

PROPERTY DESCRIPTION NO. 22748 DATE 12/1/95 TAX MAP NO. 1H 11 A 24 Watershed: [X] Yes [ ] No

OWNER OR CONTRACTOR Michael Welkie PHONE: Business _____ Home 664-7596

ADDRESS 156 Quail Hill Dr. Mooresville, NC. 28115 4676-47-2195

LOCATION Bramley TR 2nd Quail Hill on (R) at intersection with Lakewind Rd.

SUBDIVISION Quail Hill BLOCK / SECTION _____ LOT 24 LOT AREA 120X279 SITE CLASS. PS DESIGN FLOW 480 L.T.A.R. .3

Septic Tank: Existing Gallons; STB _____ Date _____

Pump Tank: _____ Gallons; PT _____ Date _____

Pump Make: _____ Model _____ Serial No. _____

Nitrification Field No Fields 1 Square Feet 780 Linear Feet 260

No Lines 2@100x3' Trench Width 36" Max Trench Bottom Depth 36" Gravel Depth 12"

[ ] New System [X] Repair System Type: I, [II], III, IV, V, VI

System Description: Additional Line

Repair System Description: _____

Maintenance Agreement Required: [ ] Yes [X] No

[ ] House/Mod. Home No. Bedrooms 4

[X] Mobile Home No. Bathrooms 3

[ ] Business No. Employees _____

[ ] Other _____

[ ] Slab [X] Crawl Space [ ] Basement w/plumbing [ ] Basement wo/plumbing


Water Supply: [X] Individual [ ] Community [ ] Public

Comments:


Changing Mobile Homes
Adding 20' LD each existing drainline plus
200' of additional drainline

Comments:

INITIAL SITE SKETCH

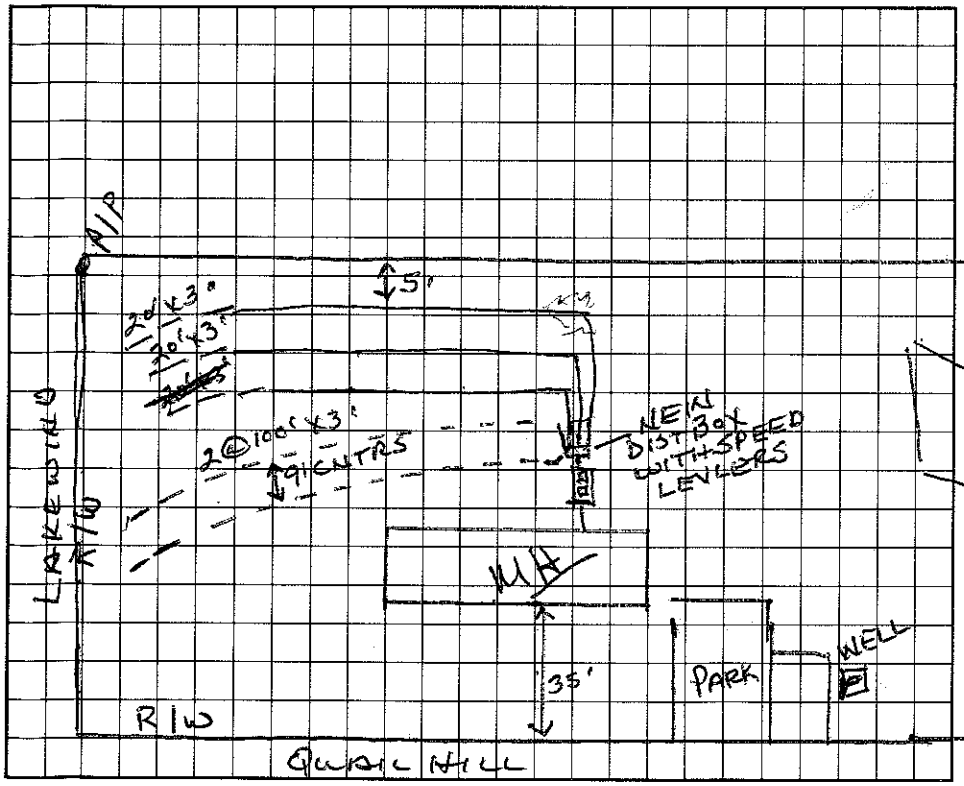

AS BUILT SKETCH

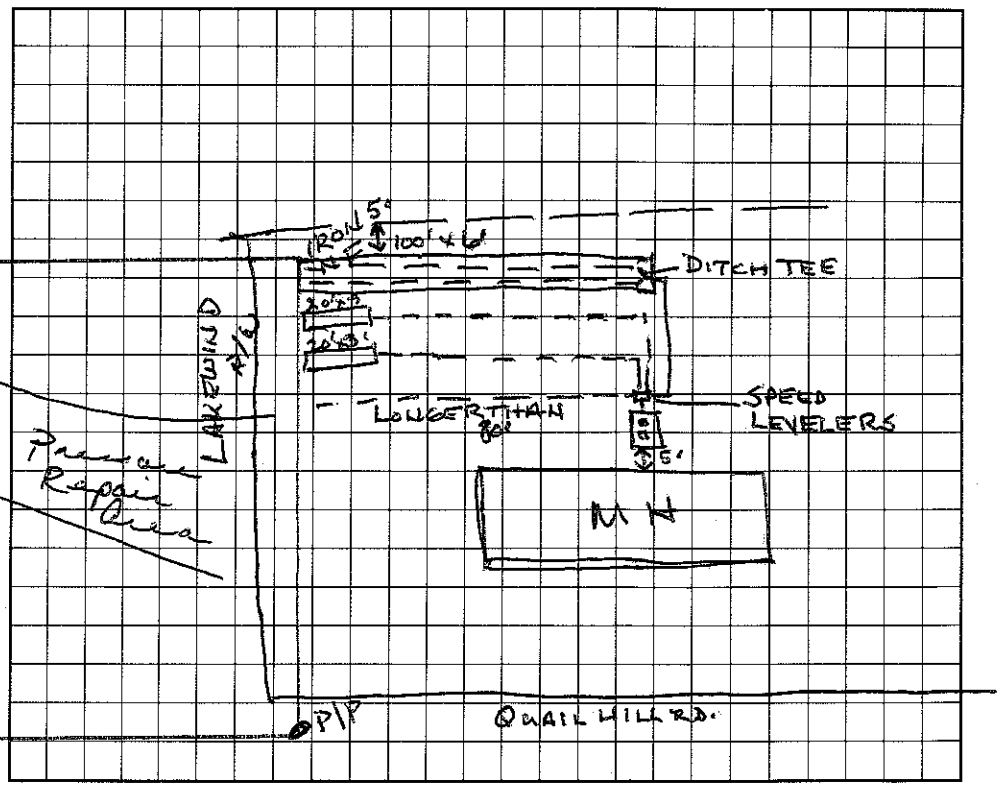

I understand that this permit can be suspended or revoked if any false information is supplied toward securing the permit/any unauthorized changes are made to the site/any unauthorized changes are made in the installation of the system.

Signed: x Barbara Welkie

Improvement Permit by: Wesley Sparks RS. date 12/1/95

Authorization to Construct: Wesley Sparks RS. date 12/1/95

Existing System Inspection by: _____ date _____

Installed by: Dennis Belcher

Certificate of Completion by: Wesley Sparks RS. date 12/15/95

Operation Permit by: Wesley Sparks RS. date 12/15/95

HEALTH DEPT. COPY: WHITE INSPECTION COPY (FINAL): GREEN OWNER COPY (FINAL): YELLOW INSPECTION COPY (INITIAL): PINK OWNER COPY (INITIAL): GOLD