IREDELL COUNTY HEALTH DEPARTMENT - *ENVIRONMENTAL HEALTH* ☐ STATESVILLE OFFICE 704-878-5305 ☐ MOORESVILLE OFFICE 704-664-5281 - DM

IMPROVEMENT PERMIT / AUTHORIZATION TO CONSTRUCT / OPERATION PERMIT / EXISTING SYSTEM INSPECTION

PERMIT # 166350 PIN # 4676-47-2507 DATE 5-27-11

OWNER TANYA PIETERSE APPLICANT: SAME PHONE: Home/Cell # 704-799-5186 Business #

SITE ADDRESS 539 BRUMLEY RD OWNER / APPLICANT ADDRESS SAME

SITE DIRECTIONS 152 E, TR BRUMLEY, ON L

SUBDIVISION QUAIL HILL BLOCK / SECTION LOT # 2 LOT AREA DESIGN FLOW 360 L.T.A.R. .3 (PER PERMIT 020476)

Septic Tank Ex. 1000 Gallons: STB Date

Pump Tank Gallons: P T Date

Pump Make Model Serial #

No. Nitrification Fields: No. ~~Lines~~ XL STRAIGHT ~~Linear Feet~~ 400'

Trench Width Max. Trench Bottom Depth Gravel Depth

☐ New System ☐ Repair ☐ Expansion System Type I (II) III IV V VI

System Description: GRAVEL

Repair System Description: SAME

Maintenance Agreement Required ☐ YES ☒ NO

☒ GRAVITY ☐ PRESSURE

☒ Residence No. Bedrooms 3

☐ Business No. Persons

☐ Other No. Employees


☐ Slab ☒ Crawl Space

☐ Basement w/plumbing ☐ Basement w/o plumbing


Water Supply: ☒ Private ☐ Public ☐ Community

Comments / Conditions

INITIAL SITE SKETCH

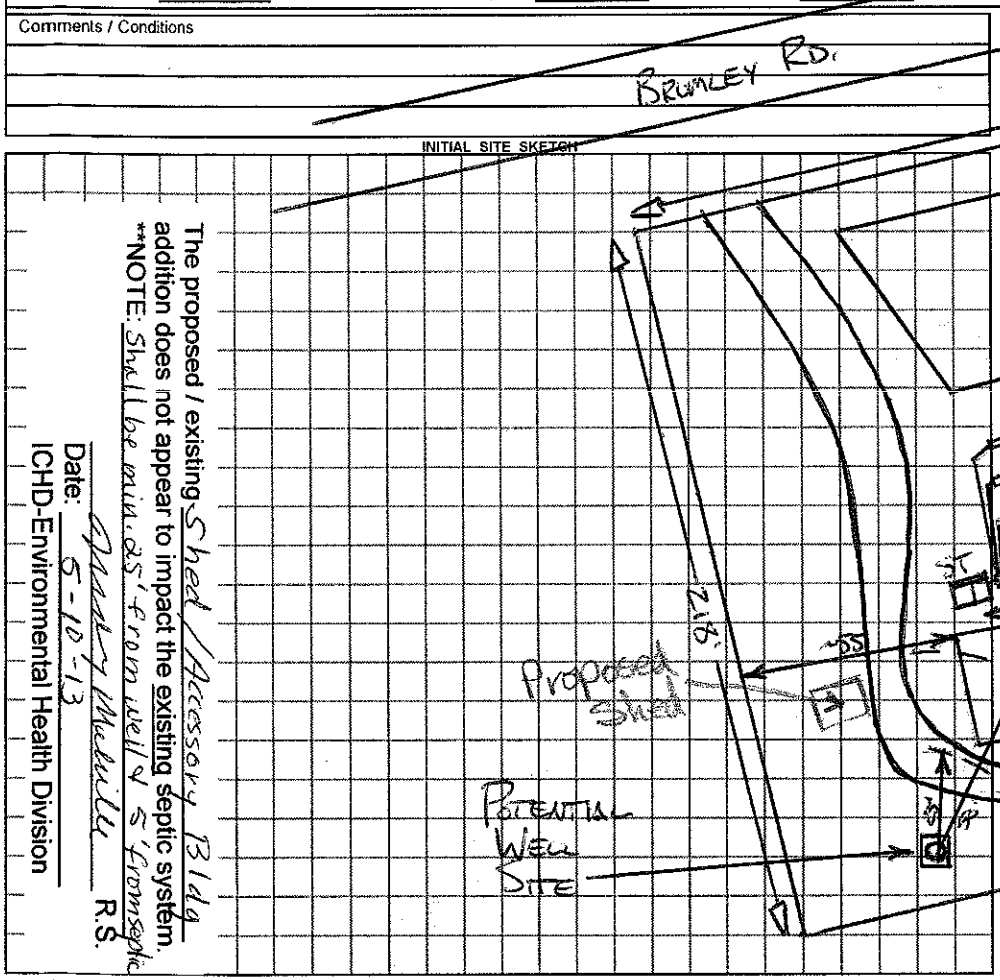

AS BUILT SKETCH

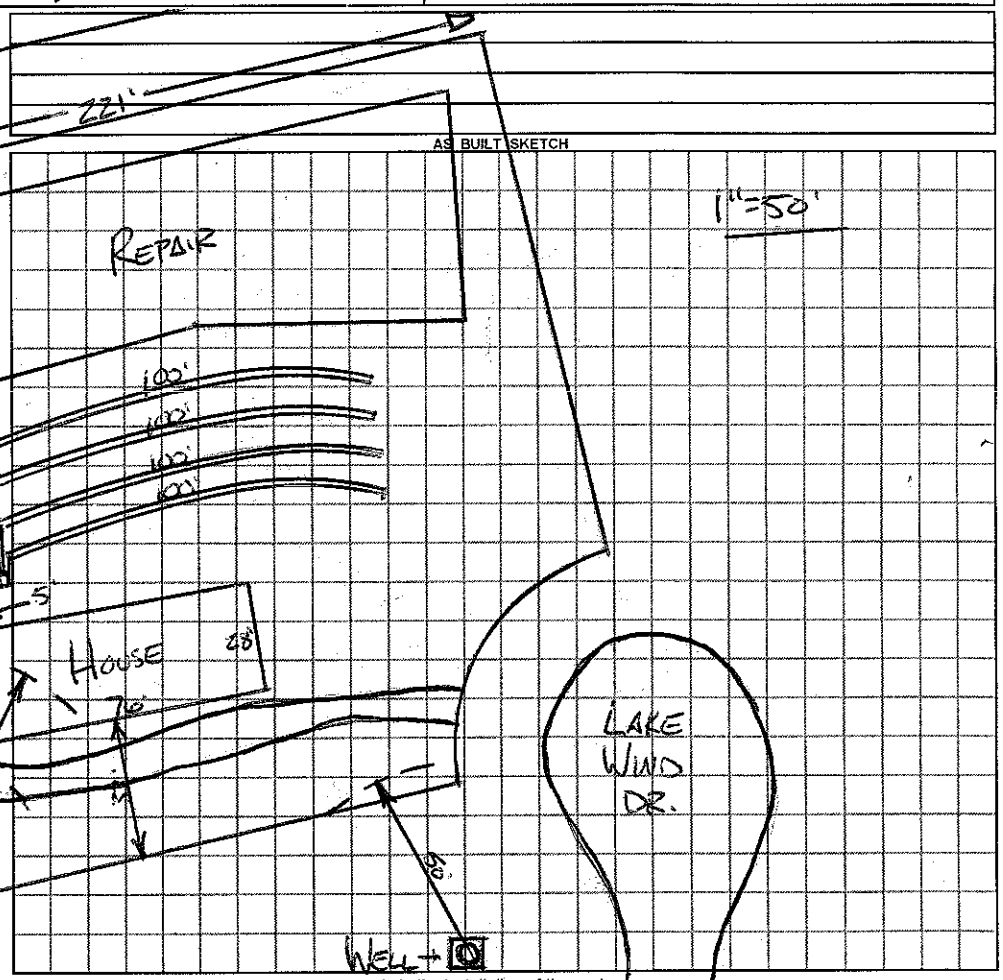

The proposed / existing Shed / Accessory Bldg addition does not appear to impact the existing septic system.

**NOTE: Shall be min. 25' from well & 5' from septic

Date: 5-10-13 R.S.

ICHD-Environmental Health Division

Permit can be suspended or revoked if any false information is supplied toward securing the permit / any unauthorized changes are made to the site / any unauthorized changes are made in the installation of the system.

☐ ***IMPROVEMENT PERMIT*** with plat valid without expiration. ☐ ***IMPROVEMENT PERMIT*** with ~~plat valid without expiration~~ site plan valid 60 mo. ☐ ***AUTHORIZATION TO CONSTRUCT*** valid for period equal to IMPROVEMENT PERMIT--not to exceed 60 mo.

Owner / Applicant Signature: Pietrse Date 05/27/2011 Installed by:

IMPROVEMENT PERMIT by: ~~B.A.~~ ***REHS*** Date ~~5-27-11~~ OPERATION PERMIT by: ***REHS*** Date

AUTHORIZATION TO CONSTRUCT by: ***REHS*** Date Existing System Inspected by: B.A. ***REHS*** Date 5-27-11

YOU SHOULD CONTACT A LOCATOR SERVICE PRIOR TO ANY EXCAVATION

White Copy – Environmental Health YELLOW COPY (Final) Owner / Applicant PINK COPY (Initial) Owner / Applicant