IREDELL COUNTY HEALTH DEPARTMENT

STATESVILLE 704-878-5305 MOORESVILLE 704-664-5281

IMPROVEMENT PERMIT / CERTIFICATE OF COMPLETION / OPERATION PERMIT / EXISTING SYSTEM INSPECTION

PROPERTY DESCRIPTION NO. 20476 DATE 3/14/95 TAX MAP NO. 1H 11 142 Watershed: ☑ Yes ☐ No

OWNER OR CONTRACTOR Charles + Debra Bowers PHONE: Business 376-5207 Home 4676-47-2507

ADDRESS 152 Royal Point Way Mooresville, NC. 28115

LOCATION Brawley Rd (E) off Eastchiller past 2ND Quail Hill entrance, to (L) of yellow trailer

SUBDIVISION Quail Hill BLOCK / SECTION 2 LOT 2 LOT AREA ~1.1 AC SITE CLASS. P DESIGN FLOW 360 L.T.A.R. .3

Septic Tank: 1000 Gallons; STB 5205 Date 3/12/95

Pump Tank: ____ Gallons; PT ____ Date ____

Pump Make: ____ Model ____ Serial No. ____

Nitrification Field: No Fields 1 Square Feet 1200 Linear Feet 400/

No Lines 4 Trench Width 36" Max Trench Bottom Depth 30" Gravel Depth 12"

☑ New System ☐ Repair System Type: I, (II), III, IV, V, VI

System Description: GRAV - CONV.

Repair System Description: SAME

Maintenance Agreement Required: ☐ Yes ☑ No

☑ House/Mod. Home ☐ Mobile Home ☐ Business ☐ Other D/W

No. Bedrooms 3 No. Bathrooms 2.5 No. Employees ____


☐ Slab ☑ Crawl Space ☐ Basement w/plumbing ☐ Basement wo/plumbing

Water Supply: ☑ Individual ☐ Community ☐ Public

Comments: Lines on slope contour as shown

Comments:

INITIAL SITE SKETCH

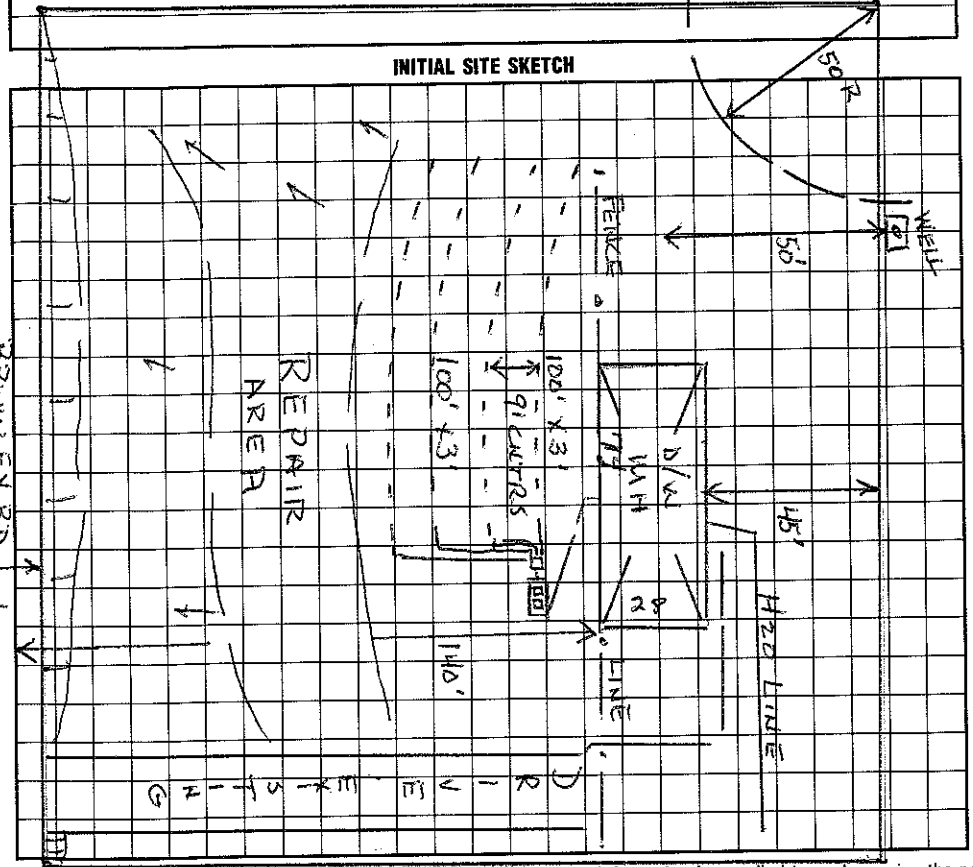

AS BUILT SKETCH

I understand that this permit can be suspended or revoked if any false information is supplied toward securing the permit/any unauthorized changes are made to the site/any unauthorized changes are made in the installation of the system. Improvement Permit is valid for 60 months from date of issuance.

Signed: Debra Bowers

Improvement Permit by: Wesley Sparks RS. date 3/14/95

Existing System Inspection by: ____ date ____

Installed by: Tim Arrington

Certificate of Completion by: Wesley Sparks RS. date 5/18/95

Operation Permit by: ____ date ____

HEALTH DEPT. COPY: WHITE INSPECTION COPY (FINAL): GREEN OWNER COPY (FINAL): YELLOW INSPECTION COPY (INITIAL): PINK OWNER COPY (INITIAL): GOLD