IREDELL COUNTY HEALTH DEPARTMENT

STATESVILLE 704-878-5305 MOORESVILLE 704-664-5281

IMPROVEMENT PERMIT / CERTIFICATE OF COMPLETION / OPERATION PERMIT / EXISTING SYSTEM INSPECTION

PROPERTY DESCRIPTION NO. REPAIR DATE 2/12/97 TAX MAP NO. REPAIR Watershed: ☐ Yes ☐ No

OWNER OR CONTRACTOR MELVIN STOGNER PHONE: Business 4676-47-3032 Home 399-6107

ADDRESS 1701 GROVEWOOD DR - CHARLOTTE 28208

LOCATION LINWOOD RD - FL BRUMLEY - TR QUAIL HILL - TR LAKEWOOD FIRST DR ON RT

SUBDIVISION QUAIL HILL BLOCK / SECTION ____ LOT 23? LOT AREA 3/4 AC SITE CLASS. PS DESIGN FLOW 450 GPD L.T.A.R. ____

Septic Tank: EXISTING Gallons; STB ____ Date ____

Pump Tank: ____ Gallons; PT ____ Date ____

Pump Make: ____ Model ____ Serial No. ____

Nitrification Field: No Fields 1 Square Feet 540 Linear Feet 180

No Lines 3@60' Trench Width 36" Max Trench Bottom Depth AS NEEDED Gravel Depth ____

☑ New System ☐ Repair System Type: I, II, (III) IV, V, VI

System Description: ____

Repair System Description: GRAVITY CONVENTIONAL

Maintenance Agreement Required: ☐ Yes ☑ No

☐ House/Mod. Home ☑ Mobile Home ☐ Business ☐ Other

No. Bedrooms 4 No. Bathrooms 3 No. Employees ____


☐ Slab ☑ Crawl Space ☐ Basement w/plumbing ☐ Basement wo/plumbing

Water Supply: ☑ Individual ☐ Community ☐ Public


Comments: 3 LINES AT 60' W/ NEW D-BOX & BULL RUN VALVE.

Comments:

INITIAL SITE SKETCH

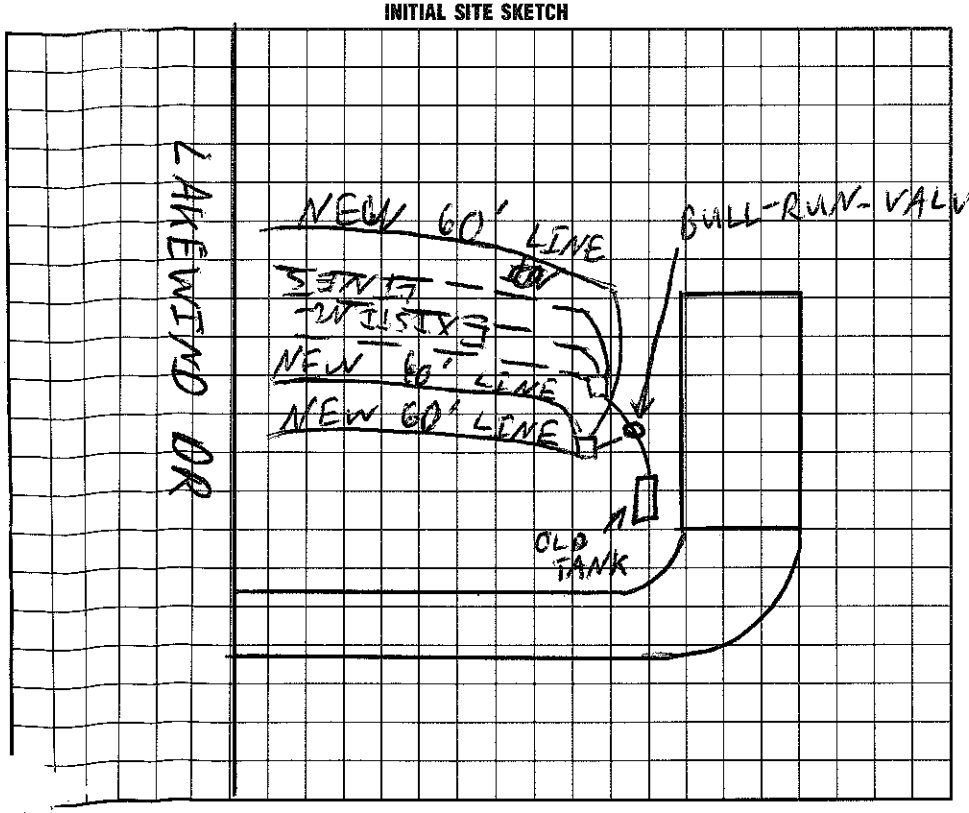

AS BUILT SKETCH

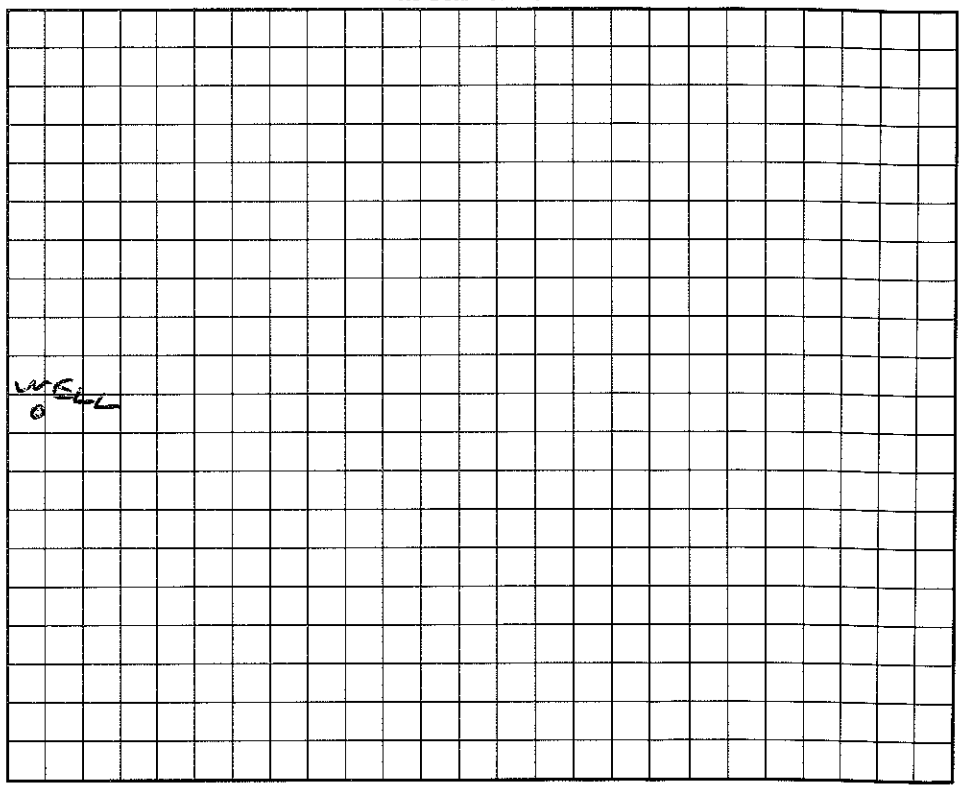

I understand that this permit can be suspended or revoked if any false information is supplied toward securing the permit/any unauthorized changes are made to the site/any unauthorized changes are made in the installation of the system. Improvement Permit is valid for 60 months from date of issuance.

Signed: Melvin L. Stogner

Improvement Permit by: C. Blackstock EHSI date 2/12/97

Existing System Inspection by: C. Blackstock EHSI date 2/12/97

Installed by: Levon Benton

Certificate of Completion by: ____ date ____

Operation Permit by: C. Blackstock date 2/25/97

HEALTH DEPT. COPY: WHITE INSPECTION COPY (FINAL): GREEN OWNER COPY (FINAL): YELLOW INSPECTION COPY (INITIAL): PINK OWNER COPY (INITIAL): GOLD