IREDELL COUNTY HEALTH DEPARTMENT

STATESVILLE 704-878-5305 MOORESVILLE 704-664-5281

IMPROVEMENT PERMIT / AUTHORIZATION TO CONSTRUCT / OPERATION PERMIT / EXISTING SYSTEM INSPECTION

PERMIT# 132491 PIN# 4626 47 50 69 DATE 12/2/05

OWNER OR APPLICANT Mike Stewart PHONE: Business _____ Home _____

ADDRESS 906 E. Center Ave Mooresville NC 28115

LOCATION Lynwood TL Bramley, TR Quail Hill, TR Lakewind, on Lt

SUBDIVISION Quail Hill BLOCK / SECTION _____ LOT 17 LOT AREA _____ SITE CLASS. _____ DESIGN FLOW 240 L.T.A.R. _____

Septic Tank: 1000 Gallons; STB _____ Date _____

Pump Tank: _____ Gallons; PT _____ Date _____

Pump Make: _____ Model _____ Serial No. _____

Nitrification Field: No Fields ___ Square Feet 220 Linear Feet 240

No Lines 3 Trench Width _____ Max Trench Bottom Depth _____ Gravel Depth 12" ☒ Gravity ☐ Pressure

☐ New System ☐ Repair ☐ Expansion System Type: I II III IV V VI

System Description: Gravity Conventional

Repair System Description: _____

Maintenance Agreement Required: ☐ Yes ☐ No

☐ House/Mod. Home ☒ Mobile Home ☐ Business ☐ Other _____

No. Bedrooms 3 No. Persons ___ No. Employees ___

Water Supply: ☒ Individual ☐ Public ☐ Community


☐ Slab ☐ Crawl Space ☐ Basement w/plumbing ☐ Basement wo/plumbing

Comments:/Conditions:

Comments:/Conditions:

INITIAL SITE SKETCH

AS BUILT SKETCH

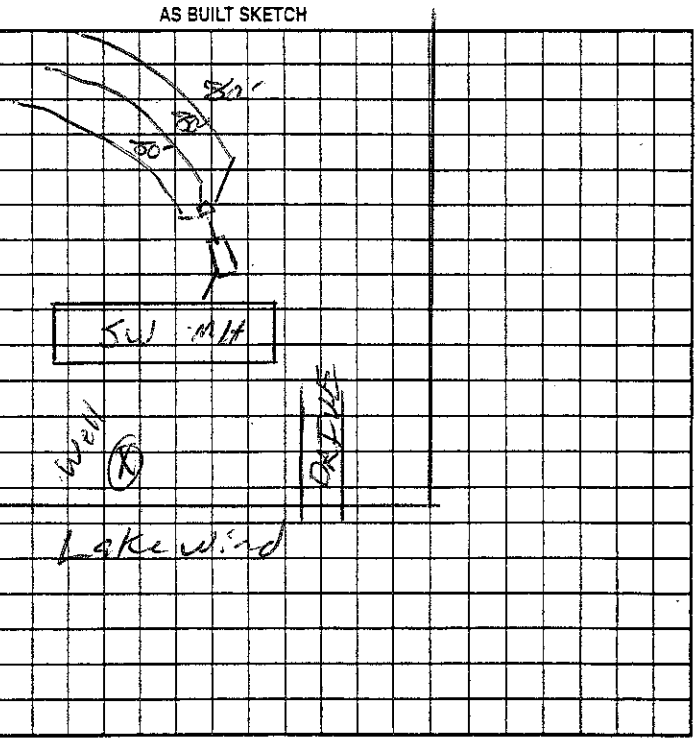

Permit can be suspended or revoked if any false information is supplied toward securing the permit/any unauthorized changes are made to the site/any unauthorized changes are made in the installation of the system. Improvement Permit with plat valid without expiration ☐ Improvement Permit with site plan valid for sixty months ☐ Authorization to Construct is valid for a period equal to that of Improvement Permit – not to exceed sixty months.

Signed: Mike Stewart date 12-2-05

Installed by: _____

Improvement Permit by: _____ date _____

Operation Permit by: _____ date _____

Authorization to Construct by: _____ date _____

Existing System Inspection by: RS date 12/2/05

HEALTH DEPT. COPY: WHITE OWNER COPY (FINAL): YELLOW OWNER COPY (INITIAL): PINK