ICHD - ENVIRONMENTAL HEALTH DIVISION

Statesville Office (704) 878-5305 Mooresville Office (704) 660-3625 PERMIT # AP 325525

SEPTIC: IMPROVEMENT PERMIT / AUTHORIZATION TO CONSTRUCT / OPERATION PERMIT / EXISTING SYSTEM

PIN # 4676-47-5289

APPLICANT/OWNER: Gina Baumgartner APPLICANT ADDRESS: 115 Lakewind Dr, Mooresville NC 28115

SITE ADDRESS: 115 Lakewind Dr Mooresville NC 28115 PHONE: 704-996-8429 ALT. PHONE

SITE DIRECTIONS: (N) Main → (R) Linwood → (L) Brumley → (R) Quail Hill → (R) Lakewind → lot @ corner MAP CONTROLLED: ☐ YES ☒ NO

SUBDIVISION: Quail Hill SECTION: 2 LOT # 16 LOT AREA: 1.277ac DESIGN FLOW: 360 gpd L.T.&.R.: EX/NG


Septic Tank	1000	(gal)	STB	760	Date	12-31-202'	☐ New System	☒ Repair	☐ Expansion	System Type: I II III IV V VI	
Pump Tank		(gal)	PT		Date		System Description:	EXISTING			
Pump Make			Model		Serial #		Repair System Description:	Tank Replacement			
# Nitrification Fields			# Lines		Linear Ft.		Maintenance Agreement Required:	☐ YES	☒ NO		
Trench Width			Trench Bottom Depth (Low side)	EXISTING			Gravel Depth	EX.	☒ GRAVITY	☐ PRESSURE	

☒ Residence	No. Bedrooms	3	Water Supply
☐ Business	No. Persons	6	☒ Private
☐ Other	No. Employees		☐ Public
☐ Slab	☒ Crawl Space		☐ Community
☐ Basement w/plumbing	☐ Basement w/o plumbing		

Comments / Conditions: Pump crush & fill existing tank. Replace distribution as needed.

NEW DROP BOXES INSTALLED

INITIAL SITE SKETCH

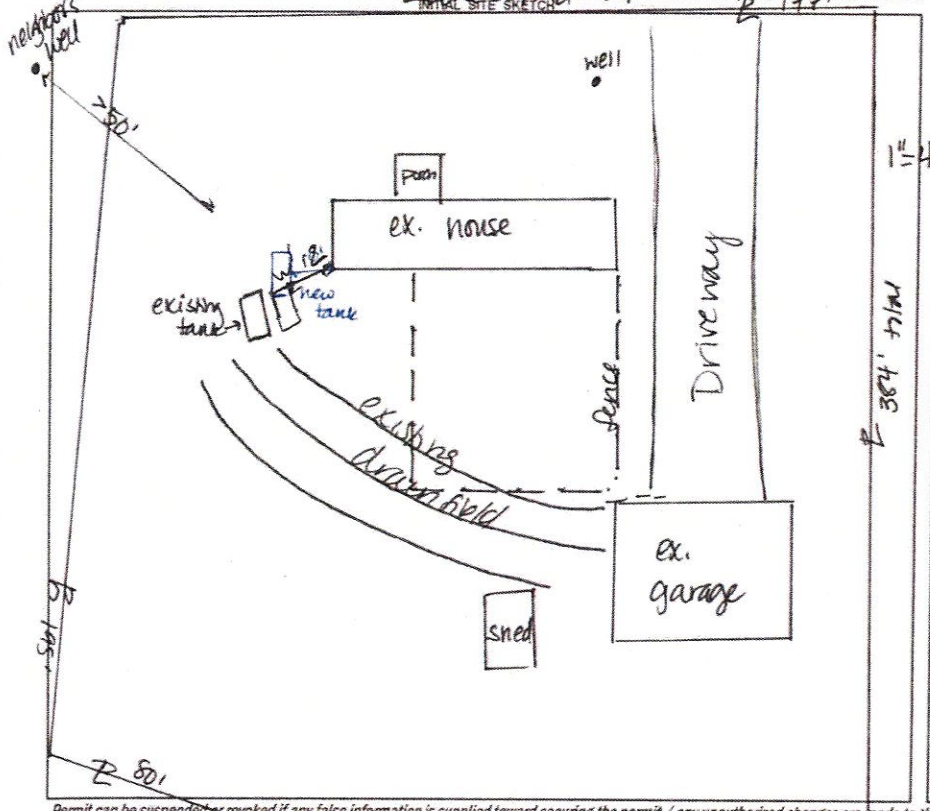

AS BUILT SKETCH

FOR SEPTIC FINAL INSPECTION CALL: 704-664-3703 between 8am-9am the day the inspection is needed. Be sure to speak with an inspector to confirm your time.

INSTALLED AS SHOWN

Permit can be suspended or revoked if any false information is supplied toward securing the permit / any unauthorized changes are made to the site / any unauthorized changes are made in the installation of the system. **CONTACT A LOCATOR SERVICE PRIOR TO ANY EXCAVATION**

☐ **IMPROVEMENT PERMIT** *with plat valid without expiration.* ☒ **IMPROVEMENT PERMIT** *with site plan valid for 60 mos.* ☒ **AUTHORIZATION TO CONSTRUCT** *valid for period equal to IMPROVEMENT PERMIT--not to exceed 60 mo.*

Owner / Applicant Signature: Gina Baumgartner Date: 2/17/22 Installed by: LENTZ WASTEWATER

IMPROVEMENT PERMIT by: D. Wieberg Date: 2/15/22 OPERATION PERMIT by: Bryant C. White Date: 3-4-2022

AUTHORIZATION TO CONSTRUCT by: D. Wieberg Date: 2/15/22 Existing System Inspected by: Date:

FOR SEPTIC FINAL INSPECTION: CALL 704-664-3703 between 8am-9am the day the inspection is needed.

ICHD – Environmental Health Division

Statesville Office (704) 878-5305 Mooresville Office (704) 660-3625 **PERMIT #** 312781


PRIVATE DRINKING WATER WELL PERMIT **PIN #** 4740-62-9839 Type of Permit (circle one): (New) Repair Abandonment

APPLICANT/OWNER NAME: Brittany Teague ADDRESS: 2631 Brodie Ct, Kannapolis NC 28083 PHONE: 704-402-9113

DIRECTIONS TO SITE: I-77N → exit 42 → (L) 21/115 → (L) Flowerhouse Loop → lot on corner of FHL & Clontz Hill

SITE ADDRESS: 310 Flowerhouse Loop. SUBDIVISION: N/A SECTION/LOT: N/A

Initial Site Sketch 1" = 40'

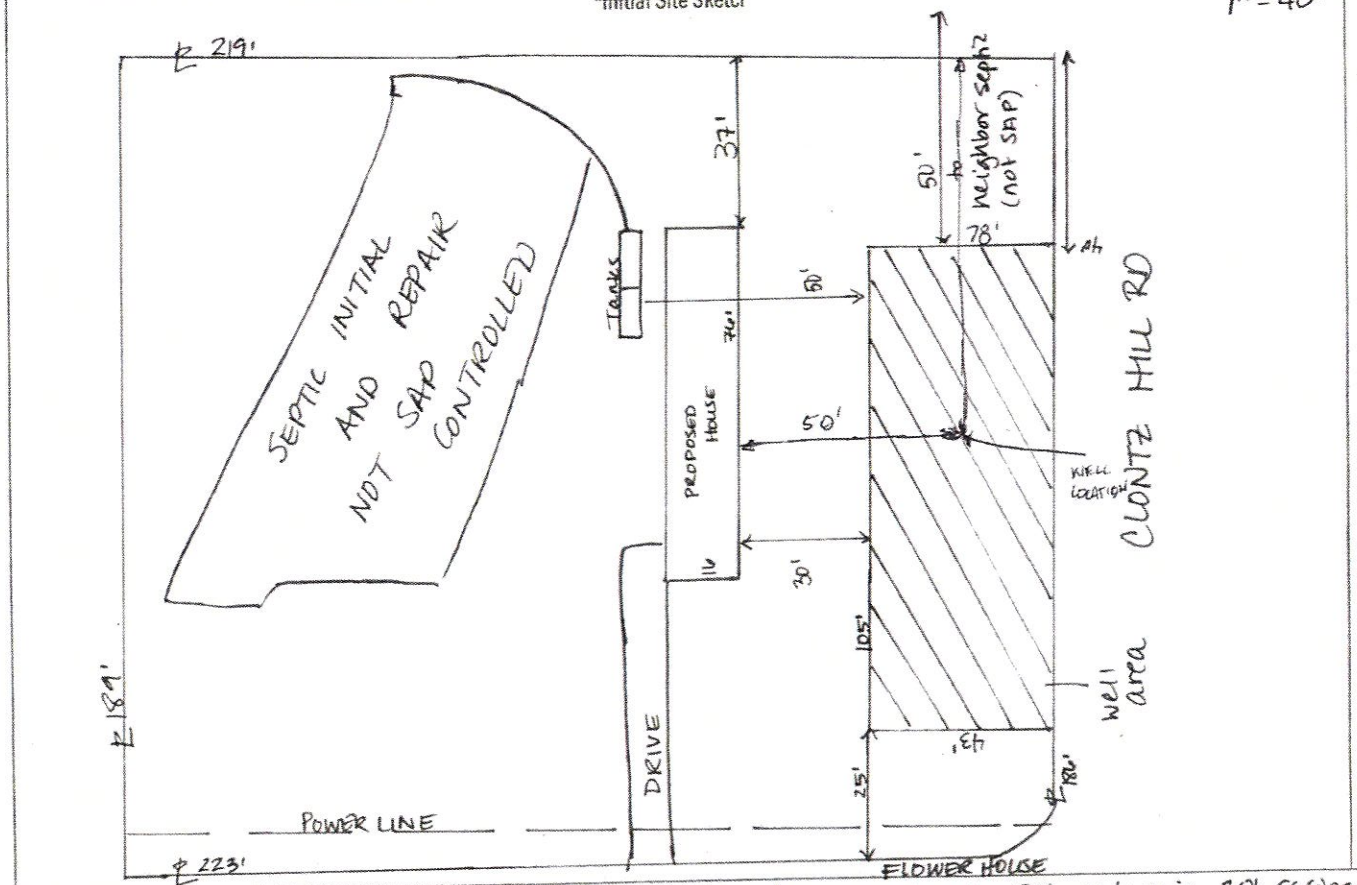

GROUTING RESULTS

Total Depth 265 FT

Depth of Casing 88 FT

Yield 10 GPM

Notes:

GROUTED 20FT W/ENVIRO PLUG

Well GPS Latitude: _____

Longitude: _____

PERMIT CONDITIONS/COMMENTS: Follow all NCAC 2C well rules - grout min 20', set min 20' casing. Stay 25 off all structures, including any porches, & 50' off all septic components. Locate tanks prior to drilling. No known contaminant release w/in 1000'.

WELL PERMIT ISSUED BY: D. WIEBERG DATE: 12/16/2020 (Permit is valid for 5 years from date issued. This permit may be revoked if it is determined there has been a material change in any fact or circumstance upon which the permit is issued. Actions of the employees of the Iredell County Health Department shall in no way be taken as a guarantee that this well will produce water of any particular quantity or quality or for any amount of time. Employees of the Iredell County Health Department assume no liability for any damages, either direct or consequential which may be caused by this well.)

Well Contractor: Mid-South CONTRACTOR CERT #: 2344-A GROUT INSPECTION BY: B. Hunt C. Wiles DATE: 3-4-2022

OR CERTIFICATION OF GROUT NOT WITNESSED BY DEPT: _____ DATE: _____ WELL HEAD INSPECTION BY: _____ DATE: _____

WELL HEAD INSPECTION (check when completed): GROUT TO GROUND SURFACE ☐ WELL CONTRACTOR ID PLATE ☐ PUMP INSTALLER ID PLATE ☐ SAMPLE PORT ☐

ACCESS PORT / VENT ☐ WELL SEAL ☐ WELL HEAD 12 INCHES / PITLESS ADAPTOR 8 INCHES ABOVE GRADE ☐

CERTIFICATE OF COMPLETION BY: _____ DATE: _____ WATER SAMPLES BY: _____ DATE: _____

Attachments: Form GW-1a (required except for abandonment) ☐ Form GW-30 ☐ Water Sample Results ☐ Plat ☐ CALL 704-664-3703 to schedule grout or well head inspections between 8-9am

E-MAILED 12/17 hm. DW

RECEIVED FEB 09 2022

APPLICATION MUST BE FILLED OUT COMPLETELY & BE LEGIBLE
OR IT WILL NOT BE PROCESSED

DW

Iredell County Health Department – Environmental Health Division

PAGE 1: *APPLICATION FORM* AP-325525

Repair Tank

Application For: ( ) New Well Permit ( ) Well Repair Permit ( ) Well Abandonment
( ) Septic Improvement Permit ( ) Authorization to Construct ( ) Existing System Inspection (X) Septic System Repair

THE ABOVE PERMIT DOCUMENTS WILL BECOME INVALID IF INFORMATION PROVIDED ON THIS APPLICATION IS FALSIFIED OR CHANGED, OR IF THE SITE IS ALTERED. THE IMPROVEMENT PERMIT IS VALID FOR EITHER 60 MONTHS OR WITHOUT EXPIRATION DEPENDING UPON DOCUMENTATION SUBMITTED. APPLICATION WITH SITE PLAN 60 MONTHS, APPLICATION WITH COMPLETE, SCALED PLAT WITHOUT EXPIRATION. SEE 15A NCAC 18A .1937(f) FOR DETAILS.

Page 2: *Site Plan Worksheet* form MUST accompany this application

The following optional attachments may also be submitted: ( ) Survey Plat, scaled no more than 1 inch = 60 feet
Place an (X) beside whichever is submitted if applicable ( ) Custom Site Plan, scaled no more than 1 inch = 60 feet

Applicant Information: (PRINT CLEARLY)

Applicant Name: Gina Baumgartner **Address:** 115 Lakewind Dr., Mooresville NC **Zip:** 28115
Applicant Email: ginasbaumgartner@gmail.com **Phone:** **Alt. Phone:** 704-996-8429
Owner Name: same **Address:** **Zip:**
Owner Email: **Phone:** **Alt. Phone:**

Property Information:

Street Address: 115 Lakewind Dr., Mooresville, NC 28115
Subdivision Name: Quail Hill **Section/Phase:** 2 **Lot Number:** 16
Driving Directions: Linwood → Bramley → turn R on Quail Hill → at "T" in road, prop. straight ahead – turn R on Lakewind (no sign) →

Site Development Information: *(check or complete ALL that apply*

( ) New Single Family Residence
( ) New Multi-Family Residence
( ) Accessory Building
( ) Bedroom(s) Addition
(X) Repair to failing septic system ✓ Tank ___ Drain lines Describe Problem: cracked wall in tank

Maximum Number of Bedrooms: 3
Maximum Number of Occupants:
( ) Swimming Pool
( ) Other Addition/Structure:

CHECK FOUNDATION TYPE
(✓) Crawl Space Foundation
( ) Concrete Slab Foundation
( ) Basement with Plumbing
( ) Basement without Plumbing

Non-Residential Site Development: Type of Business:
Square Footage of Building: Max. Number of Employees: Max. Number of Seats/Beds/Other:

Water Supply: ( ) Replacement Well – Reason:
( ) Multi-connection Well Number of Houses: Number of Persons:
( ) New Well (✓) Existing Well ( ) Community Well ( ) City Water ( ) Other Public Water

Desired Septic System Type: *(you may rank in order of preference)* Year existing system installed:
( ) No Preference ( ) Alternative ( ) Conventional ( ) Innovative ( ) Modified Conventional (✓) Other: tankonly

Please answer the following to the best of your ability:
( ) Yes (✓) No Does the site contain any jurisdictional wetlands?
( ) Yes (✓) No Is any non-domestic sewage (i.e. industrial) to be generated?
( ) Yes (✓) No Is the site subject to approval by any other public agency?

I have read this application and certify that the information provided herein is true, complete, and correct. Authorized county and state officials are granted right of entry to conduct necessary inspections to determine compliance with applicable laws and rules. I understand that I am solely responsible for the proper identification and labeling of all property lines and corners and making the site accessible so that a complete site evaluation can be performed.

Signature: Gina D. Baumgartner 2/9/22
Property owner or owner's legal representative signature (SIGNATURE REQUIRED) DATE

10552

IREDELL COUNTY HEALTH DEPARTMENT

(SEPTIC TANK) IMPROVEMENTS PERMIT AND CERTIFICATE OF COMPLETION
(Ground Absorption Sewage Disposal System – G. S. Chapter 130-Article 13C)

OWNER OR CONTRACTOR Clyde Cockman DATE Oct. 23, 89 PERMIT NO. IH 11-A-16

PHONE: Business _____ Home _____

LOCATION 150 TL 1153 (Brumley) TR 2nd entrance into Quail Hill stand S. R. No. _____

SUBDIVISION NAME Quail Hill LOT NO. 16 SECTION OR BLOCK NO. _____


House ( ) Mobile Home (✓) Business ( ) Other _____

No. Bedrooms 3 No. Bathrooms 2

Garbage Disposal Unit Yes ( ) No (✓)
Auto. Dishwasher Yes (✓) No ( )
Auto. Wash. Machine Yes (✓) No ( )
Site ~~Suitable~~ RS Yes (✓) No ( )
Lot Area 20000 sq ft

Character & Porosity of Soil Clay
Percolation Rate 2" 4
Topography 6-8%
Depth to Water Table 4'+
Rock or other impervious formations none obs.

_____ Basement with Plumbing _____ Basement without Plumbing _____ No Basement ✓

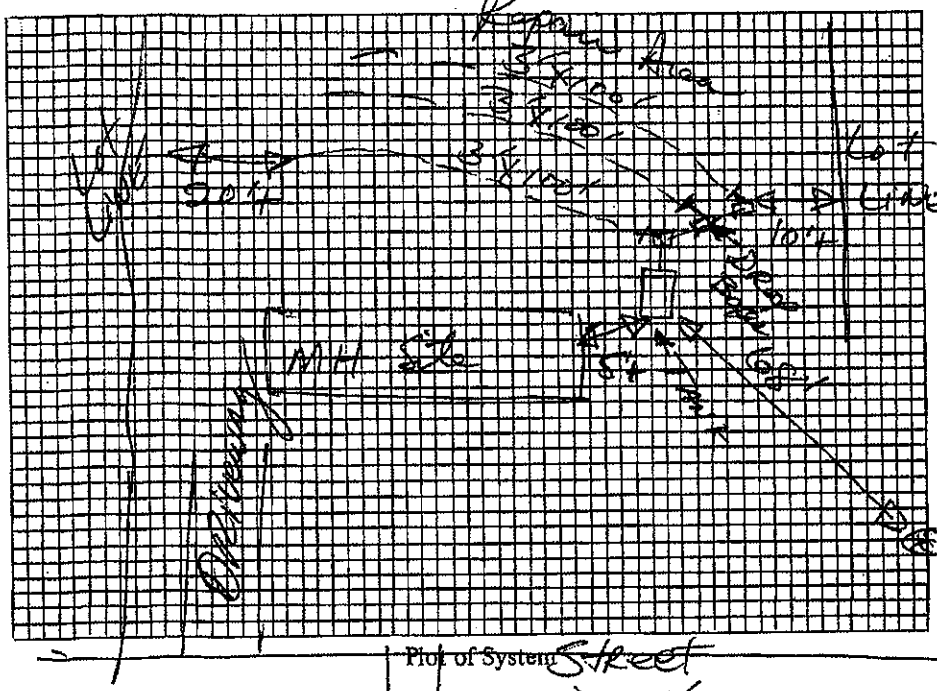

Size of Tank 1000 Gals.

Nitrification Field:
No. of Lines 3
Sq. Ft. 900 Linear Ft. 300
Depth of Stone in Lines 12"

Water Supply: Individual (✓) Public ( )
well on lot 15

Installed by Kenny Dellinger

I understand and agree to install septic tank system as specified on this Improvements Permit.

Signed: _____

Plot of System

IMPROVEMENTS PERMIT BY _____

COMMENTS: _____

CERTIFICATE OF COMPLETION BY _____ DATE 10-23-89

EXISTING SYSTEM CHECKED BY: _____ DATE _____


CONSTRUCTION MUST COMPLY WITH ALL OTHER APPLICABLE STATE AND LOCAL REGULATIONS.

Permit is VOID if any unauthorized changes are made in installation of system and/or if any false information is supplied in making Improvements Permit.

Health Dept. Copy: White Inspection Dept. Copy: Yellow Sanitarian's Copy: Pink Owner's Copy: Gold

IREDELL COUNTY HEALTH DEPARTMENT
ENVIRONMENTAL HEALTH DIVISION
PAGE 2: *SITE PLAN WORKSHEET*

SEE THE "SAMPLE SITE PLAN" BELOW. *INCOMPLETE SITE PLANS WILL BE RETURNED TO YOU FOR COMPLETION AND MAY RESULT IN A DELAY IN THE ISSUANCE OF YOUR SEPTIC SYSTEM PERMIT!!!*

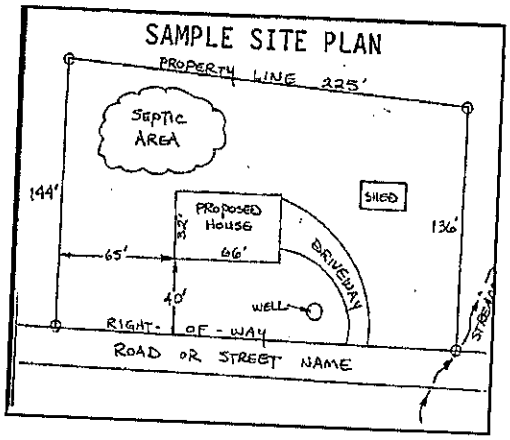

Place an (X) beside each item as you complete the site plan:


( ) **Property Line measurements are clearly identified**
( ) **All proposed structures are indicated**
( ) **Front and side setbacks from property line**
( ) **Preferred driveway location and well location**
( ) **Area you prefer your septic system to be placed**
( ) **North arrow, or other sufficient indicator of direction**

Circle N/A on the following if appropriate:

Location of septic systems and wells within 100' of your property	**N/A**
Location of easements and rights of ways on your property	**N/A**
Location of any designated wetlands on the property	**N/A**

USE THIS SPACE TO DRAW YOUR SITE PLAN

Show: proposed house or business footprint, wells, water lines, patios, pools and decks, and any other item that will occupy space on the site

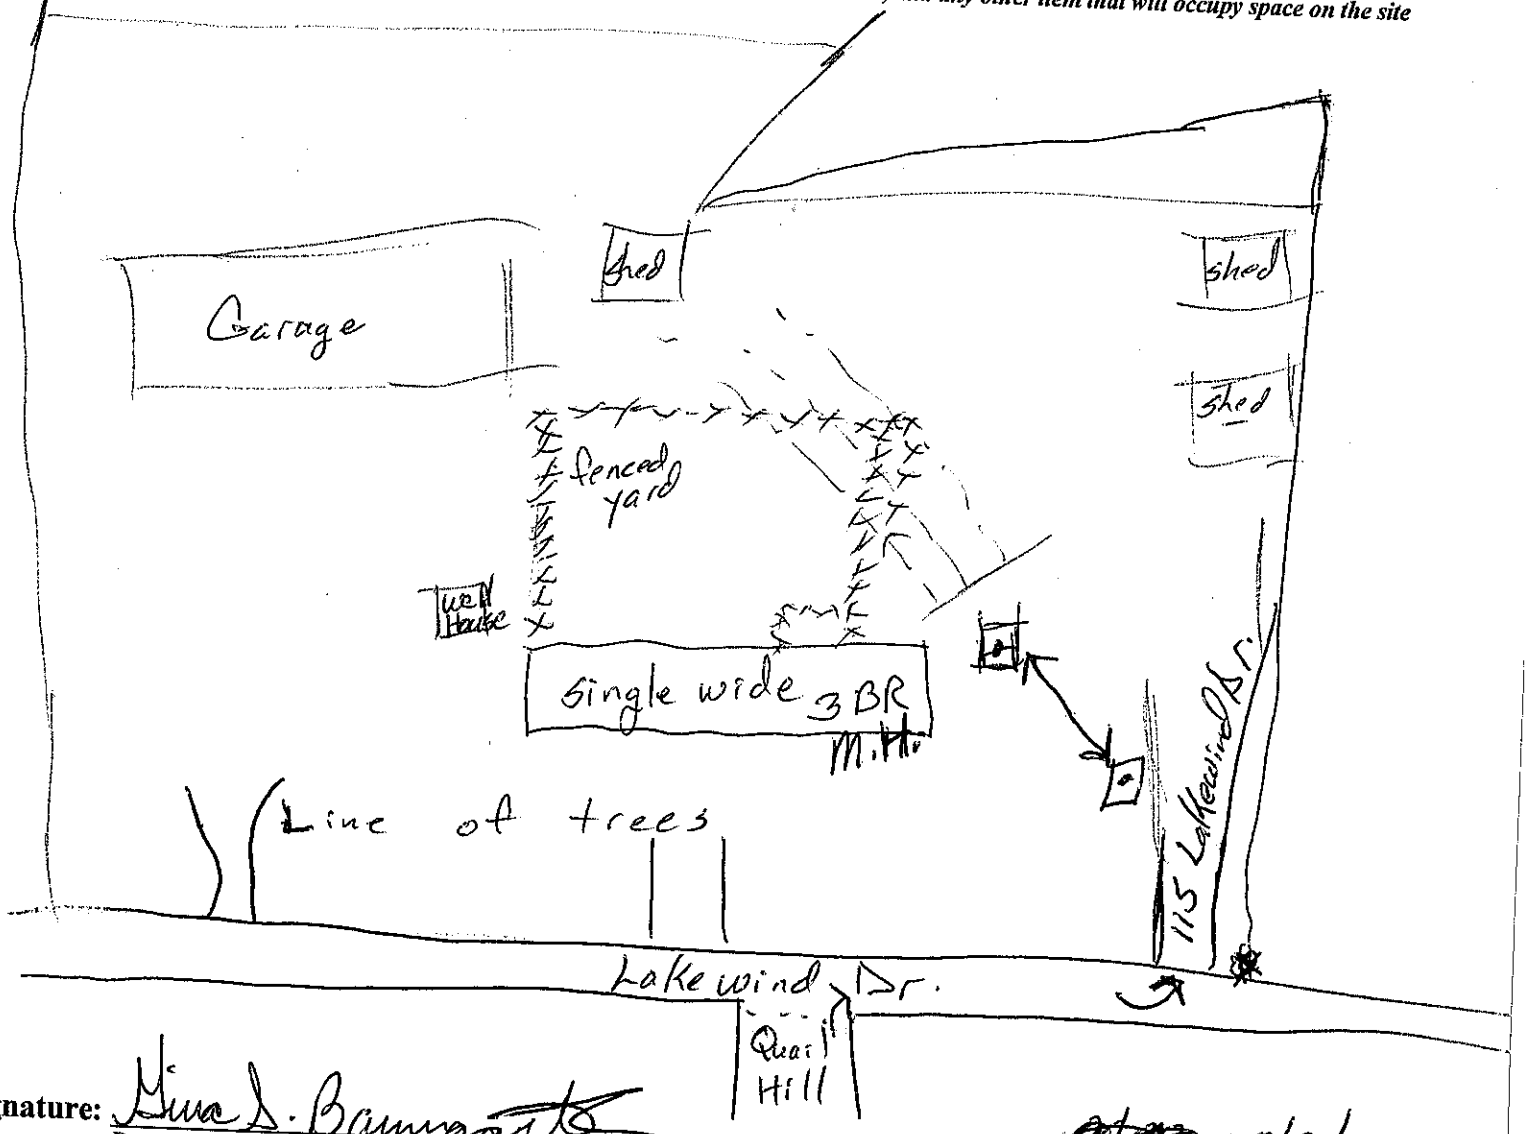

Signature: Lisa D. Bamgarner

Property owner or owner's legal representative signature (SIGNATURE REQUIRED)

2/9/22
DATE

Public Health
Prevent. Promote. Protect.
Iredell County Health Department

IREDELL COUNTY DEPARTMENT OF ENVIRONMENTAL HEALTH

Public Health
Prevent. Promote. Protect.
Iredell County Health Department

DOCUMENTATION TO AUTHORIZE AN OWNER'S LEGAL REPRESENTATIVE

(Check and sign only ONE of the options below)

☑ **1. * APPLICANT AND OWNER ARE THE SAME. *** (*Sign here*) Gina D. Baumgartner

Applications for permits require the "signature of the owner or owner's legal representative" (15A NCAC 18A .1937). If the owner does not sign the application himself or herself, they can submit any one of the following documents to designate their legal representative: *Power of Attorney; Real Estate Contract; Estate executor; Bankruptcy trustee; Court ordered guardianship*
In the absence of the above documentation, the property owner may provide the local health department with documentation that designates a legal representative. A property owner may:
Complete this form to document his or her legal representative, or provide his or her own form that contains the information in this form. If there are multiple property owners, then all property owners must sign the form that designates a legal representative.
By signing a form that designates a legal representative for purposes of 15A NCAC 18A .1937, the property owner authorizes that representative to act on their behalf in matters pertaining to the application and permitting process, including signing or receiving any application, document or permit. The owner retains full responsibility to meet all permit conditions specified by the local health department.

☐ **2.** I, _____, am the legal owner(s) of the property located at _____, identified as PIN (Parcel Identification Number)_____, located in Iredell County, North Carolina.

I do hereby authorize (**print legal representative/company name**) _____, _____, to act as an agent on my behalf in applying for/signing/obtaining any of the documents described below.

- Application for Improvement Permit (IP) / Authorization to Construct (AC)
- Improvement Permit (IP) / Authorization to Construct (AC)
- Application for soil-site evaluation (new/repair)
- Application/permit for private drinking water well/well abandonment
- Application for Compliance Inspection

I agree to abide by all decisions and/or conditions between the legal representative acting on my behalf and the Iredell County Department of Public Health, Environmental Health Division.

Gina D. Baumgartner _____ 2/9/22
Signature of Owner(s) Date

Mooresville - Environmental Health
Fax: 704-662-3239
610 E. Center Avenue, Mooresville, NC 28115

Statesville - Environmental Health
ronda.hart@co.iredell.nc.us
Fax: 704-871-3483
349 N. Center Street, Statesville, NC 28677

CONNECTGIS WEB HOSTING

North Carolina Iredell County

1:40 Feet



