IREDELL COUNTY HEALTH DEPARTMENT

STATESVILLE 704-878-5305 MOORESVILLE 704-664-5281

IMPROVEMENT PERMIT / AUTHORIZATION TO CONSTRUCT / OPERATION PERMIT / EXISTING SYSTEM INSPECTION

PERMIT# 07342 PIN# 4676475759 DATE 7/2/98

OWNER OR CONTRACTOR ELMON CAVES PHONE: Business Home

ADDRESS 242 TEMPLETON RD

LOCATION LINWOOD - TL BRUMLEY - TR QUAIL HILL - TL LAKEWIND ON RT AT END

SUBDIVISION QUAIL HILL BLOCK / SECTION 1 LOT 1 LOT AREA SITE CLASS. B5 DESIGN FLOW 360 L.T.A.R. .3

Septic Tank: 1000 Gallons; STB 744 Date 4/28/98
Pump Tank: Gallons; PT Date
Pump Make: Model Serial No.
Nitrification Field: No Fields 1 Square Feet 1200 Linear Feet 400
No Lines 7 Trench Width 36" Max Trench Bottom Depth 18" Gravel Depth 12"

☑ New System ☐ Repair System Type: I, II, III, IV, V, VI
System Description: GRAVITY CONVENTIONAL
Repair System Description: PUMP STATE
Maintenance Agreement Required: ☐ Yes ☑ No


☐ House/Mod. Home No. Bedrooms 3
☐ Mobile Home No. Bathrooms 2
☐ Business No. Employees
☐ Other
☐ Slab ☑ Crawl Space ☐ Basement w/plumbing ☐ Basement wo/plumbing

Water Supply: ☑ Individual ☐ Public ☐ Community

Comments:/Conditions:

Comments:/Conditions:

INITIAL SITE SKETCH NOT TO SCALE **AS BUILT SKETCH**

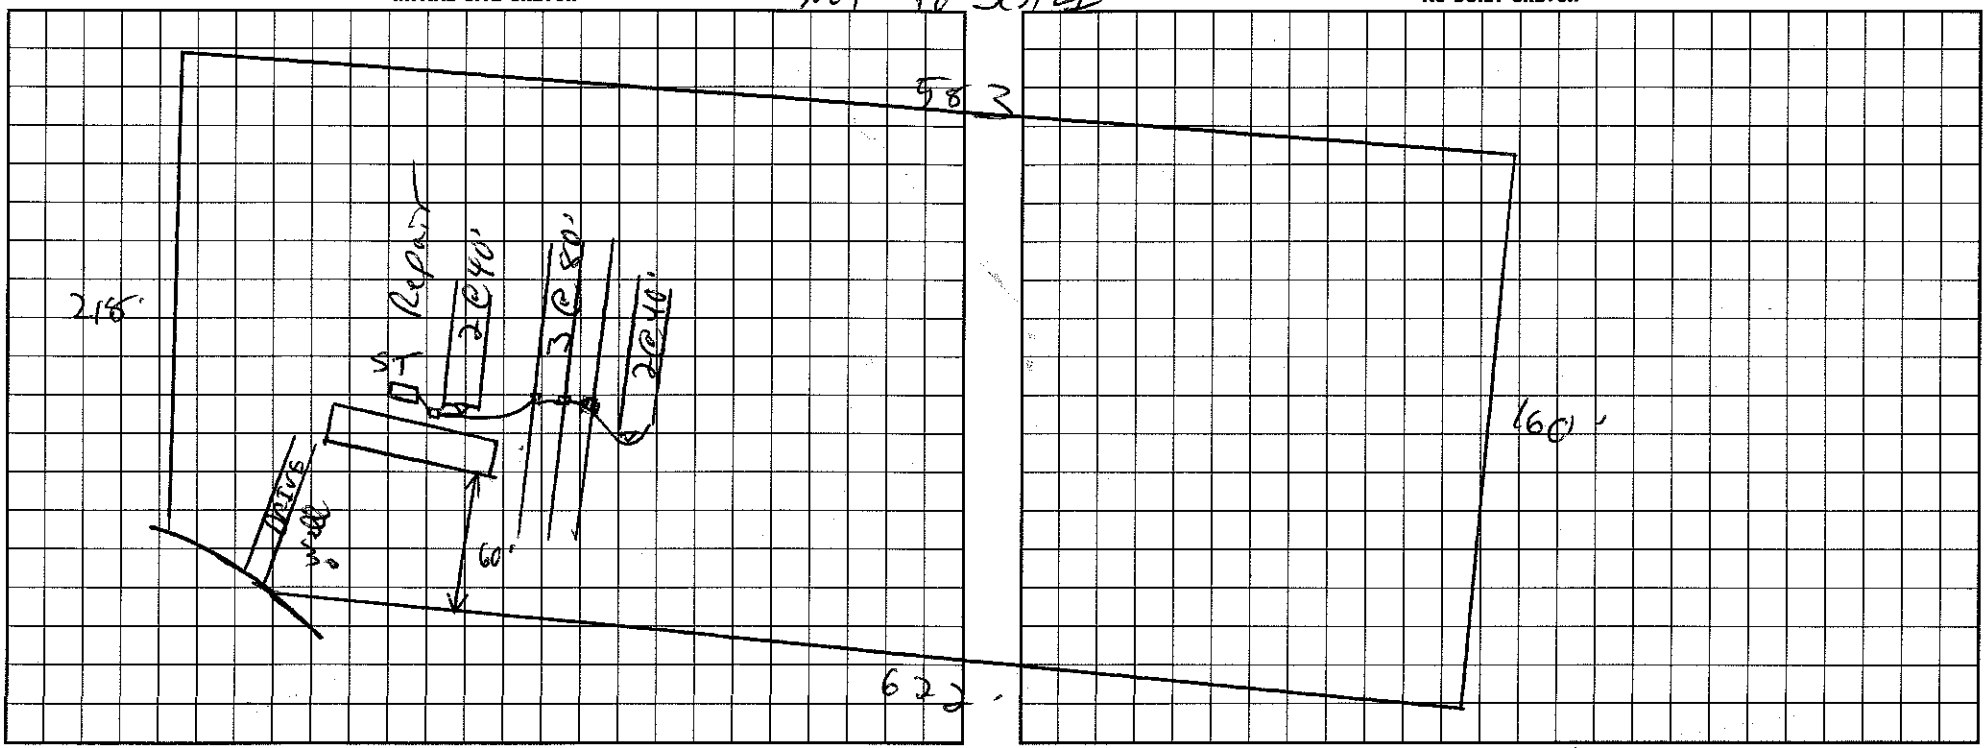

I understand that this permit can be suspended or revoked if any false information is supplied toward securing the permit/any unauthorized changes are made to the site/any unauthorized changes are made in the installation of the system. Improvement Permit with plat valid without expiration. Improvement Permit with site plan valid for sixty months. Authorization to Construct is valid for a period equal to that of Improvement Permit – not to exceed sixty months.

Signed: Elmon E. Caves date

Improvement Permit by: C. [signature] date 7/2/98

Authorization to Construct by: C. [signature] date 7/2/98

Installed by: COMMERCIAL SERVICES

Operation Permit by: C. [signature] RS date 7/15/98

Existing System Inspection by: date

HEALTH DEPT. COPY: WHITE INSPECTION COPY (FINAL): GREEN OWNER COPY (FINAL): YELLOW INSPECTION COPY (INITIAL): PINK OWNER COPY (INITIAL): GOLD