IREDELL COUNTY HEALTH DEPARTMENT

STATESVILLE 704-878-5305 MOORESVILLE 704-664-5281

IMPROVEMENT PERMIT / AUTHORIZATION TO CONSTRUCT / OPERATION PERMIT / EXISTING SYSTEM INSPECTIO

PERMIT# 146092 PIN# 4676536556 DATE 11-19-07

OWNER OR AF Calder Custom Homes PHONE: Business 704 400-2632 Home

ADDRESS 128 Walden Dr Mooresville NC 28115

LOCATION Main St TR Linwood Rd TL Tester TR Walden Ridge on right

SUBDIVISION Walden Ridge BLOCK / SECTION LOT 67 LOT AREA 1.03 Acre SITE CLASS. PS DESIGN FLOW 480 gpd L.T.A.R. .3

Septic Tank: 1000 Gallons; STB 312 Date 8-11-08

Pump Tank: Gallons; PT Date

Pump Make: Model Serial No.

Nitrification Field: No Fields 1 Square Feet 1200' Linear Feet 400'

No Lines 3@133' Trench Width 36" Max Trench Bottom Depth 36 Gravel Depth N/A

[X] New System [ ] Repair [ ] Expansion System Type: I II III IV V VI

System Description: Gravity - 25% Reduction

Repair System Description: Gravity - 25-50% Reduction

Maintenance Agreement Required: [ ] Yes [X] No

[X] House/Mod. Home [ ] Mobile Home [ ] Business [ ] Other

No. Bedrooms 4 No. Persons No. Employees


Water Suppl [X] Individual [ ] Public [ ] Communi

[X] Gravity [X] Pressure [ ] Slab [X] Crawl Space [ ] Basement w/plumbing [ ] Basement wo/plumbi

Comments/Conditions: Scale 1:50

Comments/Conditions: Keep well at least 50ft from any Septic System.

INITIAL SITE SKETCH

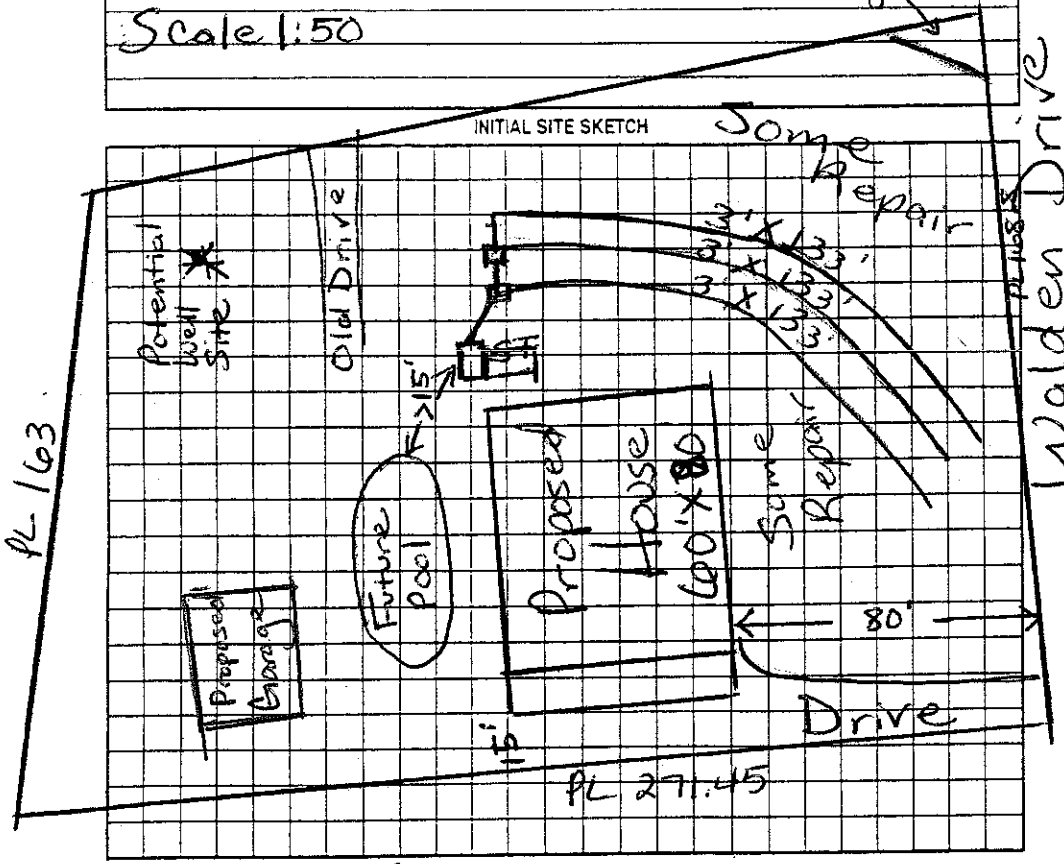

AS BUILT SKETCH

Installed Quick 4 As Drawn

The proposed / existing Garage (Detached) addition does not appear to impact the existing septic system.

**NOTE: Maria H. Dolson R.S.

Date: 5/6/09

ICHD-Environmental Health Division

Permit can be suspended or revoked if any false information is supplied toward securing the permit/any unauthorized changes are made to the site/any unauthorized changes are made in the installation of the system. Improvem

Permit with plat valid without expiration [ ] Improvement Permit with site plan valid for sixty months [ ] Authorization to Construct is valid for a period equal to that of Improvement Permit – not to exceed sixty mon

Signed: [signature] date 11/29/07 Installed by: Water Mgmt RS

Improvement Permit by: Maria H. Dolson RS date 11/19/07 Operation Permit by: Maria H. Dolson date 10/24/0

Authorization to Construct by: Anthony Cabe date 5/12/08 Existing System Inspection by: date

HEALTH DEPT. COPY: WHITE OWNER COPY (FINAL): YELLOW OWNER COPY (INITIAL): PINK