IREDELL COUNTY HEALTH DEPARTMENT

STATESVILLE 704-878-5305 MOORESVILLE 704-664-5281

IMPROVEMENT PERMIT / AUTHORIZATION TO CONSTRUCT / OPERATION PERMIT / EXISTING SYSTEM INSPECTION

DATE 3/13/07

PERMIT# 140748 PIN# 4676537762.002 4676-53-~~7462~~ 7462

OWNER OR APPLICANT ~~Lot 6 Williamson~~ Mid-Atlantic Builders PHONE: Business 704 663 2815 Home

ADDRESS ~~Lot 6 Williamson Rd~~ Mooresville PO Box 3792 Mooresville NC 28115

LOCATION Main St. (N) RT Linwood, LT Tecter, RT on Walden, 2nd Lot on Right

SUBDIVISION Walden Ridge BLOCK / SECTION LOT 2 LOT AREA ~1.00 Acre SITE CLASS. PS DESIGN FLOW 480 L.T.A.R. 3

Septic Tank: 1000 Gallons: STB 1012 Date 4-17-01

Pump Tank: Gallons: PT Date

Pump Make: Model Serial No.

Nitrification Field: No Fields Square Feet 1200 Linear Feet 400

No Lines 4@100' Trench Width 36" Max Trench Bottom Depth 36"

☒ New System ☐ Repair ☐ Expansion System Type: I II III IV V VI

System Description: Gravity - 25% Red

Repair System Description: Same

Maintenance Agreement Required: ☐ Yes ☐ No

☐ Gravity ☐ Pressure ☐ Slab ☒ Crawl Space ☐ Basement w/plumbing ☐ Basement wo/plumbing

Gravel Depth N/A

☒ House/Mod. Home ☐ Mobile Home ☐ Business ☐ Other


No. Bedrooms 4 No. Persons No. Employees

Water Supply: ☒ Individual ☐ Public ☐ Community


Comments/Conditions: Pool to be at minimum 15' from tanks, lines, supply etc

Comments/Conditions: Installed Quick 4 w/ Built In Drop boxes

INITIAL SITE SKETCH

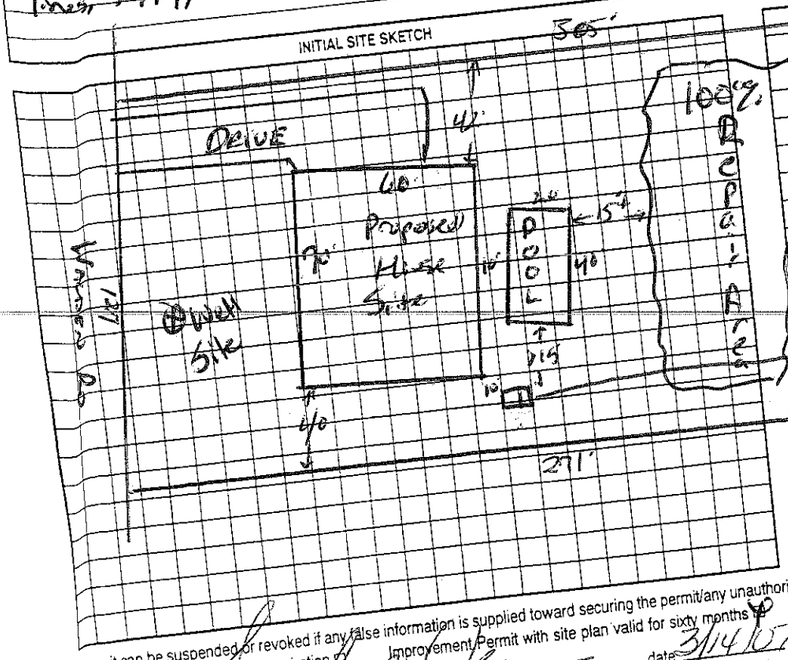

AS BUILT SKETCH

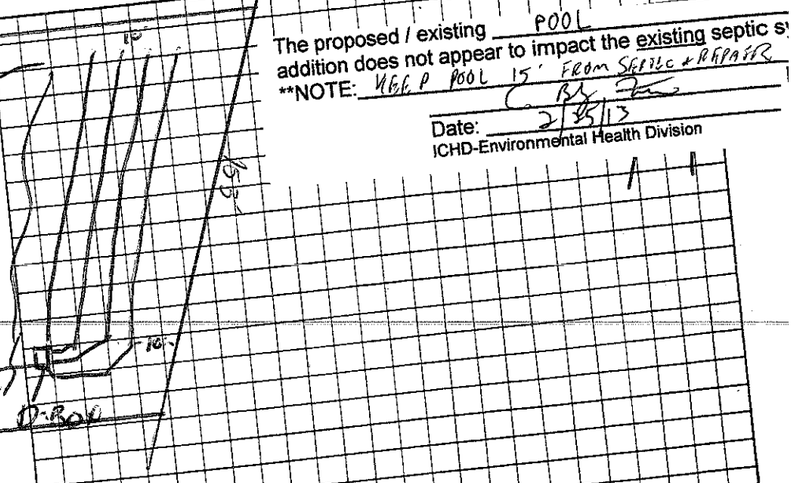

The proposed / existing POOL addition does not appear to impact the existing septic s

**NOTE: Need P POOL 15' From Septic & Repairs

Date: 2/15/13

ICHD-Environmental Health Division

Permit can be suspended or revoked if any false information is supplied toward securing the permit/any unauthorized changes are made to the site/any unauthorized changes are made in the installation of the system. Improvement Permit with plat valid without expiration. Improvement Permit with site plan valid for sixty months. Authorization to Construct is valid for a period ~~equal to that of~~ Improvement Permit – not to exceed sixty months.

Signed: date 3/14/07 Installed by: Craig Thompson RS date 10/24

Improvement Permit by: date 3/14/07 Operation Permit by: date

Authorization to Construct by: date 3-30-07 Existing System Inspection by: date

HEALTH DEPT. COPY: WHITE OWNER COPY (FINAL): YELLOW OWNER COPY (INITIAL): PINK