IREDELL COUNTY HEALTH DEPARTMENT

STATESV[illegible] 704-878-5305 MOORESVILLE 704-664-5281

IMPROVEMENT PERMIT / AUTHORIZATION TO CONSTRUCT / OPERATION PERMIT / EXISTING SYSTEM INSPECTION

PERMIT# 140748 PIN# 4676537762.002 4676-53-7482 DATE 3/13/07

OWNER OR APPLICANT ~~[illegible]~~ Mid-Atlantic Builders PHONE: Business [illegible] Home [illegible]

ADDRESS 104 E Williamson Rd Mooresville 28115 PO Box 3792 Mooresville NC 28115

LOCATION Main St. (N) RT on Linwood, LT Tecter, RT on Walden, 2nd Lot on Right

SUBDIVISION Walden Ridge BLOCK / SECTION [illegible] LOT 2 LOT AREA ~1.00 Acre SITE CLASS. PS DESIGN FLOW 480 L.T.A.R. 3

Septic Tank: 1000 Gallons; STB 1012 Date 4-17-01

Pump Tank: [illegible] Gallons; PT [illegible] Date [illegible]

Pump Make: [illegible] Model [illegible] Serial No. [illegible]

Nitrification Field: No Fields [illegible] Square Feet 1200 Linear Feet 400

No Lines 4@100' Trench Width 36" Max Trench Bottom Depth 56" Gravel Depth N/A ☐ Gravity ☐ Pressure

☒ New System ☐ Repair ☐ Expansion System Type: I II III IV V VI

System Description: Gravity - 25% Red

Repair System Description: Same

Maintenance Agreement Required: ☐ Yes ☐ No

☒ House/Mod. Home ☐ Mobile Home ☐ Business ☐ Other

No. Bedrooms 4 No. Persons [illegible] No. Employees [illegible]


Water Supply: ☒ Individual ☐ Public ☐ Community

☐ Slab ☒ Crawl Space ☐ Basement w/plumbing ☐ Basement wo/plumbing


Comments:/Conditions: Pool to be at minimum 15' from tanks, lines, supply, etc

Comments:/Conditions: Installed Quick 4 w/ Built In Drop boxes

INITIAL SITE SKETCH

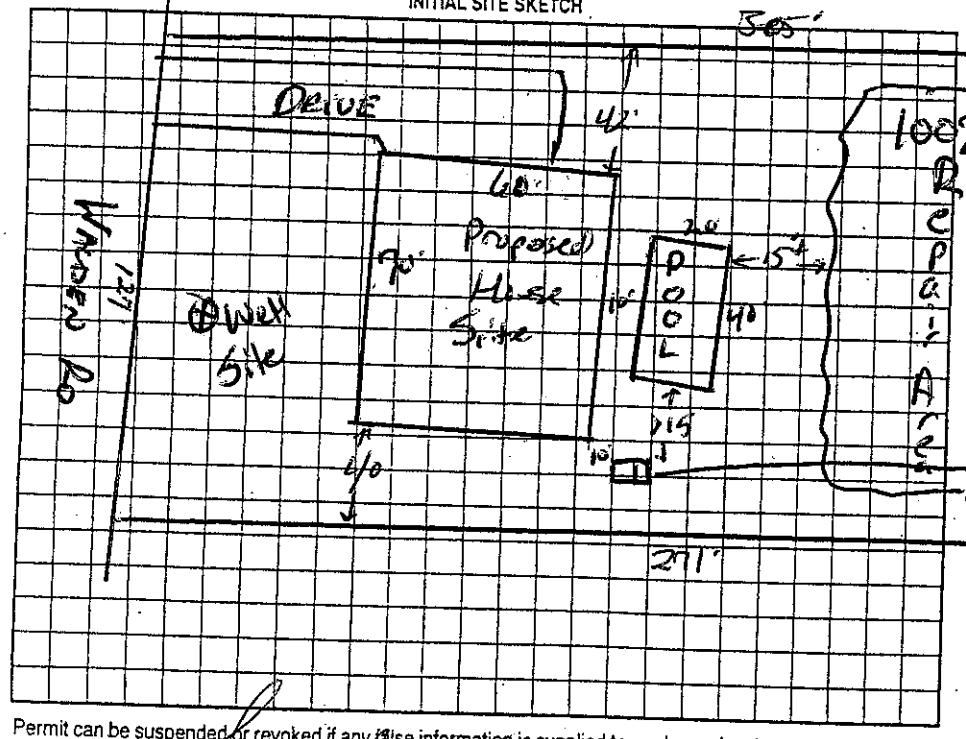

AS BUILT SKETCH

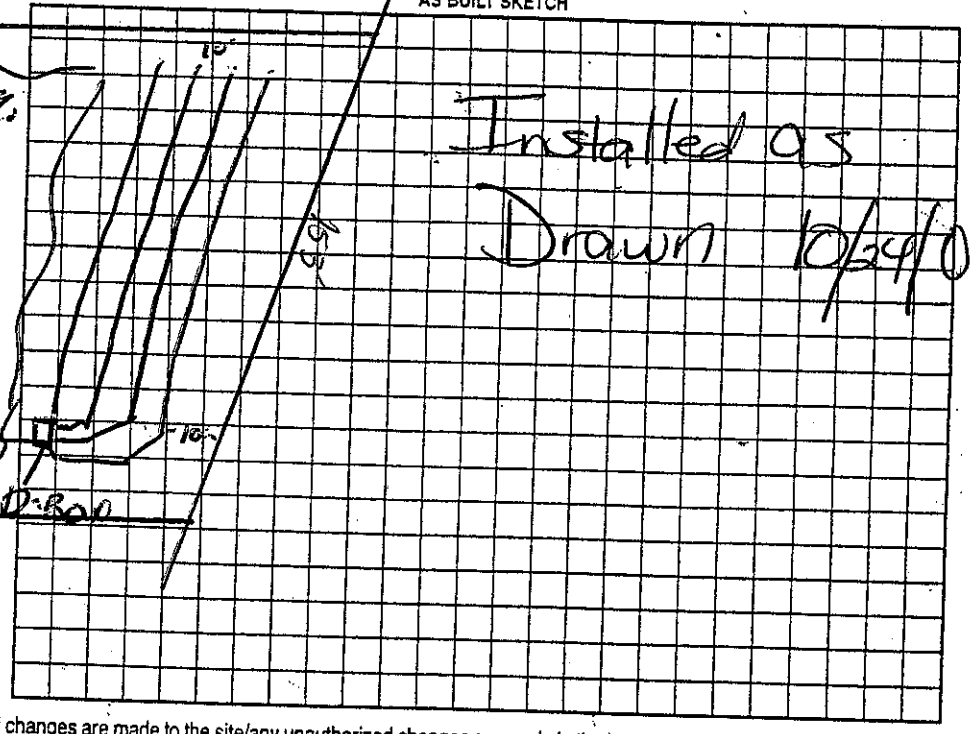

Installed as Drawn 10/24/07

Permit can be suspended or revoked if any false information is supplied toward securing the permit/any unauthorized changes are made to the site/any unauthorized changes are made in the installation of the system. Improvement Permit with plat valid without expiration ☐ Improvement Permit with site plan valid for sixty months ☒ Authorization to Construct is valid for a period ~~equal to that of~~ Improvement Permit – not to exceed sixty months.

Signed: [signature] date 3/14/07

Improvement Permit by: [signature] date 3/14/07

Authorization to Construct by: [signature] date 5-30-07

Installed by: Craig Thomson RS

Operation Permit by: Maintenance Dobson date 10/24/07

Existing System Inspection by: [illegible] date [illegible]

HEALTH DEPT. COPY: WHITE OWNER COPY (FINAL): YELLOW OWNER COPY (INITIAL): PINK