Site Address: 120 Walden Drive

IREDELL COUNTY HEALTH DEPARTMENT

STATESVILLE 704-878-5305 MOORESVILLE 704-664-5281

IMPROVEMENT PERMIT / AUTHORIZATION TO CONSTRUCT / OPERATION PERMIT / EXISTING SYSTEM INSPECTION

PERMIT# ~~13563~~ 207890 PIN# 4676 53 8258 DATE April 17, 2006

OWNER OR APPLICANT Iredell Group LLC PHONE: Business 704-344-5944 Home

ADDRESS 109-C Williamson Rd, Mooresville, N.C. 28117

LOCATION Linwood Road (S) TR Teeter Rd. TR Walden Drive 2nd Lot on Right

SUBDIVISION Walden Ridge BLOCK / SECTION LOT 3 LOT AREA 1.135 Ac SITE CLASS. PS DESIGN FLOW 460gpd L.T.A.R. 0.3

Septic Tank: 1000 Gallons; STB 825 Date 10/20/14
Pump Tank: Gallons; PT Date
Pump Make: Model Serial No.
Nitrification Field: No Fields 1 Square Feet 1200 Linear Feet 400
No Lines 4 Trench Width 36" Max Trench Bottom Depth 36"

☒ New System ☐ Repair ☐ Expansion System Type: I II III IV V VI
System Description: Gravity 25% Reduction
Repair System Description: Gravity/pump 25% Reduction
Maintenance Agreement Required: ☐ Yes ☒ No

☒ House/Mod. Home ☐ Mobile Home ☐ Business ☐ Other
No. Bedrooms 4 No. Persons No. Employees

Water Supply: ☒ Individual ☐ Public ☐ Community

Gravel Depth N/A ☒ Gravity ☐ Pressure ☐ Slab ☒ Crawl Space ☐ Basement w/plumbing ☐ Basement wo/plumbing

Comments:/Conditions:

Comments:/Conditions:

INITIAL SITE SKETCH

SEE Plan from Rollins Soil & Env. Services

AS BUILT SKETCH

INSTALLED AS DRAWN BY BUILK & CHAMBERS


Permit can be suspended or revoked if any false information is supplied toward securing the permit/any unauthorized changes are made to the site/any unauthorized changes are made in the installation of the system. Improvement Permit with plat valid without expiration ☐ Improvement Permit with site plan valid for sixty months ☒ Authorization to Construct is valid for a period equal to that of Improvement Permit – not to exceed sixty months.

Signed: date 4-24-06 Installed by: Rowan Septic

Improvement Permit by: date 4-17-06 Operation Permit by: APPROVED APR 14 2015

Authorization to Construct by: APPROVED JAN 15 2015 date Existing System Inspection by: date

HEALTH DEPT. COPY: WHITE OWNER COPY (FINAL): YELLOW OWNER COPY (INITIAL): PINK

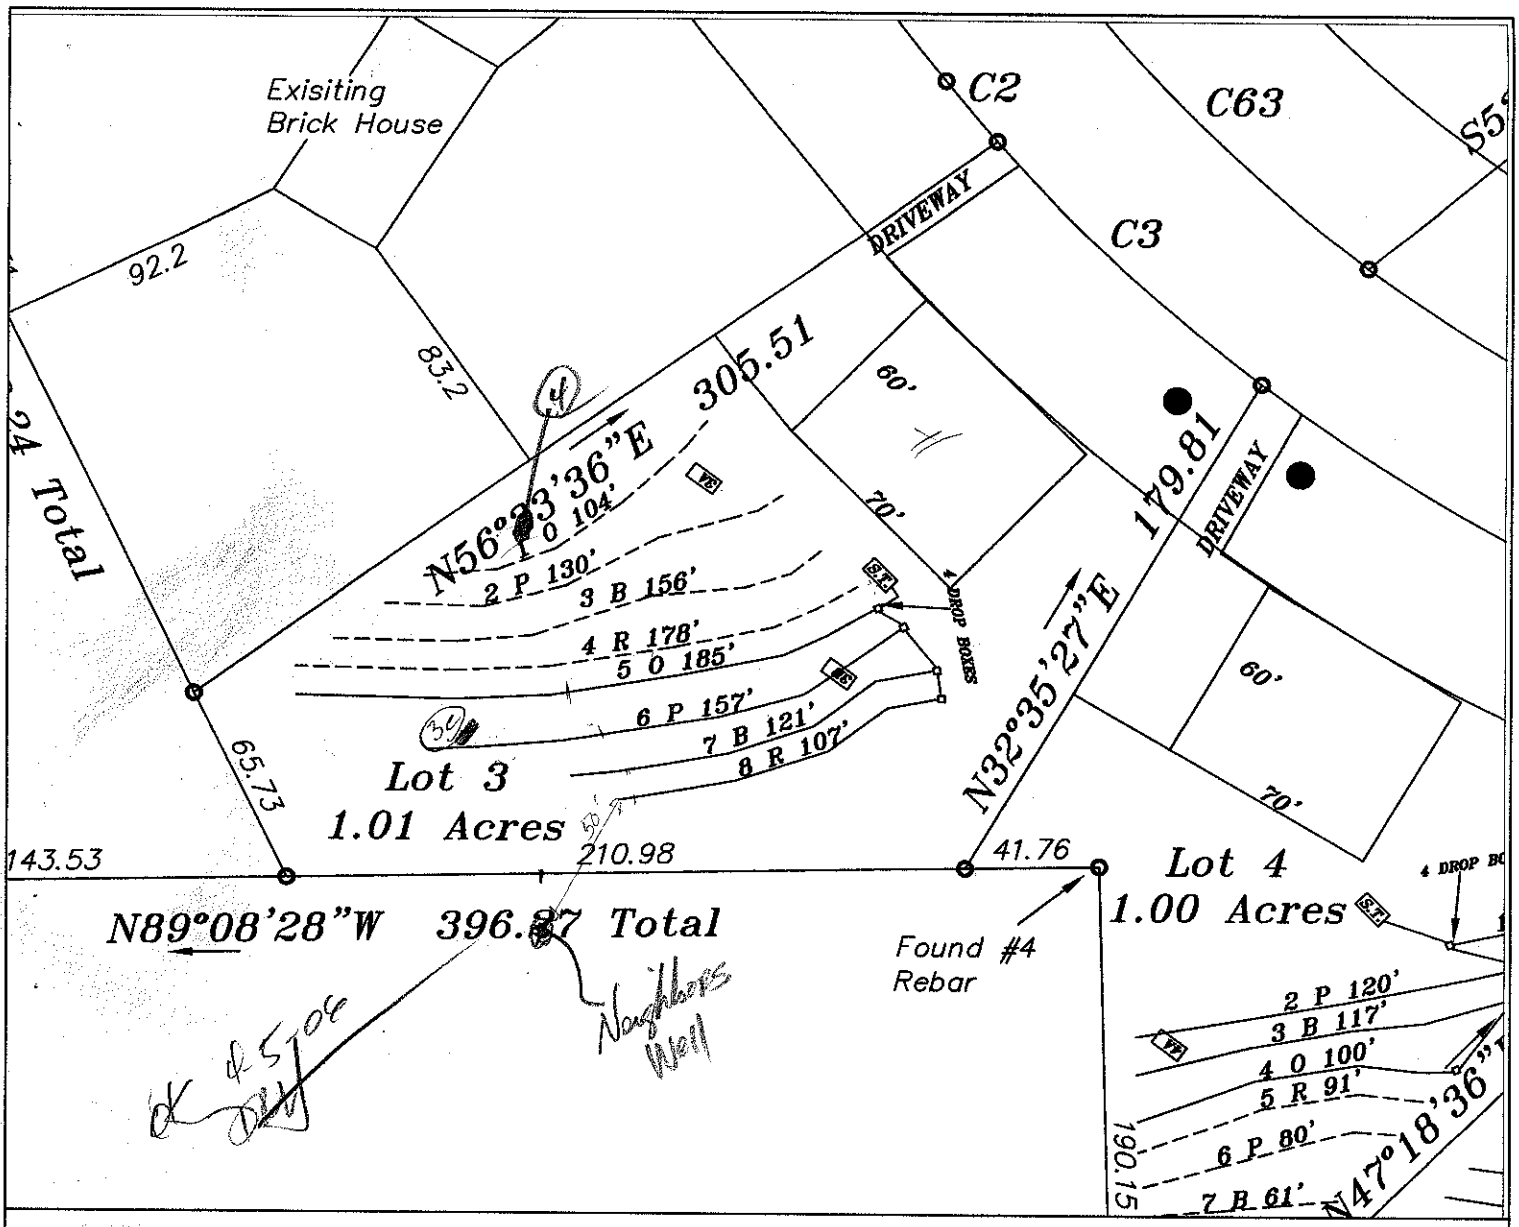

LEGEND

- Areas contain soils with 24 inches or more of useable material and have potential for conventional, modified conventional and low-pressure pipe (lpp) septic systems.
- Unsuitable areas.
- System lines.
- Repair lines.
- Temporary Bench Mark (TBM)
- Well Location.

GRAPHIC SCALE
1" = 60'

60 0 60 120

FOR PRELIMINARY PLANNING PURPOSES ONLY. ALL LOTS WILL REQUIRE FINAL APPROVAL BY THE COUNTY HEALTH DEPARTMENT ON A LOT BY LOT BASIS. THIS MAP SHOULD BY USED AS A GENERAL GUIDE, SOME ADJUSTMENTS WILL BE NECESSARY IN THE FIELD DUE TO SOIL VARIABILITY AND COMPLEX TOPOGRAPHIC FEATURES. THIS MAP ONLY REFLECTS EXISTING SOIL SUITABILITY FOR ON-SITE SEPTIC TANK SYSTEMS.

PLEASE REFER TO ATTACHED SOIL REPORT FOR ADDITIONAL SITE SPECIFIC INFORMATION

ROLLANS SOIL & ENVIRONMENTAL SERVICES
2120 GRAHAM ROAD
MOUNT ULLA, NC 28125
PHONE/FAX: (704) 278 - 0989
ASHLEY ROLLANS, NC LICENSED SOIL SCIENTIST
MOBILE: (704) 746 - 5046
EMAIL: ROLLANSFORTCJ@AOL.COM

MAP TITLE: SITE PLAN & DRAINFIELD AREAS

PROJECT NAME: IREDELL GROUP LLC/WALDEN RIDGE SUBDIVISION

LOCATION/DATE: TEETER ROAD IREDELL COUNTY, NORTH CAROLINA DECEMBER 2005

JOB # : 01-1069
FILE: C:\JOBS\01-1069
PROJECT MGR.: CBF
FIELD WORK: CBF AND AP
DRAWN BY: CBP AND AP