IREDELL COUNTY HEALTH DEPARTMENT

STATESVILLE 704-878-5305 MOORESVILLE 704-664-5281

IMPROVEMENT PERMIT / AUTHORIZATION TO CONSTRUCT / OPERATION PERMIT / EXISTING SYSTEM INSPECTION

PERMIT# 103161 20 PIN# 4676 59 9048 DATE 11/1/01

OWNER OR CONTRACTOR Marilyn Martin PHONE: Business Home 704-892-8235

ADDRESS 426 Brumley Rd. Mooresville, NC. 28115

LOCATION N Main TR Linwood Rd. (L) on Brumley Rd. x creek on (L) # 426

SUBDIVISION No BLOCK / SECTION LOT LOT AREA ~2.01 AC SITE CLASS. PS DESIGN FLOW 360 L.T.A.R.

Septic Tank: EXISTING Gallons; STB Date

Pump Tank: Gallons; PT Date

Pump Make: Model Serial No.

Nitrification Field: No Fields X Square Feet Linear Feet 252

No Lines Trench Width EXISTING SYSTEM Max Trench Bottom Depth Gravel Depth

☐ New System ☐ Repair System Type: I (II) III, IV, V, VI

System Description: EXISTING SYSTEM

Repair System Description:

Maintenance Agreement Required: ☐ Yes ☐ No

☒ House/Mod. Home No. Bedrooms 3

☐ Mobile Home No. Bathrooms 3

☐ Business No. Employees

☐ Other

☐ Slab ☒ Crawl Space ☐ Basement w/plumbing ☐ Basement wo/plumbing

Water Supply: ☒ Individual ☐ Public ☐ Community


Comments:/Conditions:

INITIAL SITE SKETCH

Comments:/Conditions:

WELL

AS BUILT SKETCH

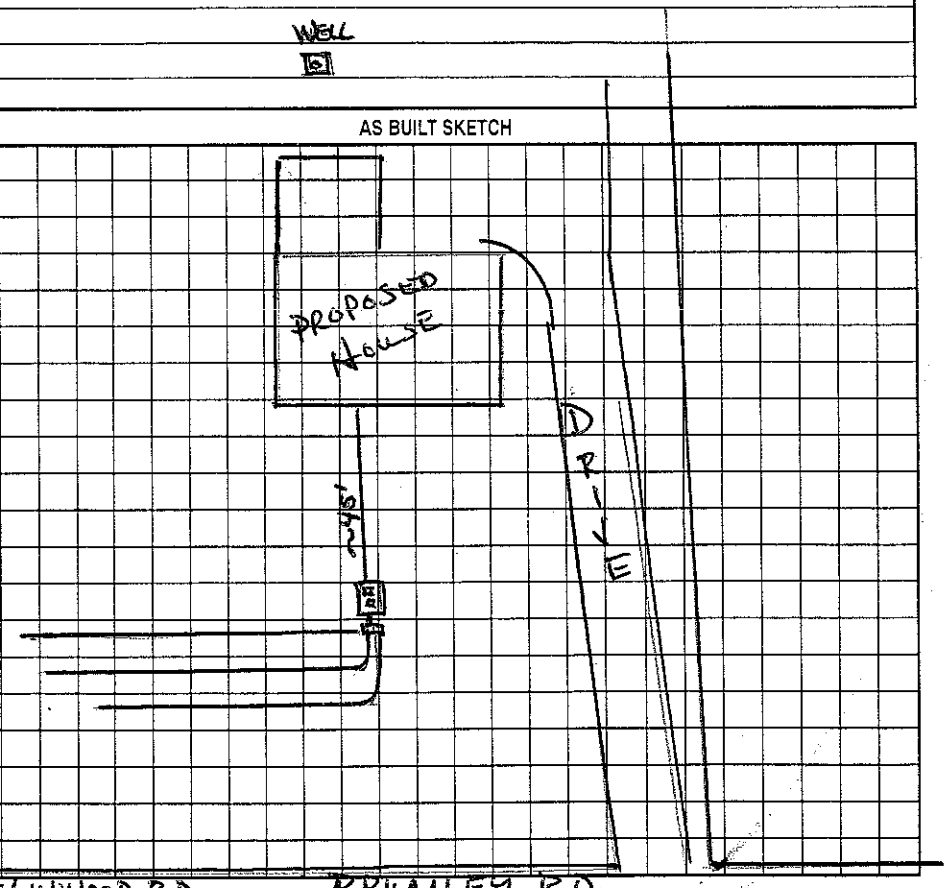

Permit can be suspended or revoked if any false information is supplied toward securing the permit/any unauthorized changes are made to the site/any unauthorized changes are made in the installation of the system. Improvement Permit with plat valid without expiration. Improvement Permit with site plan valid for sixty months. Authorization to Construct is valid for a period equal to that of Improvement Permit – not to exceed sixty months.

Signed: date 11-2-01

Improvement Permit by: date

Authorization to Construct by: date

Installed by: FJ Enviro - 1982

Operation Permit by: date

Existing System Inspection by: Wesley Sparks RS. date 11/1/01

HEALTH DEPT. COPY: WHITE OWNER COPY (FINAL): YELLOW OWNER COPY (INITIAL): PINK