IREDELL COUNTY HEALTH DEPARTMENT

STATESVILLE 704-878-5305 MOORESVILLE 704-664-5281

IMPROVEMENT PERMIT / AUTHORIZATION TO CONSTRUCT / OPERATION PERMIT / EXISTING SYSTEM INSPECTION

PERMIT# 136328 PIN# 4676-61-8986 DATE 7-26-06

OWNER OR APPLICANT IREDELL GROUP, LLC PHONE: Business _____ Home 704-663-4050

ADDRESS 109-C WILLIAMSON ROAD, MOORESVILLE, NC 28117

LOCATION NC 152 E, TR TEETER ROAD, TL WALDEN DR, TR RIVERCHASE LANE, 5TH LOT ON (R) PAST WALNUT HILL COURT

SUBDIVISION WALDEN RIDGE BLOCK / SECTION _____ LOT 22 LOT AREA 1.0 ACRE SITE CLASS. PS1 DESIGN FLOW 480 L.T.A.R. 0.30 GPD/FT²

Septic Tank: 1000 Gallons; STB 6-18-06 Date 7-9

Pump Tank: _____ Gallons; PT _____ Date _____

Pump Make: _____ Model _____ Serial No. _____

Nitrification Field: No. Fields 1 Square Feet EQ. P 1600 Linear Feet 400

No. Lines FOUR Trench Width 36" Max Trench Bottom Depth 36" Gravel Depth N/A

☑ New System ☐ Repair ☐ Expansion System Type: I (II) III IV V VI

System Description: 25% REDUCTION, GRAVITY

Repair System Description: 50% REDUCTION, Low-Pressure

Maintenance Agreement Required: ☐ Yes ☑ No

☑ House/Mod. Home No. Bedrooms 4

☐ Mobile Home No. Persons _____

☐ Business No. Employees _____

☐ Other _____


Water Supply: ☑ Individual ☐ Public ☐ Community

☑ Gravity ☐ Pressure ☐ Slab ☑ Crawl Space ☐ Basement w/plumbing ☐ Basement wo/plumbing


Comments:/Conditions ① REMOVE EXISTING FIELD TERRACE
② INSTALL 25% REDUCTION SYSTEM ON CONTOUR
③ KEEP SYSTEM MINIMUM 100 FEET FROM WELL

Comments:/Conditions:
- Polylock fullers used
- QJ.ck 4's Installed

INITIAL SITE SKETCH SCALE: 1" = 50'

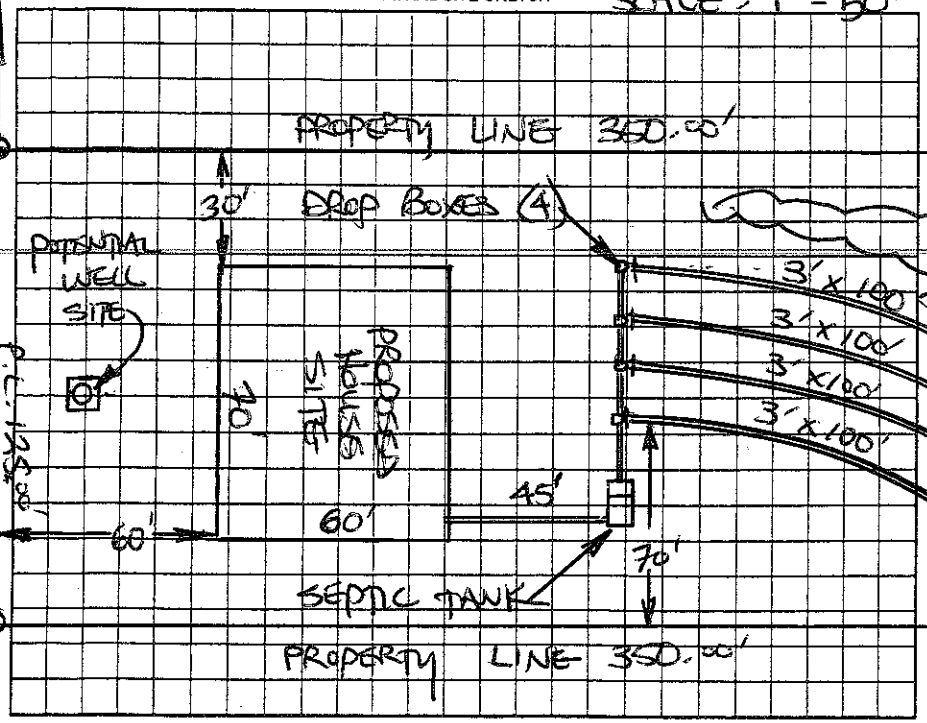

AS BUILT SKETCH

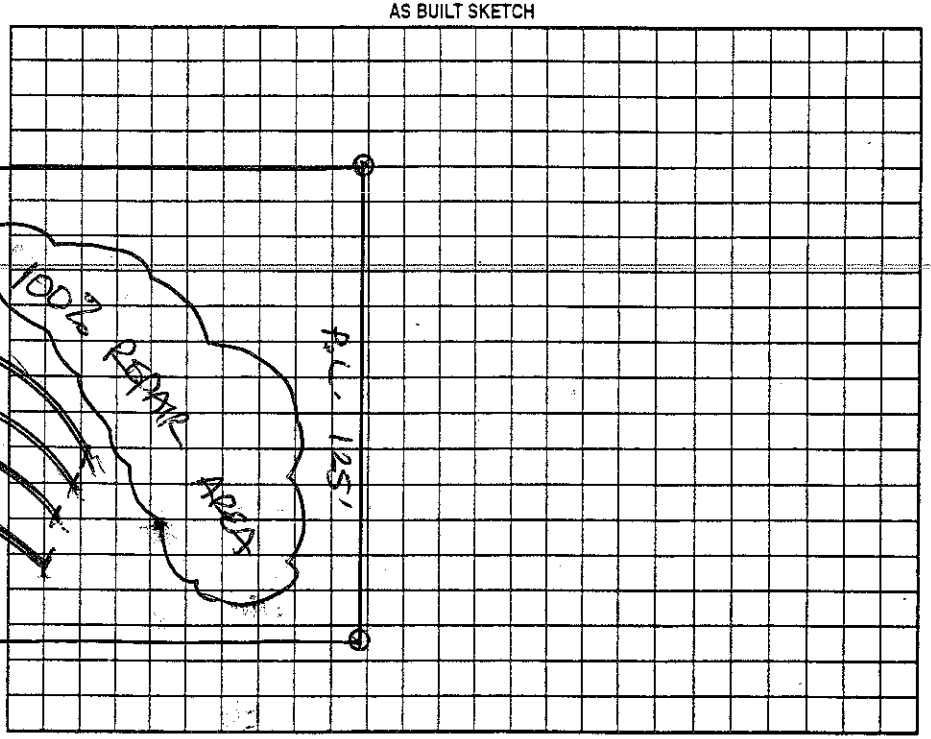

RIVERCHASE LANE

Permit can be suspended or revoked if any false information is supplied toward securing the permit/any unauthorized changes are made to the site/any unauthorized changes are made in the installation of the system. Improvement Permit with plat valid without expiration ☐ Improvement Permit with site plan valid for sixty months ☑ Authorization to Construct is valid for a period equal to that of Improvement Permit – not to exceed sixty months.

Signed: Stacy Lusk date 8-1-06 Installed by: Howard's ~ Garrett + Blake

Improvement Permit by: STEVE HENDRICK date 7-26-06 Operation Permit by: John E Allen date 12-19-06

Authorization to Construct by: Judy Melville date 8-4-06 Existing System Inspection by: _____ date _____

HEALTH DEPT. COPY: WHITE OWNER COPY (FINAL): YELLOW OWNER COPY (INITIAL): PINK