IREDELL COUNTY HEALTH DEPARTMENT

STATESVILLE 704-878-5305 MOORESVILLE 704-664-5281

IMPROVEMENT PERMIT / AUTHORIZATION TO CONSTRUCT / OPERATION PERMIT / EXISTING SYSTEM INSPECTION

PERMIT # 140384 PIN # 4676619753 DATE 10-26-2010

OWNER or APPLICANT Kent Shaw PHONE: Business 704 902-0085 Home:

OWNER or APPLICANT ADDRESS P.O. Box 1061 Troutman NC 28166

LOCATION / DIRECTIONS Main St TR Linward TL Teeter Rd TR Walden TR Riverchase on right

SUBDIVISION Walden Ridge BLOCK / SECTION LOT # 24 LOT AREA 1.26Ac DESIGN FLOW 480gpd L.T.A.R. .3

Septic Tank 1000 Gallons: STB 1794 Date 6-7-10

Pump Tank Gallons: PT Date

Pump Make Model Serial #

Nitrification Field No Fields 1 No Lines 4 Linear Feet 400'

Trench Width 36" Max. Trench Bottom Depth 36" Gravel Depth N/A

☒ New System ☐ Repair ☐ Expansion System Type I II III IV V VI

System Description: Gravity - 25% Reduction

Repair System Description: Pump - LP - Panel Blk

Maintenance Agreement Required ☐ YES ☒ NO

☒ Residence No. Bedrooms 4 ☐ Business No. Persons ☐ Other No. Employees ☐ Slab ☐ Crawl Space ☐ Basement w/plumbing ☐ Basement w/o plumbing


Water Supply ☒ Private ☐ Public ☐ Community

Comments / Conditions


Scale 1:50

Comments / Conditions ~~Must keep future pool "cut"~~ at least 15ft from Septic System.

INITIAL SITE SKETCH

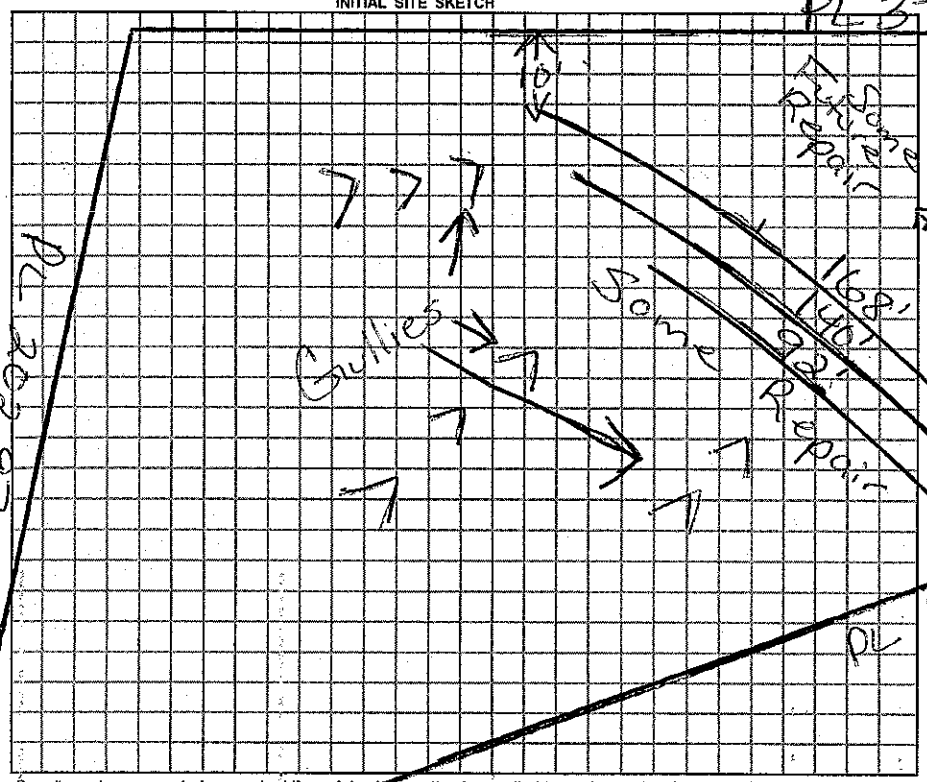

AS BUILT SKETCH

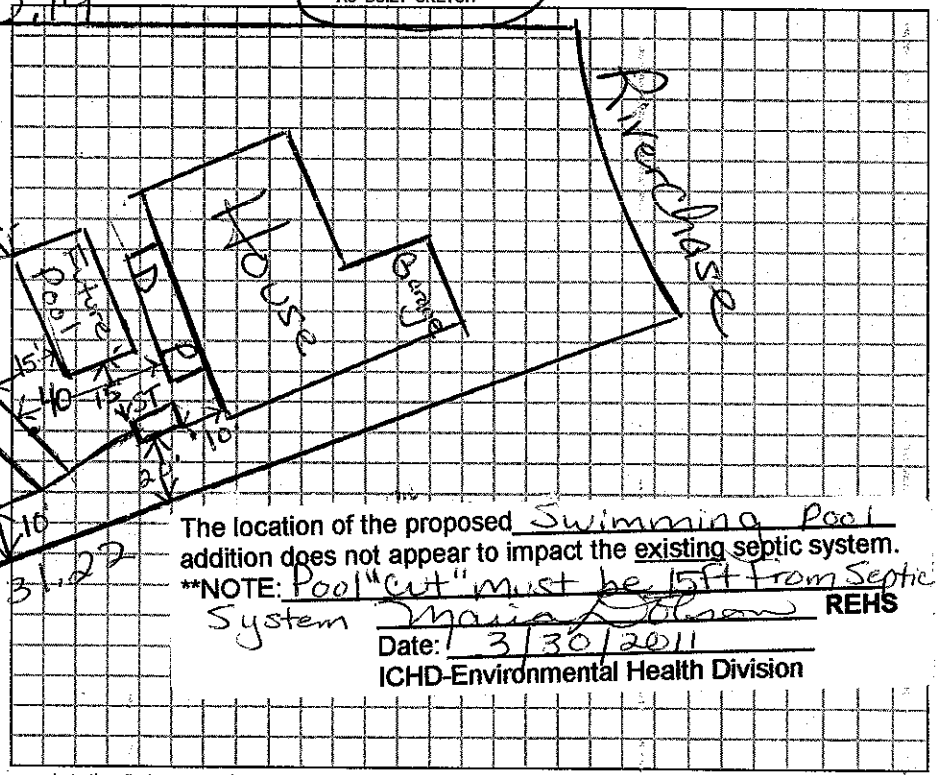

The location of the proposed Swimming Pool addition does not appear to impact the existing septic system.

**NOTE: Pool "cut" must be 15ft from Septic System Maria Dotson REHS

Date: 3/30/2011

ICHD-Environmental Health Division

Permit can be suspended or revoked if any false information is supplied toward securing the permit / any unauthorized changes are made to the site / any unauthorized changes are made in the installation of the system.

☐ *IMPROVEMENT PERMIT w / plat valid without expiration.* ☐ *IMPROVEMENT PERMIT w / site plan valid for 60 mos.* ☐ *AUTHORIZATION TO CONSTRUCT valid for period equal to IMPROVEMENT PERMIT-not to exceed 60 mo.*

Owner / Applicant Signature: Date

Improvement Permit by: Date

Authorization to Construct by: Date

YOU SHOULD CONTACT A LOCATOR SERVICE PRIOR TO ANY EXCAVATION.

Installed by: C Wayne Orbison

Operation Permit by: Maria Dotson REHS Date: 10/26/2010

Existing System Inspected by: Date:

WHITE COPY Environmental Health YELLOW COPY (Final) Owner / Applicant PINK COPY (Initial) Owner / Applicant

2100

IREDELL COUNTY HEALTH DEPARTMENT

STATESVILLE 704-878-5305 MOORESVILLE 704-664-5281

IMPROVEMENT PERMIT / AUTHORIZATION TO CONSTRUCT / OPERATION PERMIT / EXISTING SYSTEM INSPECTION

PERMIT # 140.384 PIN # 4676661975 3 DATE 3-5-2010

OWNER or APPLICANT Kent Shaw (Shaw Builders) PHONE: Business 704 902-0085 Home: 704 528-4494

OWNER or APPLICANT ADDRESS P.O. Box 1061 Troutman, NC 28166

LOCATION / DIRECTIONS Main St N TR Linwood TL Teeter Rd TR Walden TR Riverchase on right

SUBDIVISION Walden Ridge BLOCK / SECTION LOT # 24 LOT AREA 1.26Ac DESIGN FLOW 480gpd L.T.A.R. .3

Septic Tank 1000 Gallons: STB 794 Date 6-7-10

Pump Tank Gallons: P T Date

Pump Make Model Serial #

Nitrification Field No Fields 1 No Lines 4 Linear Feet 400'

Trench Width 36" Max. Trench Bottom Depth 36" Gravel Depth N/A

☒ New System ☐ Repair ☐ Expansion System Type I II III IV V VI

System Description: Gravity-25% Reduction

Repair System Description: Pump-LP-Panel Blk

Maintenance Agreement Required ☐ YES ☒ NO

☒ GRAVITY ☐ PRESSURE

☒ Residence No. Bedrooms 4

☐ Business No. Persons

☐ Other No. Employees

☐ Slab ☐ Crawl Space

☐ Basement w/plumbing ☐ Basement w/o plumbing


Water Supply: ☒ Private ☐ Public ☐ Community

Comments / Conditions: Original Site evaluation done by Rollans Soil & Environmental Services Inc. PL 370.19

Comments / Conditions: This permit replaces previous permit dated 6-12-07

Scale 1:50'

INITIAL SITE SKETCH

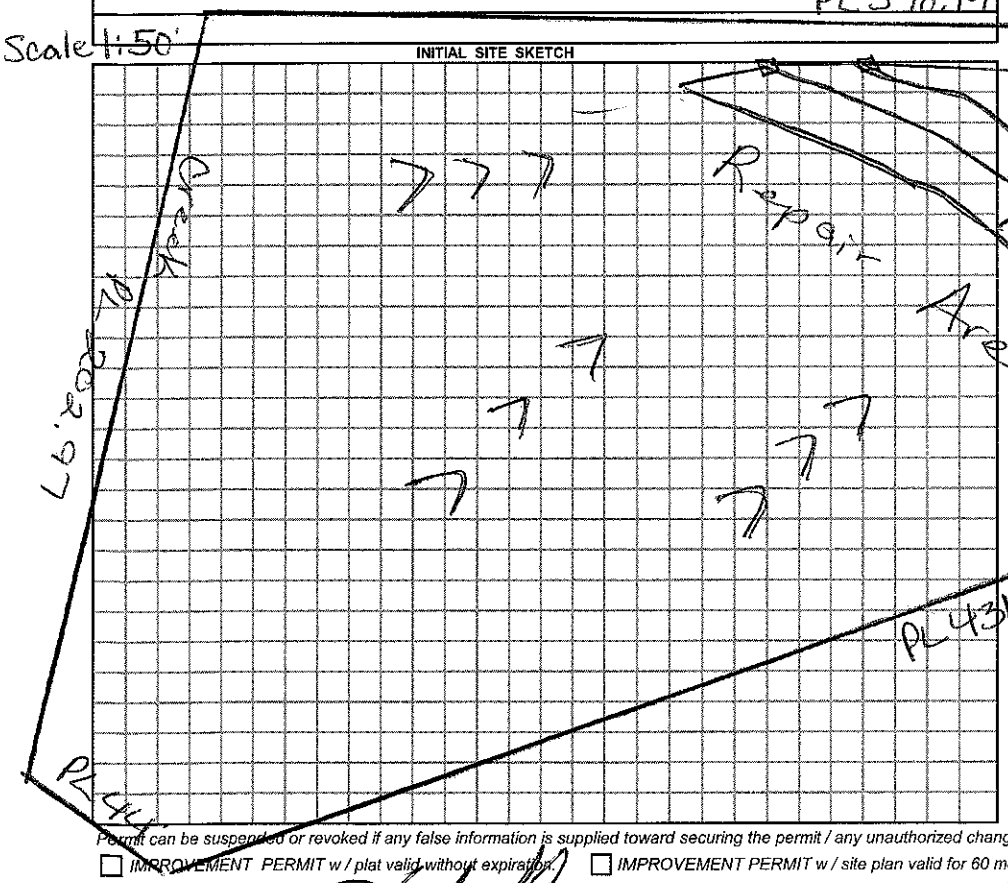

AS BUILT SKETCH



Permit can be suspended or revoked if any false information is supplied toward securing the permit / any unauthorized changes are made to the site / any unauthorized changes are made in the installation of the system.

☐ IMPROVEMENT PERMIT w / plat valid without expiration ☐ IMPROVEMENT PERMIT w / site plan valid for 60 mos. ☐ AUTHORIZATION TO CONSTRUCT valid for period equal to IMPROVEMENT PERMIT-not to exceed 60 mo.

Owner / Applicant Signature: Date 3-12-10 Installed by: Orbison Grading

Improvement Permit by: Maria H. Orbison REHS Date 3-5-2010 Operation Permit by: Maria H. Orbison Date: 10/26/2010

Authorization to Construct by: Maria H. Orbison REHS Date 3-5-2010 Existing System Inspected by: Date:

YOU SHOULD CONTACT A LOCATOR SERVICE PRIOR TO ANY EXCAVATION.

WHITE COPY Environmental Health YELLOW COPY (Final) Owner / Applicant PINK COPY (Initial) Owner / Applicant