IREDELL COUNTY HEALTH DEPARTMENT

STATESVILLE 704-878-5305 MOORESVILLE 704-664-5281

IMPROVEMENT PERMIT / AUTHORIZATION TO CONSTRUCT / OPERATION PERMIT / EXISTING SYSTEM INSPECTION

PERMIT# 136329 PIN# 4676-61-9815 4676-61-9856 DATE 7-26-06

OWNER OR APPLICANT IREDELL GROUP, LLC PHONE: Business Home 704-663-4050

ADDRESS 109-C WILLIAMSON ROAD, MOORESVILLE, NC 28117

LOCATION NC 152 EAST, TR TEETER ROAD, TL WALDEN DR, TR RIVERCHASE LANE, 6TH LOT ON (R) PAST WALNUT HILL COURT

SUBDIVISION WALDEN RIDGE BLOCK / SECTION LOT 23 LOT AREA 1.03 ACRES SITE CLASS. PS DESIGN FLOW 480 L.T.A.R. 0.30 GAD/FT2

Septic Tank: 1000 Gallons; STB 1007 Date 12-14-07

Pump Tank: Gallons; PT Date

Pump Make: Model Serial No.

Nitrification Field: No Fields 1 Square Feet 1600 Linear Feet 400

No Lines FOUR Trench Width 36" Max Trench Bottom Depth 36"

☑ New System ☐ Repair ☐ Expansion System Type: I (II) III IV V VI

System Description: 25% REDUCTION GRAVITY

Repair System Description: 50% REDUCTION, LOW PRESSURE

Maintenance Agreement Required: ☐ Yes ☑ No

Gravel Depth N/A ☑ Gravity ☐ Pressure

☑ House/Mod. Home ☐ Mobile Home ☐ Business ☐ Other

No. Bedrooms 4 No. Persons No. Employees


Water Supply: ☑ Individual ☐ Public ☐ Community

☐ Slab ☑ Crawl Space ☐ Basement w/plumbing ☐ Basement wo/plumbing


Comments:/Conditions: ① KEEP SYSTEM MINIMUM 100 FEET FROM WELL ② INSTALL 25% REDUCTION SYSTEM ON CONTOUR AS SHOWN ③ REMOVE EXISTING FIELD TERRACE

Comments:/Conditions:

INITIAL SITE SKETCH SCALE: 1"=50'

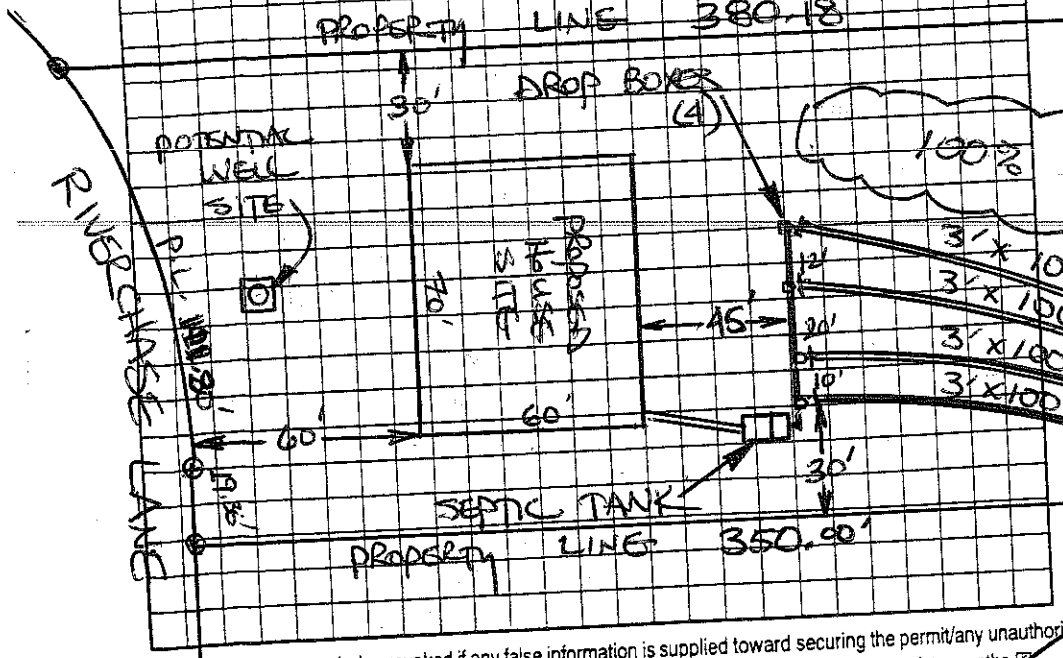

AS BUILT SKETCH

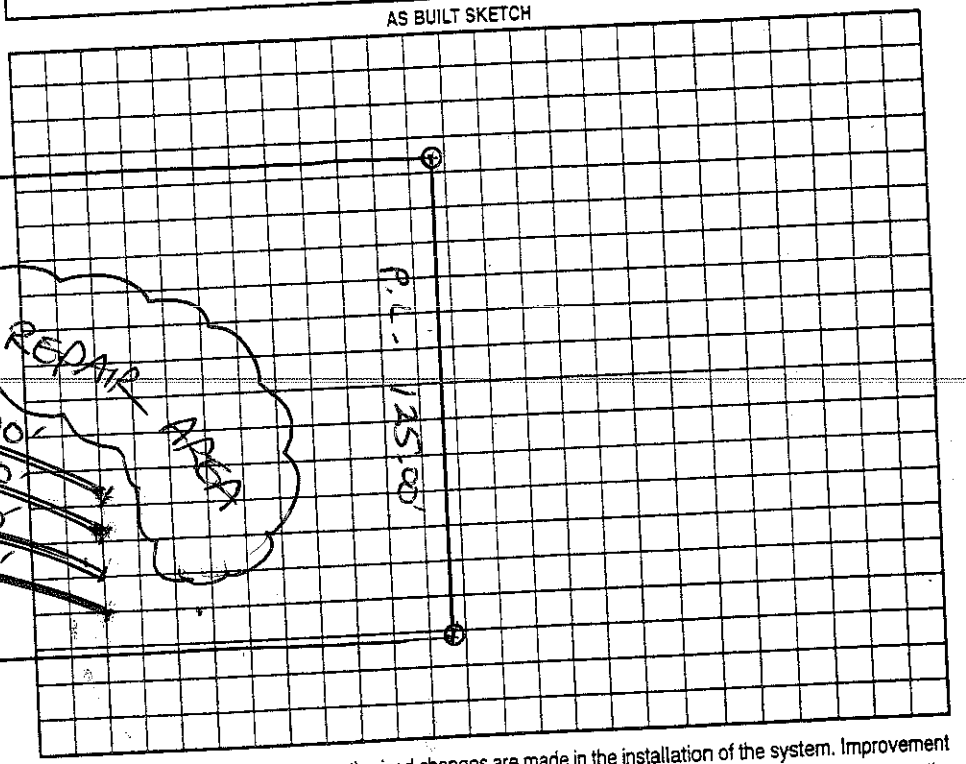

Permit can be suspended or revoked if any false information is supplied toward securing the permit/any unauthorized changes are made to the site/any unauthorized changes are made in the installation of the system. Improvement Permit/Authorization to Construct is valid for a period equal to that of Improvement Permit – not to exceed sixty months.

Permit with plat valid without expiration ☐ Improvement Permit with site plan valid for sixty months ☑

d: Stacy Lusk date 5-1-06 Installed by: Howard's Backhoe

ent Permit by: STEVE HEDRICK date 7-26-06 Operation Permit by: date 1/29/07

to Construct by: Wesley Sparks RS date 9/20/06 Existing System Inspection by: date

HEALTH DEPT. COPY: WHITE OWNER COPY (FINAL): YELLOW OWNER COPY (INITIAL): PINK