8.00

IREDELL COUNTY HEALTH DEPARTMENT

STATESVILLE 704-878-5305 MOORESVILLE 704-664-5281

IMPROVEMENT PERMIT / AUTHORIZATION TO CONSTRUCT / OPERATION PERMIT / EXISTING SYSTEM INSPECTION

PERMIT# 134603 PIN# 4676628878

OWNER OR APPLICANT RAY SHORT DATE 12/20/06

ADDRESS PHONE: Business Home

LOCATION LINWOOD RD(S), TL TEETER, TR WALDEN DR, TR RIVERCHASE LN 4TH LOT ON RT

SUBDIVISION WAGON RIDGE BLOCK / SECTION LOT 15 LOT AREA 1 ACRE SITE CLASS. DS DESIGN FLOW 480 L.T.A.R. .3 gpd/SQFT

Septic Tank: 1000 Gallons: STB 794 Date 6-13-06

Pump Tank: 1000 Gallons: PT 233 Date 4-14-06

Pump Make: Gould's Model PES1M Serial No. J0611955

Nitrification Field: No Fields 1 Square Feet 1200 Linear Feet 400

No Lines 4@100' Trench Width 36" Max Trench Bottom Depth 30"

☒ New System ☐ Repair ☐ Expansion System Type: I II III IV V VI

System Description: Pump to 25% Reduction

Repair System Description: Low Pressure Panel

Maintenance Agreement Required: ☐ Yes ☒ No

Gravel Depth N/A ☐ Gravity ☒ Pressure ☐ Slab ☒ Crawl Space ☐ Basement w/plumbing ☐ Basement wo/plumbing

☒ House/Mod. Home No. Bedrooms 4

☐ Mobile Home No. Persons

☐ Business No. Employees

☐ Other


Water Supply: ☒ Individual ☐ Public ☐ Community

Comments:/Conditions: Minimum of 15' setback from pool site to any part of septic system


- Install lines @ 9' on center minimum

Comments:/Conditions:

INITIAL SITE SKETCH

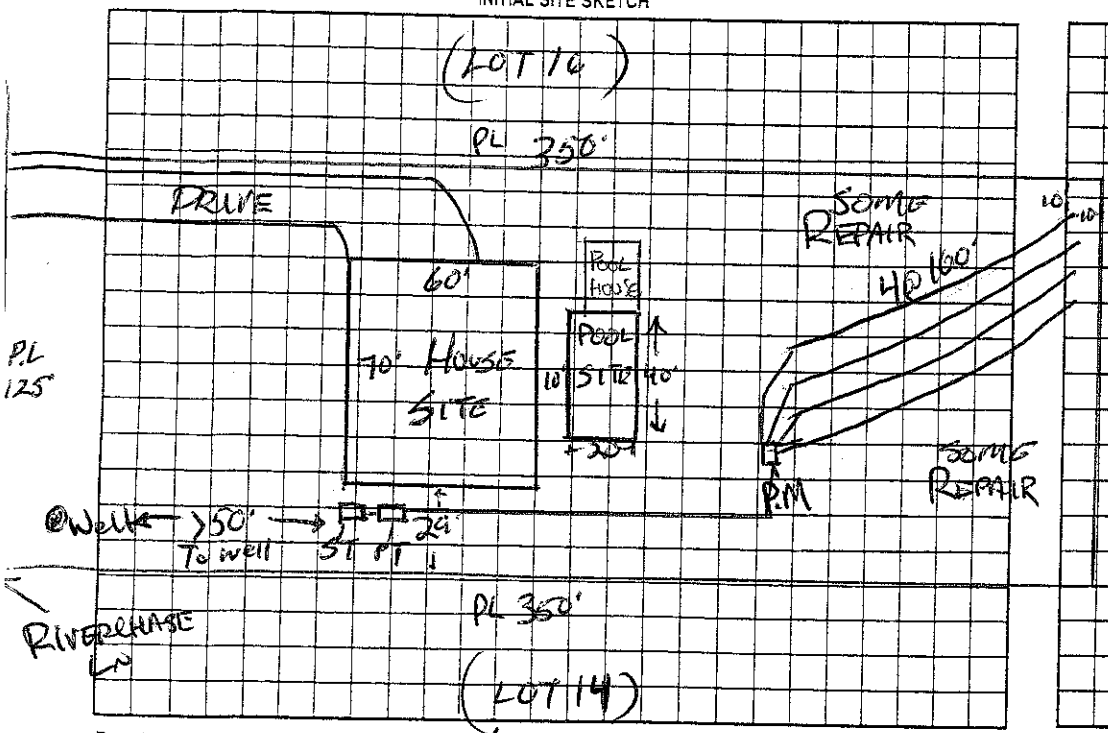

AS BUILT SKETCH

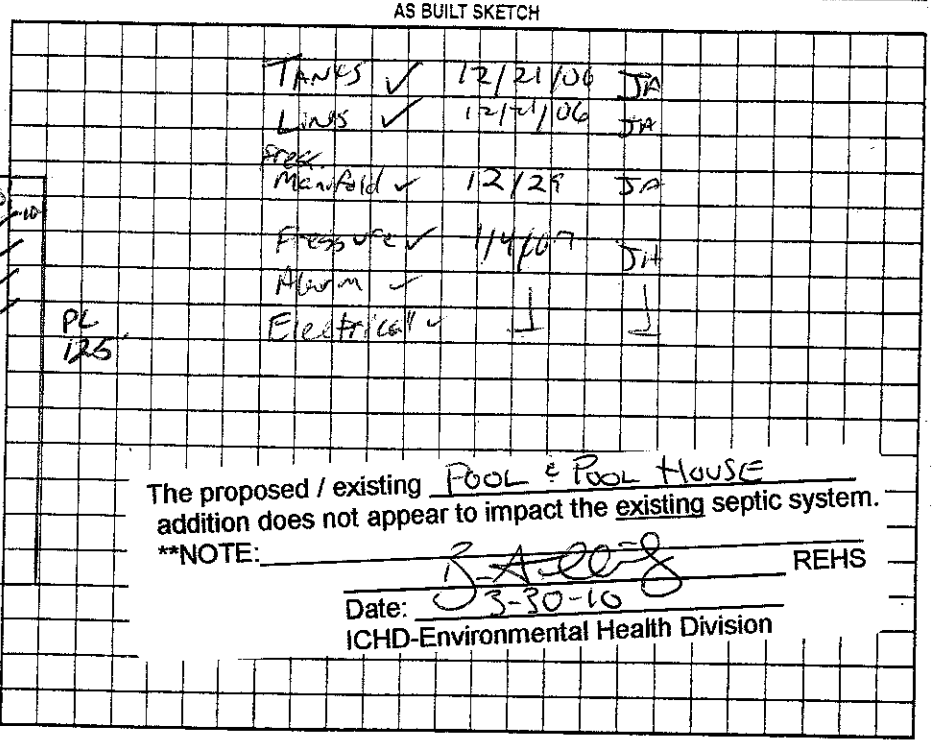

The proposed / existing POOL & POOL HOUSE addition does not appear to impact the existing septic system.

**NOTE: JA 12-28 REHS

Date: 3-30-10

ICHD-Environmental Health Division

Permit can be suspended or revoked if any false information is supplied toward securing the permit/any unauthorized changes are made to the site/any unauthorized changes are made in the installation of the system. Improvement Permit with plat valid without expiration ☐ Improvement Permit with site plan valid for sixty months ☒ Authorization to Construct is valid for a period equal to that of Improvement Permit – not to exceed sixty months.

Signed: date

Improvement Permit by: date 12/20/06

Authorization to Construct by: date 12/20/06

Installed by: Howard's Backhoe

Operation Permit by: date 1/4/07

Existing System Inspection by: date

HEALTH DEPT. COPY: WHITE OWNER COPY (FINAL): YELLOW OWNER COPY (INITIAL): PINK