IREDELL COUNTY HEALTH DEPARTMENT

STATESVILLE 704-878-5305 MOORESVILLE 704-664-5281

IMPROVEMENT PERMIT / AUTHORIZATION TO CONSTRUCT / OPERATION PERMIT / EXISTING SYSTEM INSPECTION

PERMIT# 13460l PIN# 4676 62 8977 DATE April 18, 2006

OWNER OR APPLICANT Iredell Group LLC PHONE: Business 704 344 5944 Home

ADDRESS 109-C Williamson Rd, Mooresville, N.C. 28117

LOCATION Linwood Rd (S) TL TEETER Rd. TR Walden Dr. TR Riverchase Ln. 3rd Lot on Right

SUBDIVISION Walden Ridge BLOCK / SECTION LOT 14 LOT AREA 1ac SITE CLASS. PS DESIGN FLOW 480gpd L.T.A.R. .275

Septic Tank: 1000 Gallons; STB 794 Date 10-1-06

Pump Tank: 1000 Gallons; PT 17 Date 10-2-06

Pump Make: Model Serial No.

Nitrification Field: No Fields 1 Square Feet 1320 Linear Feet 440

No Lines 4@110' Trench Width 36" Max Trench Bottom Depth 36" Gravel Depth N/A

☒ New System ☐ Repair ☐ Expansion System Type: I II III IV V VI

System Description: pm 25% Reduction

Repair System Description: LPP BPS

Maintenance Agreement Required: ☐ Yes ☒ No Initially

☒ House/Mod. Home No. Bedrooms 4

☐ Mobile Home No. Persons

☐ Business No. Employees

☐ Other

Water Supply: ☒ Individual ☐ Public ☐ Community

☐ Gravity ☒ Pressure ☐ Slab ☒ Crawl Space ☐ Basement w/plumbing ☐ Basement wo/plumbing

Comments:/Conditions:

Comments:/Conditions:

INITIAL SITE SKETCH

SEE Plan from Rollins Soil & Env. Services

AS BUILT SKETCH

Permit can be suspended or revoked if any false information is supplied toward securing the permit/any unauthorized changes are made to the site/any unauthorized changes are made in the installation of the system. Improvement Permit with plat valid without expiration ☐ Improvement Permit with site plan valid for sixty months ☒ Authorization to Construct is valid for a period equal to that of Improvement Permit – not to exceed sixty months.

Signed: Shanta Brooks date 4-24-06

Improvement Permit by: [signature] RS date 4-18-06


Authorization to Construct by: [signature] RS date 5/11/06

Installed by: Howard's

Operation Permit by: [signature] date 11/15/06

Existing System Inspection by: date

HEALTH DEPT. COPY: WHITE OWNER COPY (FINAL): YELLOW OWNER COPY (INITIAL): PINK

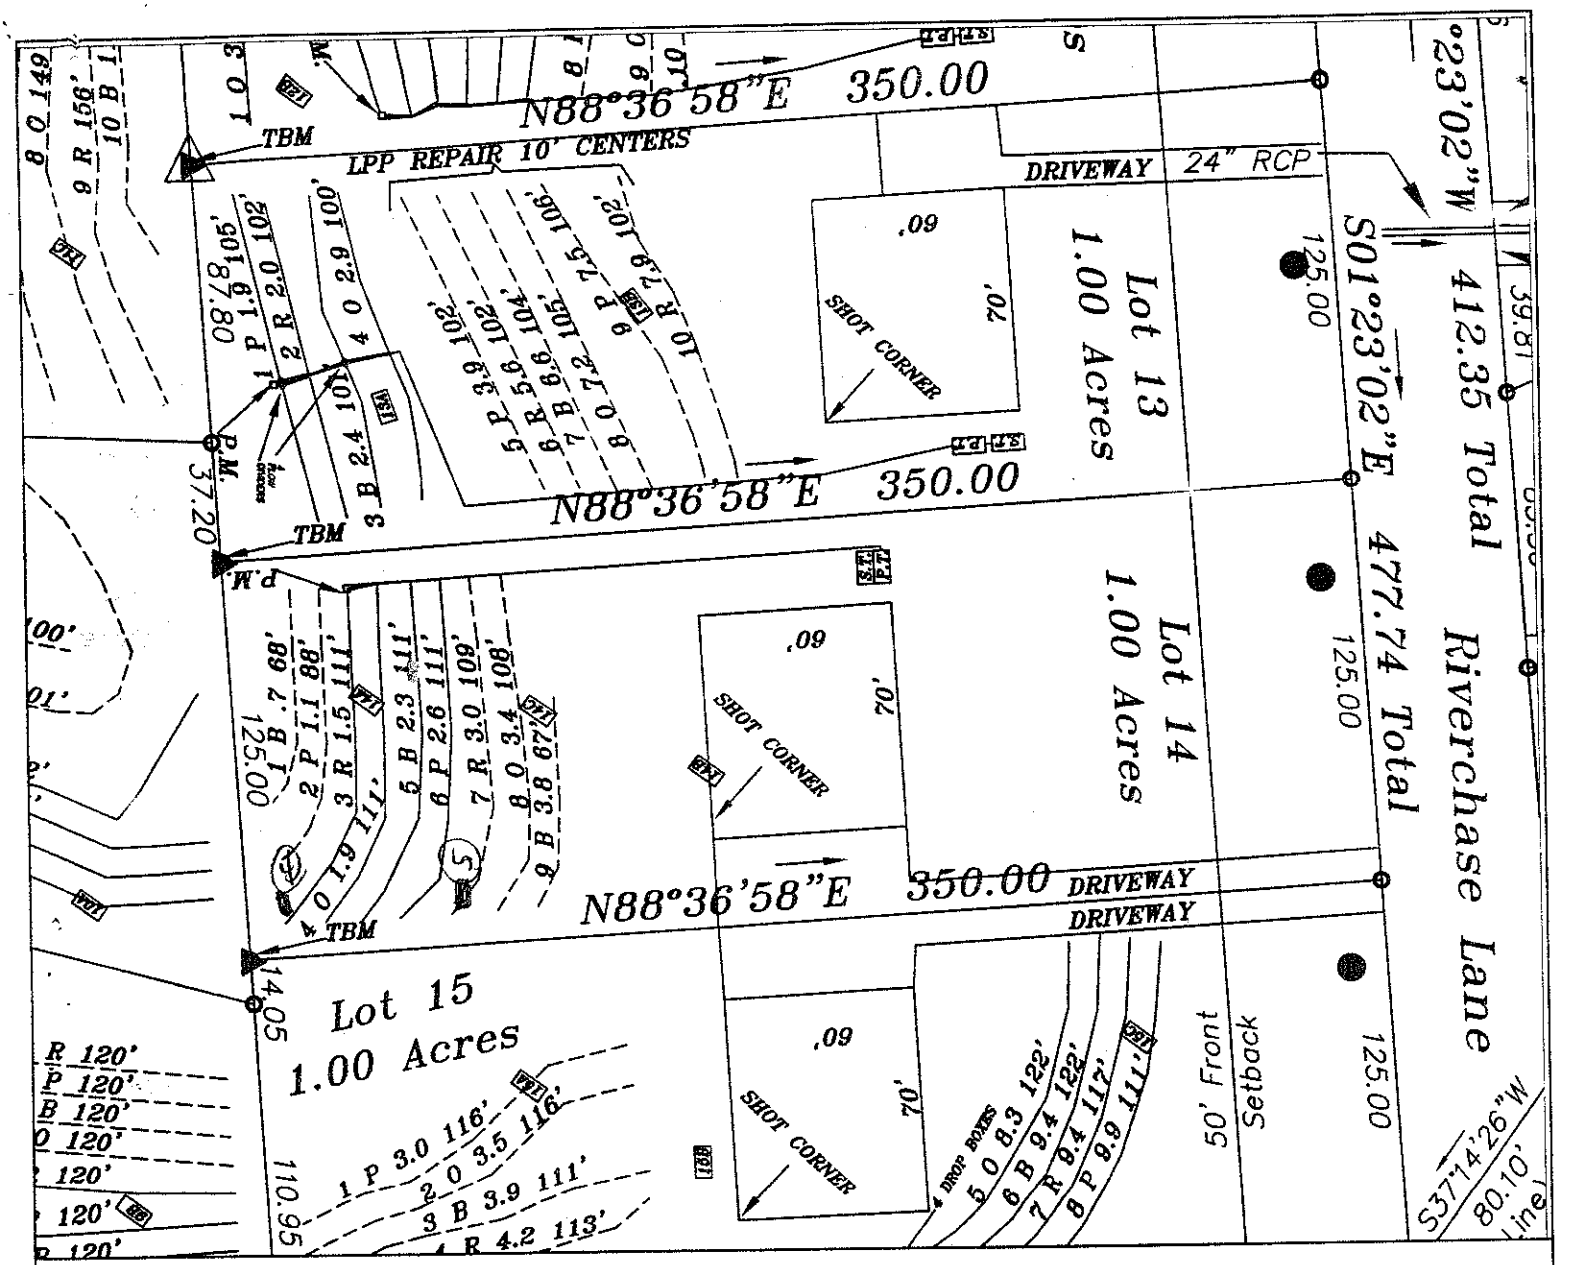

LEGEND

- Areas contain soils with 24 inches or more of useable material and have potential for conventional, modified conventional and low-pressure pipe (lpp) septic systems.
- Unsuitable areas.
- System lines.
- Repair lines.
- Temporary Bench Mark (TBM)
- Well Location.

GRAPHIC SCALE
1" = 60'

60 0 60 120

FOR PRELIMINARY PLANNING PURPOSES ONLY. ALL LOTS WILL REQUIRE FINAL APPROVAL BY THE COUNTY HEALTH DEPARTMENT ON A LOT BY LOT BASIS. THIS MAP SHOULD BY USED AS A GENERAL GUIDE, SOME ADJUSTMENTS WILL BE NECESSARY IN THE FIELD DUE TO SOIL VARIABILITY AND COMPLEX TOPOGRAPHIC FEATURES. THIS MAP ONLY REFLECTS EXISTING SOIL SUITABILITY FOR ON-SITE SEPTIC TANK SYSTEMS.

PLEASE REFER TO ATTACHED SOIL REPORT FOR ADDITIONAL SITE SPECIFIC INFORMATION

ROLLANS SOIL & ENVIRONMENTAL SERVICES
2120 GRAHAM ROAD
MOUNT ULLA, NC 28125
PHONE/FAX: (704) 278-0989
ASHLEY ROLLANS, NC LICENSED SOIL SCIENTIST
MOBILE: (704) 746-5046
EMAIL: ROLLANSFORTC@AOL.COM

MAP TITLE: SITE PLAN & DRAINFIELD AREAS



JOB # : 01-1069
FILE: C:\JOBS\01-1069
PROJECT MGR.: CBF
FIELD WORK: CBF AND AP
DRAWN BY: CBF AND AP