2.00 JNP

IREDELL COUNTY HEALTH DEPARTMENT

...lle Office (704) 878-5305 Mooresville Office (704) 660-3625 PERMIT # 205650 ~~204479~~ ✓

IMPROVEMENT PERMIT / AUTHORIZATION TO CONSTRUCT / OPERATION PERMIT / EXISTING SYSTEM

PIN #4676629305

APPLICANT: Peak Contractors APPLICANT ADDRESS: 148 Riverchase Lane

SITE ADDRESS: 148 Riverchase Lane PHONE: (704) 202-5628 ALT. PHONE:

SITE DIRECTIONS: Go ~~SE~~ N to Main T R on Linwood T R on Walden Dr T R on Riverchase - House on Right


SUBDIVISION: Walden Ridge SECTION: 1 LOT # 19 LOT AREA: DESIGN FLOW: 480 L.T.A.R.: 3

Septic Tank	existing 1000 (gal)	STB 794	Date 12/9/06	☐ New System ☐ Repair ☐ Expansion	System Type: I (II) III IV V VI	☑ Residence	No. Bedrooms 4	Water Supply
Pump Tank	(gal)	PT	Date	System Description: 25% reduct chambers 4-100' lines		☐ Business	No. Persons	☑ Private
Pump Make	Model		Serial #	Repair System Description: 25% reduction chambers		☐ Other	No. Employees	☐ Public
# Nitrification Fields 1	# Lines 4 - 20' sections	Linear Ft: ~~480~~		Maintenance Agreement Required:	☐ YES ☑ NO	☐ Slab	☑ Crawl Space	☐ Community
Trench Width 36"	Max. Trench Bottom Depth 36"		Gravel Depth N/A chambers		☑ GRAVITY ☐ PRESSURE	☐ Basement w/plumbing	☐ Basement w/o plumbing	

Comments / Conditions: existing drainlines start at edge of proposed pool approximately 51 feet behind main back wall of house. Remove drain lines back to 71' behind wall and replace 20' on each corresponding drainline as shown and flagged on opposite end

Partial Drainline Relocation

INITIAL SITE SKETCH

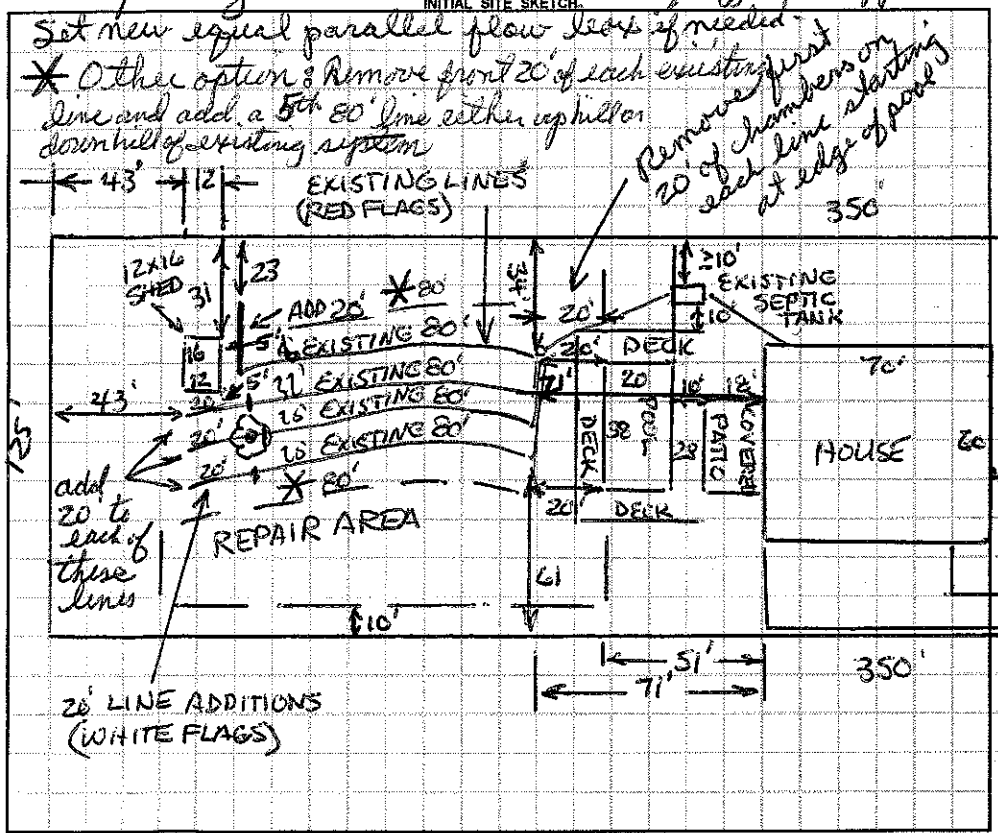

AS BUILT SKETCH

INSTALLED AS DRAWN

Permit can be suspended or revoked if any false information is supplied toward securing the permit / any unauthorized changes are made to the site / any unauthorized changes are made in the installation of the system. **CONTACT A LOCATOR SERVICE PRIOR TO ANY EXCAVATION**

☑ **IMPROVEMENT PERMIT** *with plat valid without expiration,* ☑ **IMPROVEMENT PERMIT** *with site plan valid for 60 mos.* ☑ **AUTHORIZATION TO CONSTRUCT** *valid for period equal to IMPROVEMENT PERMIT--not to exceed 60 mo.*

Owner / Applicant Signature: Arlan Kelly Date: 9/30/14 Installed by: Rowan Septic

IMPROVEMENT PERMIT by: Richard Farris Date: 9/29/14 OPERATION PERMIT by: Date: 10-23-14

AUTHORIZATION TO CONSTRUCT by: Richard Farris Date: 9/29/14 Existing System Inspected by: Date:

Health Dept. Copy - WHITE Applicant (Final Approval) - YELLOW Applicant (Conditional Approval) - PINK