IREDELL COUNTY HEALTH DEPARTMENT

STATESVILLE 704-878-5305 MOORESVILLE 704-664-5281

IMPROVEMENT PERMIT / AUTHORIZATION TO CONSTRUCT / OPERATION PERMIT / EXISTING SYSTEM INSPECTION

PERMIT# 136 323 PIN# 4676 62 9683 DATE 7/11/06

OWNER OR APPLICANT Iredell Group LLC PHONE: Business _____ Home _____

ADDRESS 109-C Williamson Rd. Mooresville NC 28117

LOCATION Linwood, TL Teeter, TR Walden Ridge, TR Riverchase, on Rt

SUBDIVISION Walden Ridge BLOCK / SECTION _____ LOT 17 LOT AREA 1.00 Ac SITE CLASS. PS DESIGN FLOW 480 L.T.A.R. 0.3

Septic Tank: 1000 Gallons; STB 1012 Date 12-5-06
Pump Tank: _____ Gallons; PT _____ Date _____
Pump Make: _____ Model _____ Serial No. _____
Nitrification Field: No Fields 1 Square Feet 1600 Linear Feet 553
No Lines 4 Trench Width 36" Max Trench Bottom Depth 36" Gravel Depth 12"

☒ New System ☐ Repair ☐ Expansion System Type: I ☒ II III IV V VI
System Description: Conventional
Repair System Description: Pump Conventional
Maintenance Agreement Required: ☐ Yes ☒ No

☒ House/Mod. Home ☐ Mobile Home ☐ Business ☐ Other
No. Bedrooms 4 No. Persons ____ No. Employees ____

Water Supply: ☒ Individual ☐ Public ☐ Community

☒ Gravity ☐ Pressure ☐ Slab ☒ Crawl Space ☐ Basement w/plumbing ☐ Basement wo/plumbing

Comments:/Conditions:


The location of the proposed Pool addition does not appear to impact the existing septic system.
**NOTE: Pool ORIGINALLY PERMITTED AS A 3 BR

REHS
Date: 03-4-11 06
ICHD-Environmental Health Division

Comments:/Conditions:

Yellow duf-tite filter 5'T w/ marker

AS BUILT SKETCH

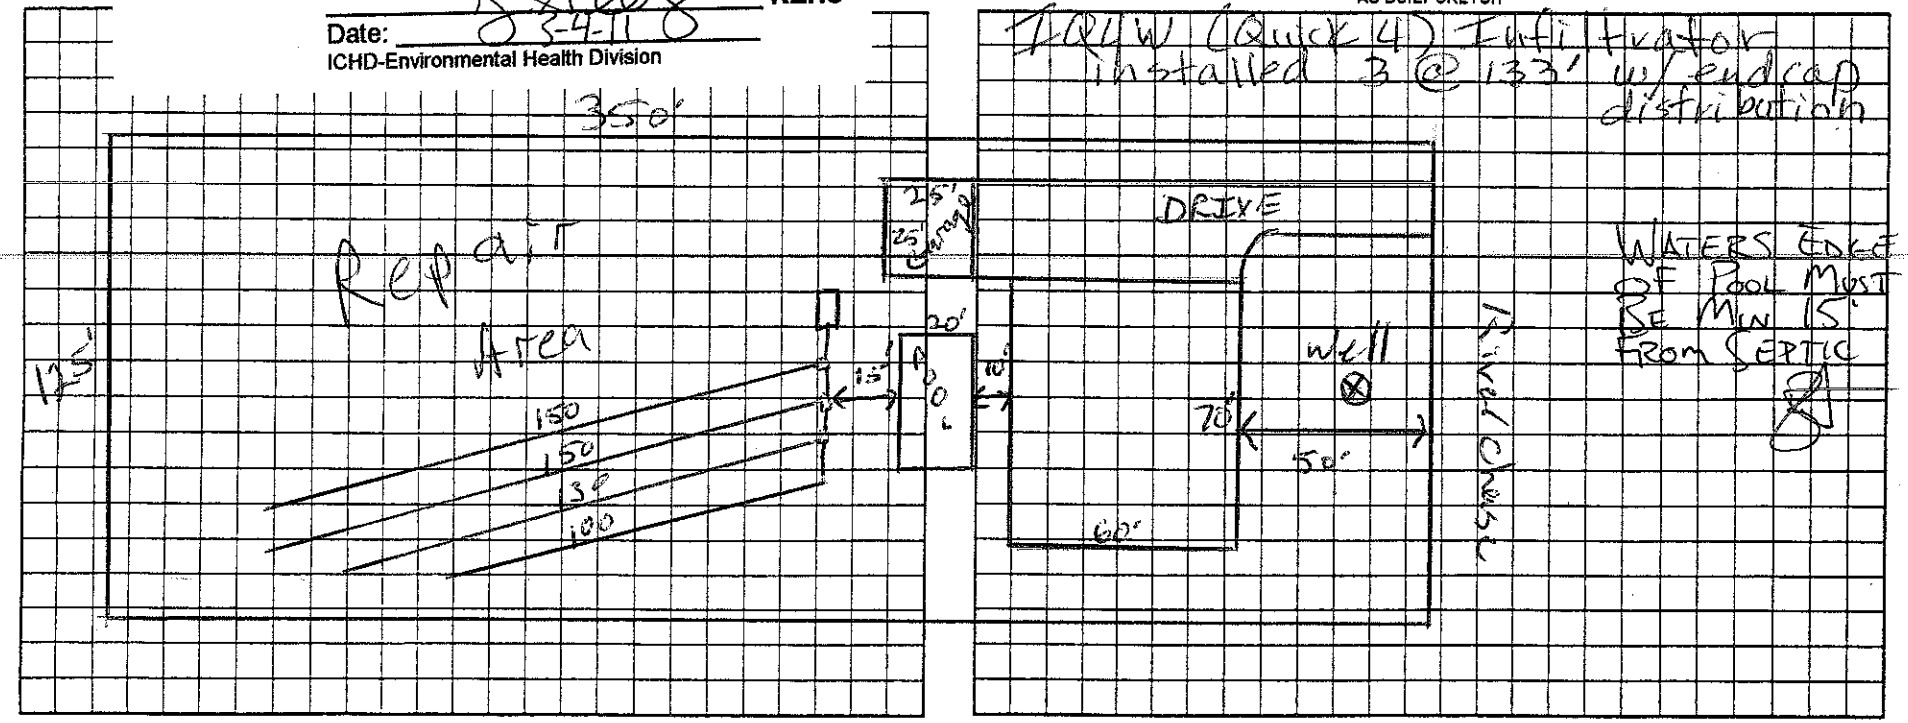

Permit can be suspended or revoked if any false information is supplied toward securing the permit/any unauthorized changes are made to the site/any unauthorized changes are made in the installation of the system. Improvement Permit with plat valid without expiration ☐ Improvement Permit with site plan valid for sixty months ☒ Authorization to Construct is valid for a period equal to that of Improvement Permit – not to exceed sixty months.

Signed: Mary Linz date 7-14-06
Improvement Permit by: [signature] RS date 7/11/06
Authorization to Construct by: [signature] RS date 10/11/06

Installed by: Craig Thompson Grading
Operation Permit by: Cindy McBride date 5-14-07
Existing System Inspection by: _____ date _____

HEALTH DEPT. COPY: WHITE OWNER COPY (FINAL): YELLOW OWNER COPY (INITIAL): PINK