IREDELL COUNTY HEALTH DEPARTMENT

STATESVILLE 704-878-5305 MOORESVILLE 704-664-5281

IMPROVEMENT PERMIT / AUTHORIZATION TO CONSTRUCT / OPERATION PERMIT / EXISTING SYSTEM INSPECTION

160393 PERMIT # 160394 PIN # 4676629793 DATE 3-29-2010

OWNER or APPLICANT Martin White/Artistic Pools PHONE: Business 704507-3689 Home:

OWNER or APPLICANT ADDRESS 9201 Magnolia Estate Cornelius, NC 28031

LOCATION / DIRECTIONS Main St TR Linwood TL Teeter Rd TR Walden Ridge TR Riverchase on Rt

SUBDIVISION Walden Ridge BLOCK / SECTION LOT # 16 LOT AREA 1.0Ac DESIGN FLOW 480gpd L.T.A.R. .3

Exist

Septic Tank 1000 Gallons: STB Date

Pump Tank Gallons: P T Date

Pump Make Model Serial #

Nitrification Field No Fields 1 No Lines 3 Linear Feet 400'

Trench Width 36" Max. Trench Bottom Depth 36" Gravel Depth N/A

☐ New System ☐ Repair ☐ Expansion System Type I (II) III IV V VI

System Description: Exist. Gravity - 25% Reduction

Repair System Description: Pump - 25% Reduction

Maintenance Agreement Required ☐ YES ☒ NO

☒ GRAVITY ☐ PRESSURE

☒ Residence No. Bedrooms 4

☐ Business No. Persons

☐ Other No. Employees

☐ Slab ☐ Crawl Space

☐ Basement w/plumbing ☐ Basement w/o plumbing


Water Supply: ☒ Private ☐ Public ☐ Community

Comments / Conditions: Existing Septic System appears to be functioning Okay at time of inspection.


Comments / Conditions: Must keep pool "cut" at least 15FT from Septic System. House addition (½ Bath) must be at least 5FT from Septic System. Tie plumbing into House plumbing to keep Gravity to ST.

INITIAL SITE SKETCH

Scale 1: 40

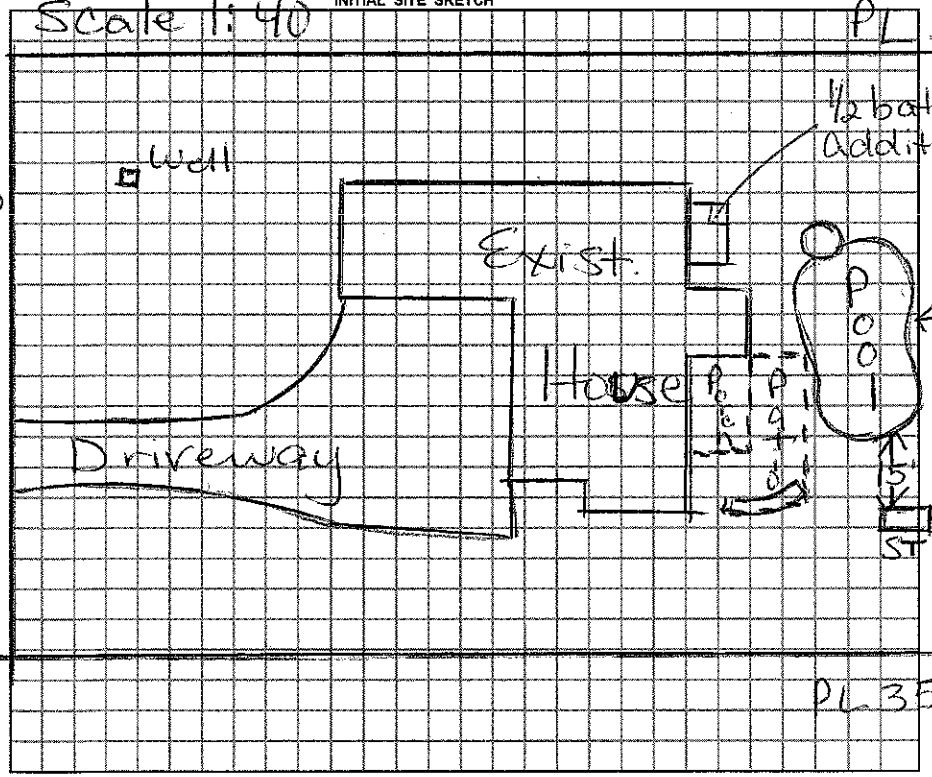

AS BUILT SKETCH

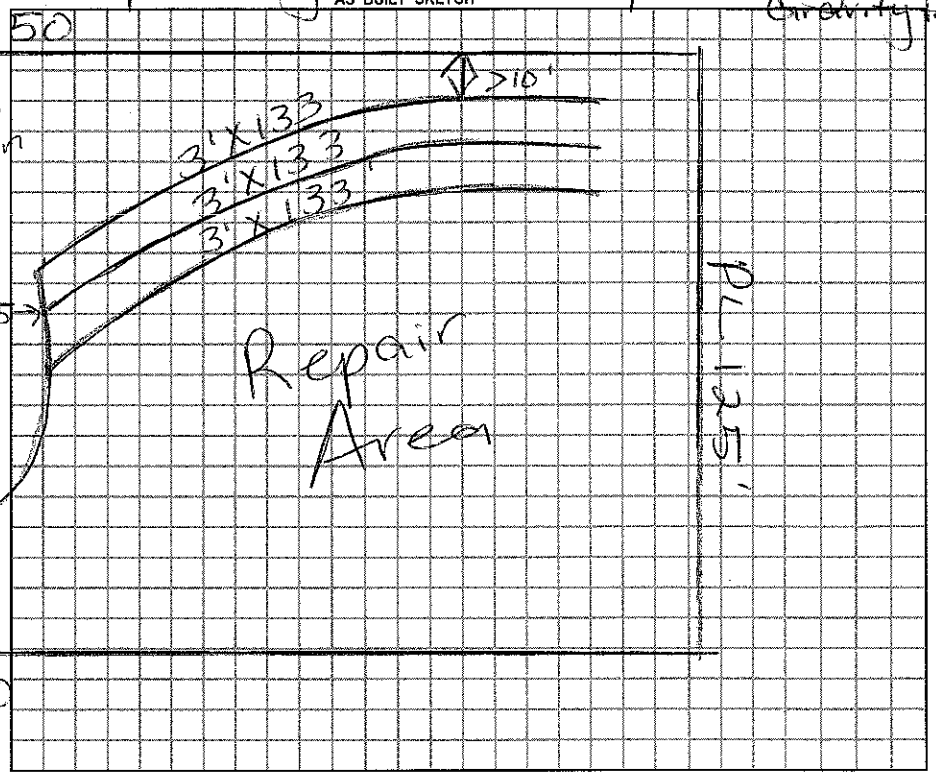

Riverchase

Permit can be suspended or revoked if any false information is supplied toward securing the permit / any unauthorized changes are made to the site / any unauthorized changes are made in the installation of the system.

☐ *IMPROVEMENT PERMIT w / plat valid without expiration.* ☐ *IMPROVEMENT PERMIT w / site plan valid for 60 mos.* ☐ *AUTHORIZATION TO CONSTRUCT valid for period equal to IMPROVEMENT PERMIT-not to exceed 60 mo.*

Owner / Applicant Signature: Bruce Martin Date 03/31/10

Improvement Permit by: Date

Authorization to Construct by: Date

YOU SHOULD CONTACT A LOCATOR SERVICE PRIOR TO ANY EXCAVATION.

Installed by:

Operation Permit by: Date:

Existing System Inspected by: Marion H Patton RS Date: 3/29/2010

WHITE COPY Environmental Health YELLOW COPY (Final) Owner / Applicant PINK COPY (Initial) Owner / Applicant

PAGE 01/01
03/07/2010 23:38 704-6649737

IREDELL COUNTY HEALTH DEPARTMENT

STATESVILLE 704-878-5305 MOORESVILLE 704-664-5281

IMPROVEMENT PERMIT / AUTHORIZATION TO CONSTRUCT / OPERATION PERMIT / EXISTING SYSTEM INSPECTION

DATE 7/11/06

PERMIT# 136 322 PIN# 4672 62 9743 PHONE: Business _____ Home _____

OWNER OR APPLICANT Freedell Group LLC

ADDRESS 109-L Williamson Rd Mooresville NC 28117

LOCATION Linwood TL Teeter, TR Walden Ridge, TR Riverchase, on Rt

SUBDIVISION Walden Ridge BLOCK / SECTION _____ LOT 16 LOT AREA 1.00 Ac SITE CLASS PS DESIGN FLOW 450 L.T.A.R. 0.3

Septic Tank: 1000 Gallons: STB 1012 Date 10-23-06

Pump Tank: _____ Gallons: PT _____ Date _____

Pump Make: _____ Model _____ Serial No. _____

Nitrification Field: No Fields 1 Square Feet 1200 Linear Feet 400

No Lines 3 Trench Width 36" Max Trench Bottom Depth 36" Gravel Depth _____

☒ New System ☐ Repair ☐ Expansion System Type: I II III IV V

System Description: 25% Reduction

Repair System Description: Pump 25% Reduct.

Maintenance Agreement Required: ☐ Yes ☒ No

☒ House/Mod. Home ☐ Mobile Home ☐ Business ☐ Other

No. Bedrooms 4 No. Persons _____ No. Employees _____

Water Supply: ☒ Individual ☐ Public ☐ Community


☐ Slab ☒ Crawl Space ☐ Basement w/plumbing ☐ Basement w/o plumbing

Comments/Conditions:


1" = 50'

Comments/Conditions: Lines checked 5-10-07 lpm

INITIAL SITE SKETCH

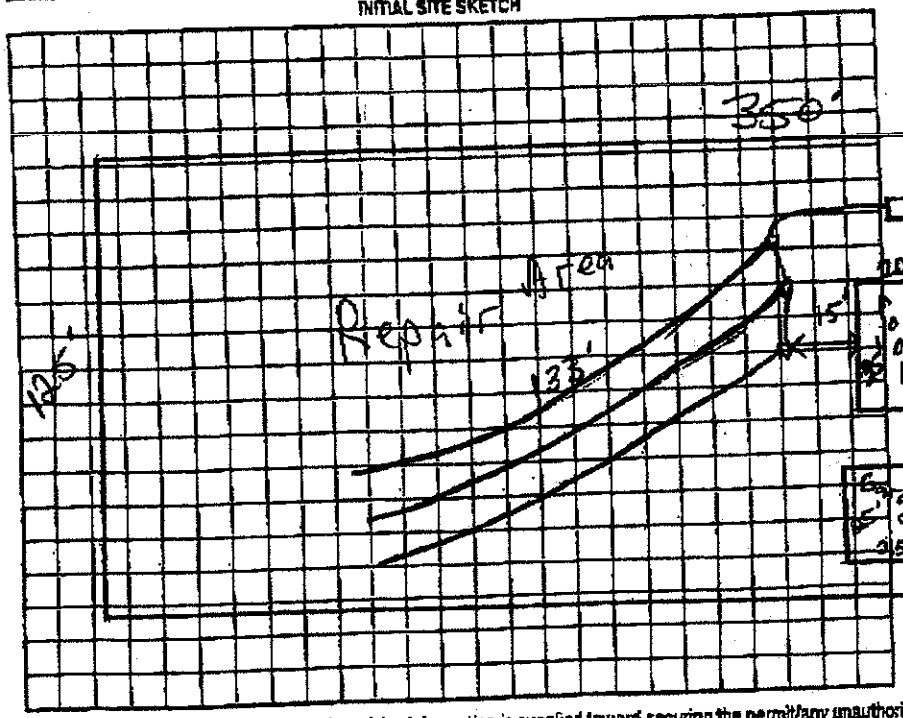

AS BUILT SKETCH

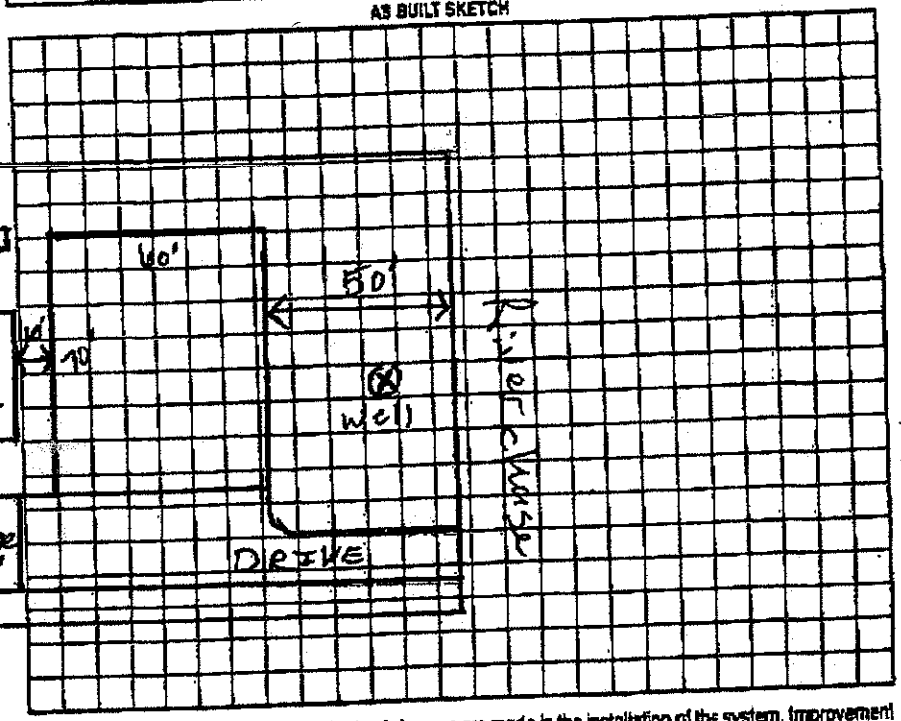

Permit can be suspended or revoked if any false information is supplied toward securing the permit/any unauthorized changes are made to the site/any unauthorized changes are made in the installation of the system. Improvement Permit with plat valid without expiration ☐ Improvement Permit with site plan valid for sixty months ☐ Authorization to Construct is valid for a period equal to that of Improvement Permit – not to exceed sixty months.

Signed: Stacy Lusk date 7-14-06 Installed by: Craig Thompson Grading

Improvement Permit by: _____ RS date 7/11/06 Operation Permit by: lpm E Ald date 5-11-07

Authorization to Construct by: _____ RS. date 10/18/06 Existing System Inspection by: _____ date _____

HEALTH DEPT. COPY: WHITE OWNER COPY (FINAL): YELLOW OWNER COPY (INITIAL): PINK