IREDELL COUNTY HEALTH DEPARTMENT

STATESVILLE 704-878-5305 MOORESVILLE 704-664-5281 COPY

IMPROVEMENT PERMIT / AUTHORIZATION TO CONSTRUCT / OPERATION PERMIT / EXISTING SYSTEM INSPECTION

PERMIT # REPAIR PIN # 4676-62-9793 DATE 3-4-11

OWNER or APPLICANT MARTIN WHITE PHONE: Business Home:

OWNER or APPLICANT ADDRESS 130 RIVERCHASE

LOCATION / DIRECTIONS 152, TEETER, WALDEN RIDGE, RIVERCHASE

SUBDIVISION WALDEN RIDGE BLOCK / SECTION LOT # 16 LOT AREA 1 AC DESIGN FLOW 720 L.T.A.R. .3

Septic Tank 1500 Gallons: STB 353 Date 9-5-10

Pump Tank Gallons: PT Date

Pump Make Model Serial #

Nitrification Field No Fields 1 No Lines 3 Linear Feet 200'

Trench Width 36" Max. Trench Bottom Depth 36" Gravel Depth

☐ New System ☒ Repair ☒ Expansion System Type I II (III) IV V VI

System Description: GRAVITY 25%

Repair System Description:

Maintenance Agreement Required ☐ YES ☒ NO

☒ GRAVITY ☐ PRESSURE

☒ Residence No. Bedrooms 6 ☐ Business No. Persons ☐ Other No. Employees ☐ Slab ☒ Crawl Space ☐ Basement w/plumbing ☐ Basement w/o plumbing


Water Supply: ☒ Private ☐ Public ☐ Community

Comments / Conditions 1) INSTALL 1500 GAL ST & 200' 25% RED.
2) MIN 10' PROP LINES & 15' FROM WATER EDGE OF POOL


Comments / Conditions TRENCHES 44" DEEP TO GET FALL

FAXED 3-4-11 -CMW 704-539-4710

INITIAL SITE SKETCH

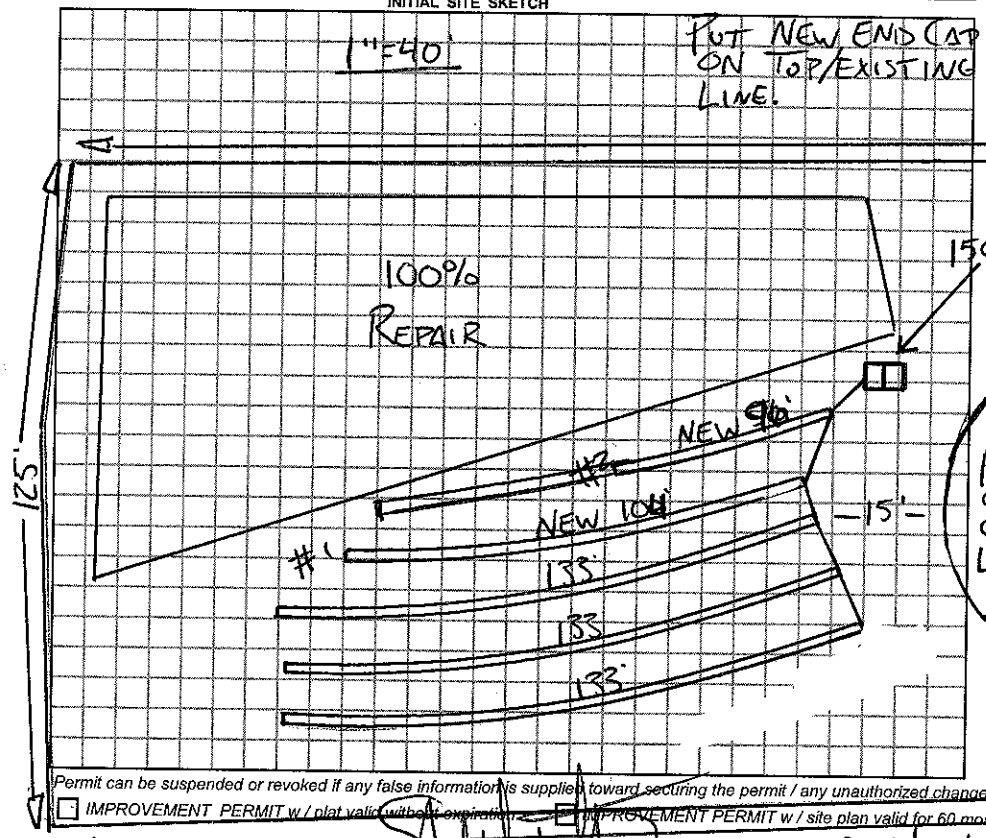

AS BUILT SKETCH

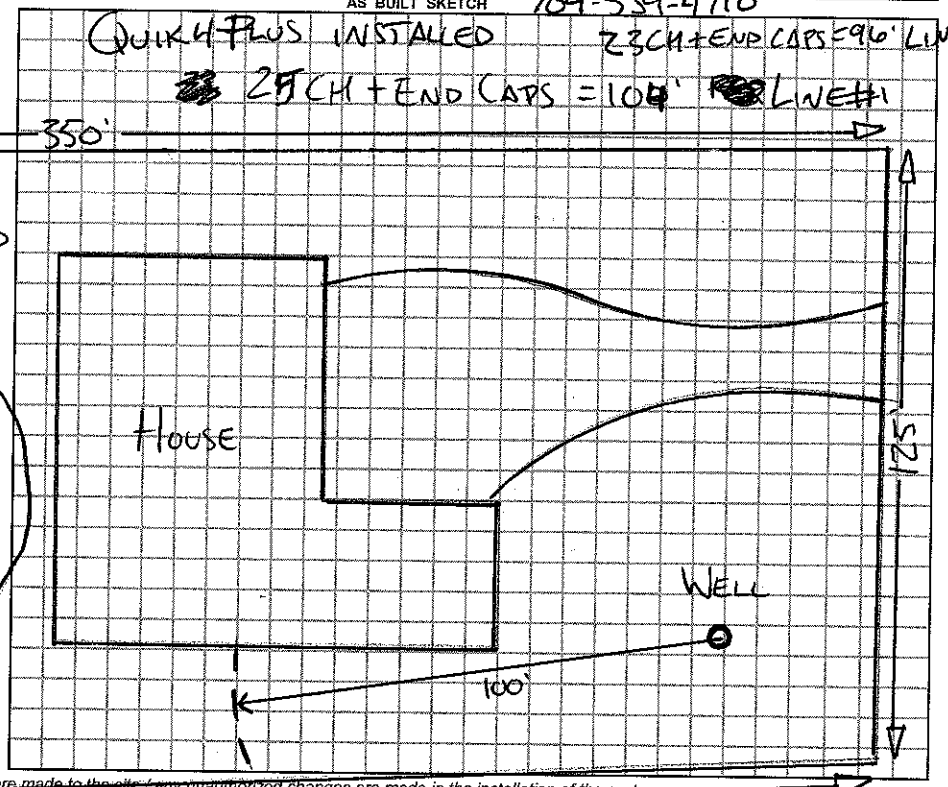

Permit can be suspended or revoked if any false information is supplied toward securing the permit / any unauthorized changes are made to the site / any unauthorized changes are made in the installation of the system.

☐ *IMPROVEMENT PERMIT w / plat valid without expiration* ☐ *IMPROVEMENT PERMIT w / site plan valid for 60 mos.* ☐ *AUTHORIZATION TO CONSTRUCT valid for period equal to IMPROVEMENT PERMIT-not to exceed 60 mo.*

Owner / Applicant Signature: Date 3-14-11

Improvement Permit by: REHS Date 3-4-11

Authorization to Construct by: REHS Date 3-4-11

YOU SHOULD CONTACT A LOCATOR SERVICE PRIOR TO ANY EXCAVATION.

Installed by: GUNTER

Operation Permit by: REHS Date: 3-14-11

Existing System Inspected by: Date:

WHITE COPY Environmental Health YELLOW COPY (Final) Owner / Applicant PINK COPY (Initial) Owner / Applicant