IREDELL COUNTY HEALTH DEPARTMENT

STATESVILLE 704-878-5305 MOORESVILLE 704-664-5281

IMPROVEMENT PERMIT / AUTHORIZATION TO CONSTRUCT / OPERATION PERMIT / EXISTING SYSTEM INSPECTION

PERMIT# 34564 PIN# 4676-30722

OWNER OR APPLICANT Iredell Group LLC PHONE: Business 704 344-5944 Home

ADDRESS 109-C Williamson Rd, Mooresville N.C. 28117 DATE April 17, 2006

LOCATION Linwood Rd. (S) to Peeler Rd. to R Walden Dr 3rd lot on Right

SUBDIVISION Walden Ridge BLOCK / SECTION LOT 4 LOT AREA 1.007ac SITE CLASS PS DESIGN FLOW 440gpd L.T.A.R. .3

Septic Tank: 1000 Gallons: ST# 312 Date 4-3-07

Pump Tank: Gallons: PT Date

Pump Make: Model Serial No.

Nitrification Field: No Fields 1 Square Feet 200 Linear Feet 400

No Lines 4 Trench Width 36" Max Trench Bottom Depth 36" Gravel Depth N/A

☒ New System ☐ Repair ☐ Expansion System Type: I II III IV V VI

System Description: 62 lin ft 25% Reduction

Repair System Description: 1 LF PPBPS

Maintenance Agreement Required: ☐ Yes ☒ No initially

☒ Gravity ☐ Pressure ☐ Slab ☒ Crawl Space ☐ Basement w/plumbing ☐ Basement wo/plumbing

☒ House/Mod. Home ☐ Mobile Home ☐ Business ☐ Other


No. Bedrooms 4 No. Persons No. Employees

Water Supply: ☒ Individual ☐ Public ☐ Community


Comments/Conditions:

Comments/Conditions:
Red Polylok Filter
Quick 4 Infiltrators installed

INITIAL SITE SKETCH

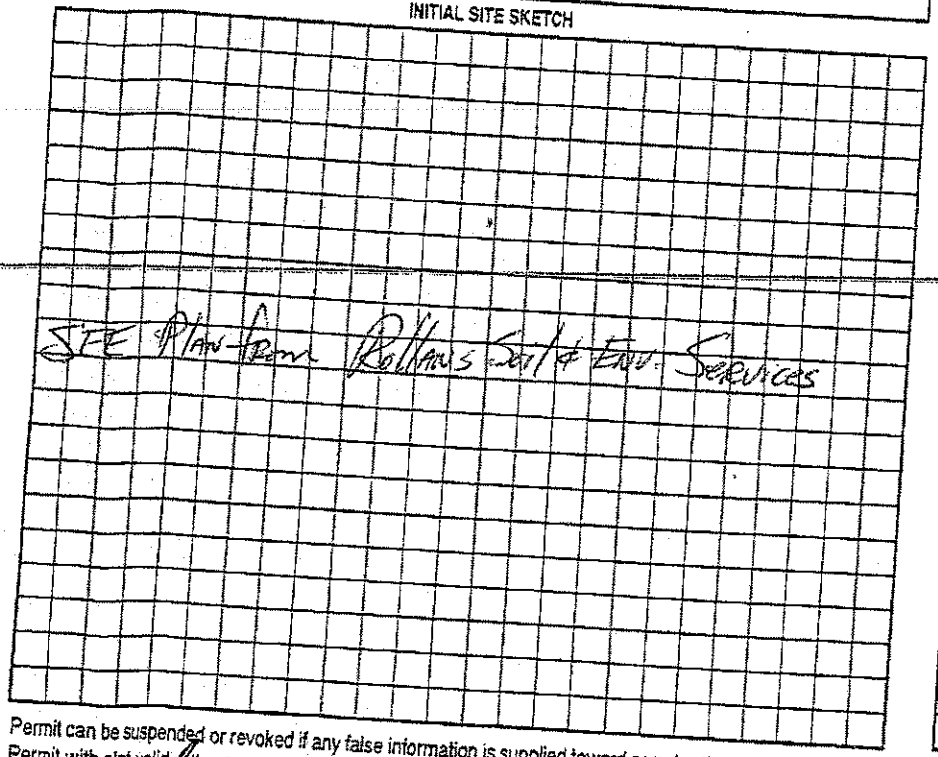

AS BUILT SKETCH

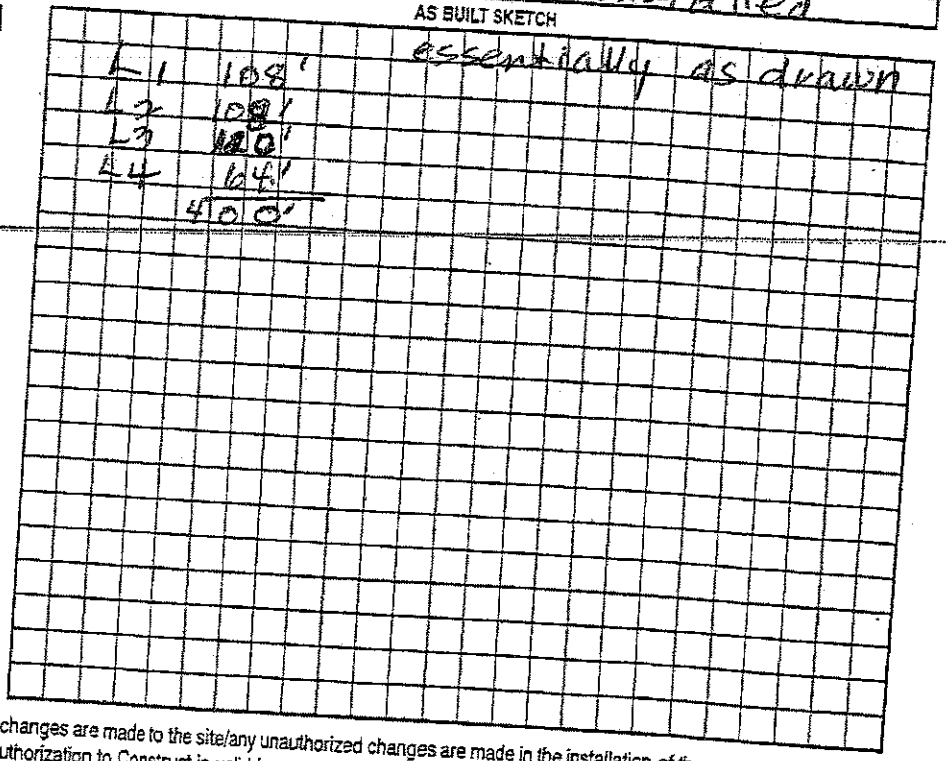

Permit can be suspended or revoked if any false information is supplied toward securing the permit/any unauthorized changes are made to the site/any unauthorized changes are made in the installation of the system. Improvement Permit with plat valid without expiration. ☐ Improvement Permit with site plan valid for sixty months ☒ Authorization to Construct is valid for a period equal to that of Improvement Permit – not to exceed sixty months.


Signed: Martin Rollins

Improvement Permit by: date 4-24-06 Installed by: Sid Gaskins Water Mngmt

Authorization to Construct by: Judy Mcneill date 4-17-06 Operation Permit by: Judy Mcneill date 2-23-07

Existing System Inspection by: date 5-11-07

HEALTH DEPT. COPY: WHITE OWNER COPY (FINAL): YELLOW OWNER COPY (INITIAL): PINK

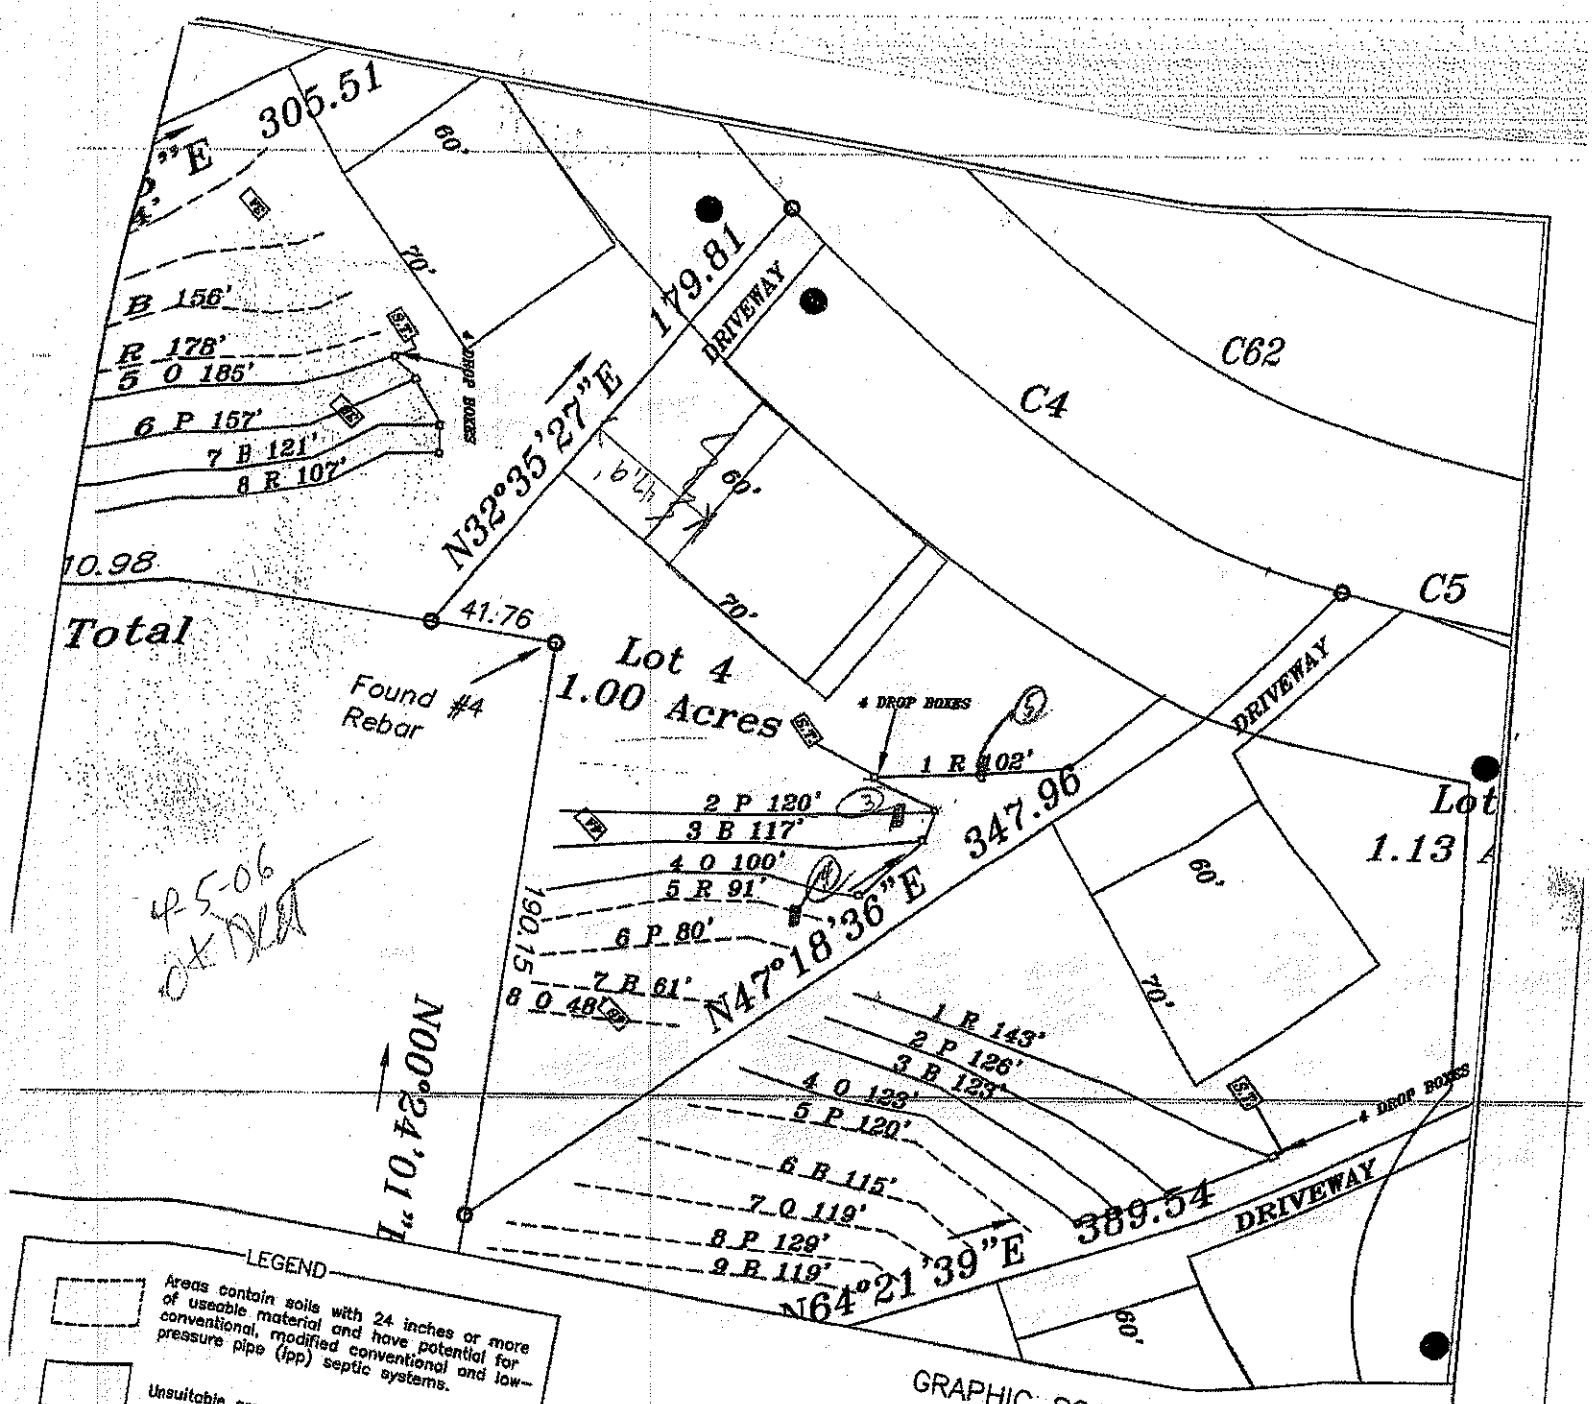

4-5-06
OK DLH

LEGEND

Areas contain soils with 24 inches or more of useable material and have potential for conventional, modified conventional and low-pressure pipe (lpp) septic systems.

Unsuitable areas.

System lines.

Repair lines.

Temporary Bench Mark (TBM)

Well Location.

GRAPHIC SCALE
1" = 60'

60 0 60 120

FOR PRELIMINARY PLANNING PURPOSES ONLY. ALL LOTS WILL REQUIRE FINAL APPROVAL BY THE COUNTY HEALTH DEPARTMENT ON A LOT BY LOT BASIS. THIS MAP SHOULD BY USED AS A GENERAL GUIDE, SOME ADJUSTMENTS WILL BE NECESSARY IN THE FIELD DUE TO SOIL VARIABILITY AND COMPLEX TOPOGRAPHIC FEATURES. THIS MAP ONLY REFLECTS EXISTING SOIL SUITABILITY FOR ON-SITE SEPTIC TANK SYSTEMS.

PLEASE REFER TO ATTACHED SOIL REPORT FOR ADDITIONAL SITE SPECIFIC INFORMATION

ANS SOIL & ENVIRONMENTAL SERVICES
ROAD
NC 28125
(4) 278 - (989
ASHLEY ROLLANS, NC LICENSED SOIL SCIENTIST
MOBILE: (704) 746 - 5045
EMAIL: ROLLANSFORTC@AOL.COM

MAP TITLED: SITE PLAN & DRAINFIELD AREAS



JOB # : 01-1069
FILE: C:\JOBS\01-1069
PROJECT MGR.: CBF
FIELD WORK: CBF AND AP
DRAWN BY: CBF AND AP