IREDELL COUNTY HEALTH DEPARTMENT


ENVIRONMENTAL HEALTH DIVISION

PAGE 2: ***SITE PLAN WORKSHEET***

SEE THE "SAMPLE SITE PLAN" BELOW. ***INCOMPLETE SITE PLANS WILL BE RETURNED TO YOU FOR COMPLETION AND MAY RESULT IN A DELAY IN THE ISSUANCE OF YOUR SEPTIC SYSTEM PERMIT!!!***

Place an (X) beside each item as you complete the site plan:

- ( ) Property Line measurements are clearly identified
- ( ) All proposed structures are indicated
- ( ) Front and side setbacks from property line
- ( ) Preferred driveway location and well location
- ( ) Area you prefer your septic system to be placed
- ( ) North arrow, or other sufficient indicator of direction

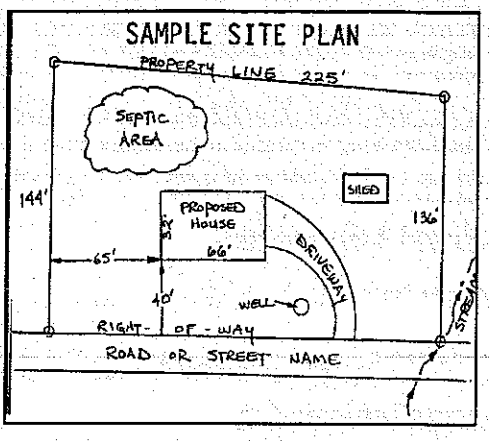


Circle N/A on the following if appropriate:

Location of septic systems and wells within 100' of your property	N/A
Location of easements and rights of ways on your property	N/A
Location of any designated wetlands on the property	N/A


USE THIS SPACE TO DRAW YOUR SITE PLAN

Show: proposed house or business footprint, wells, water lines, patios, pools and decks, and any other item that will occupy space on the site

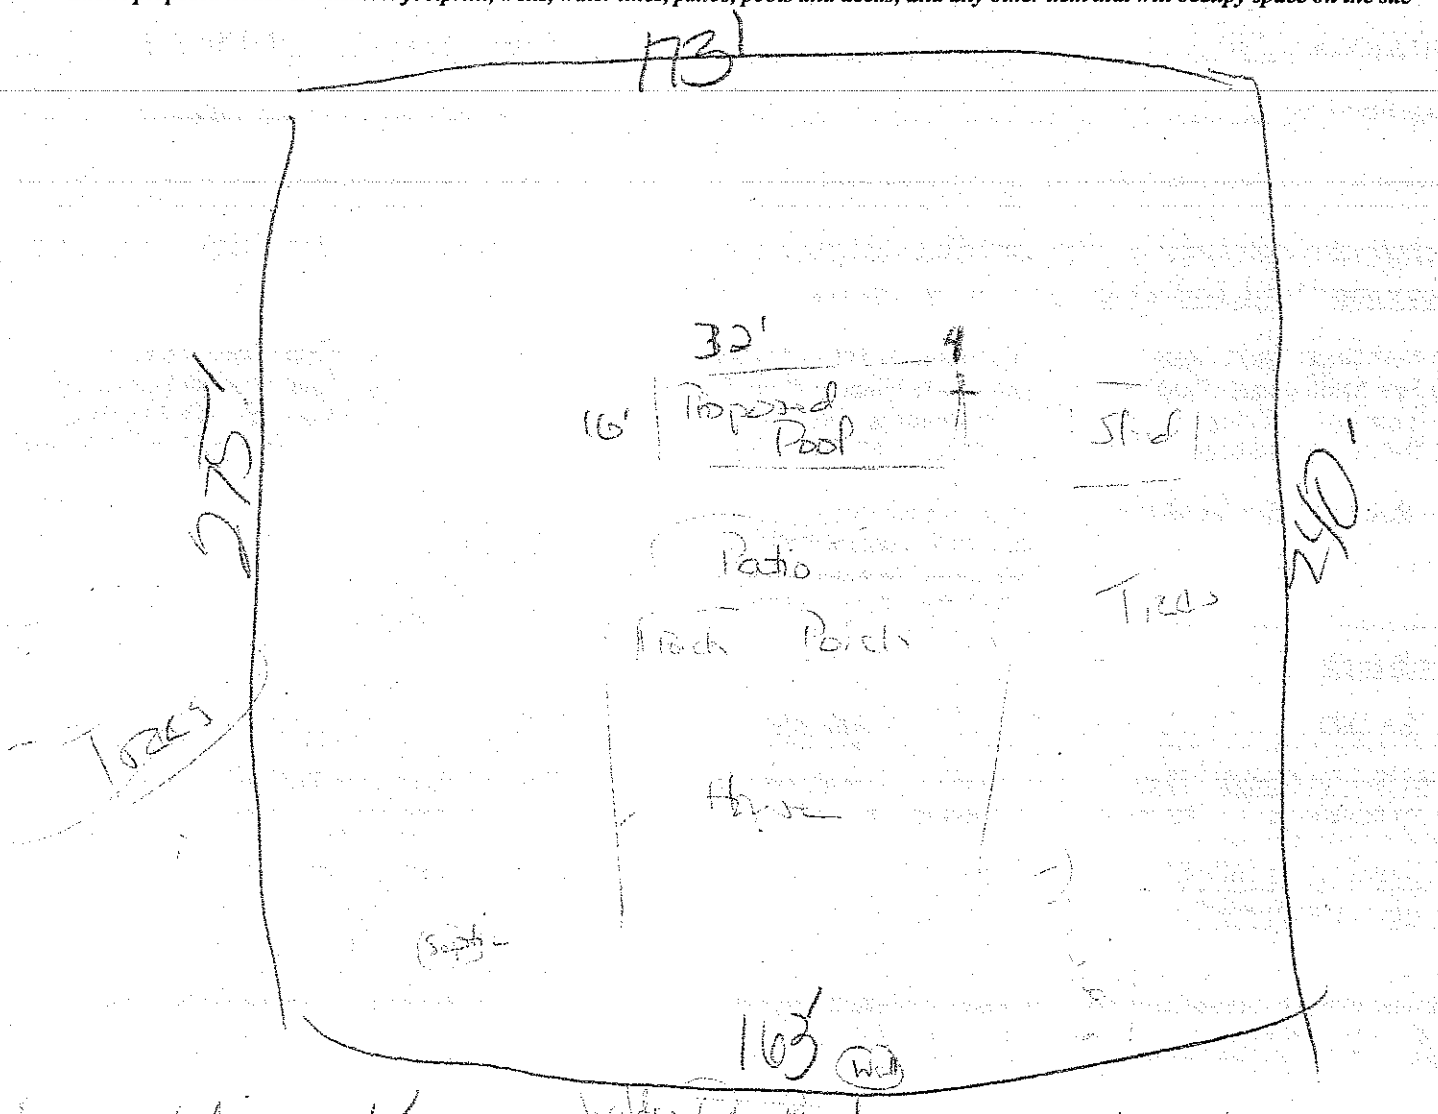

Signature: _____ 6/29/2015

Property owner or owner's legal representative signature (SIGNATURE REQUIRED) — DATE

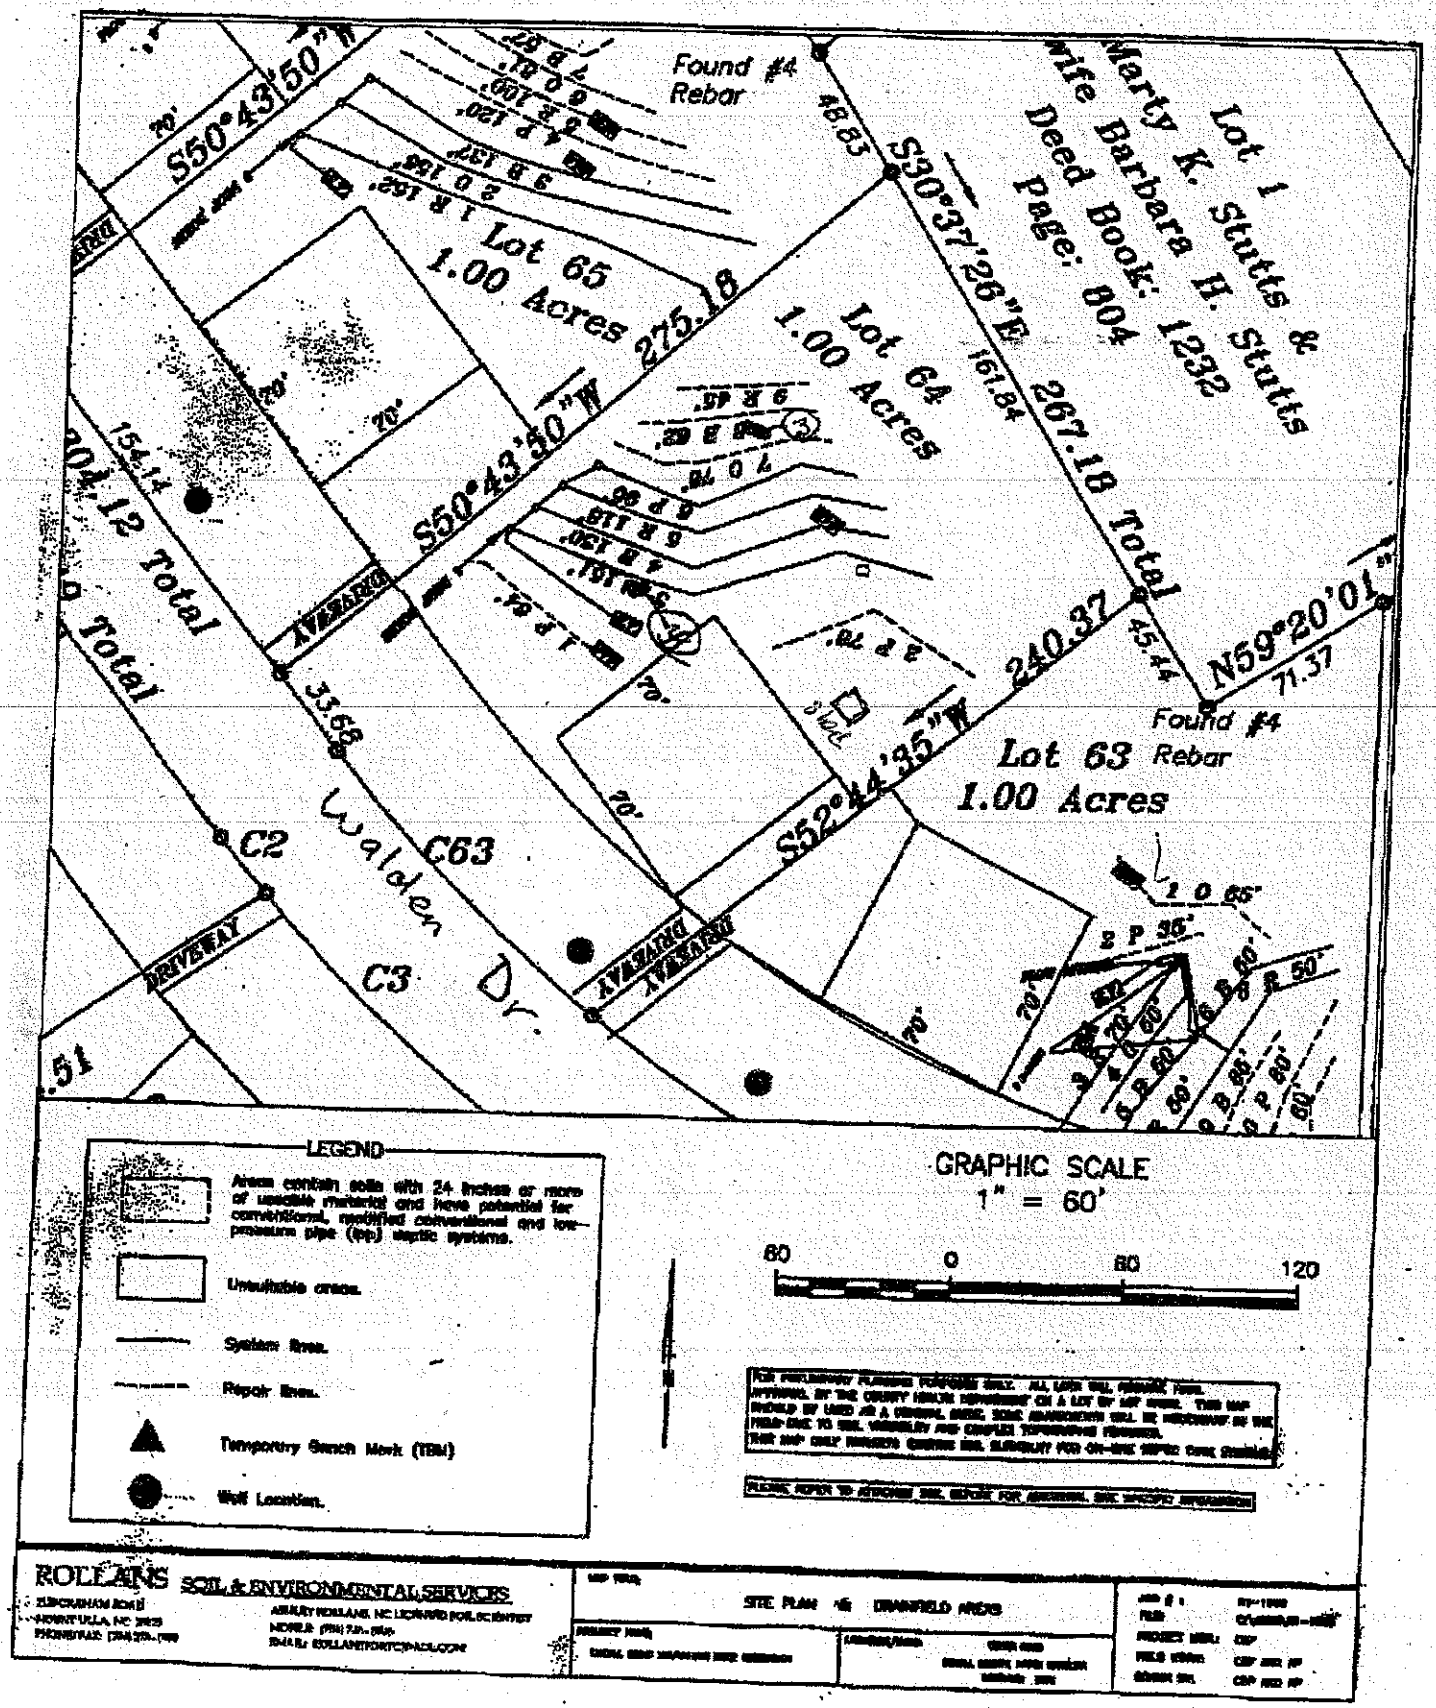
Found #4 Rebar
S50°43'50"W
Lot 65
1.00 Acres
275.18
S50°43'50"W
Lot 64
1.00 Acres
S30°37'26"E
267.18 Total
161.84
46.83
Marty K. Stutts & wife Barbara H. Stutts
Deed Book: 1232
Page: 804
Lot 1
N59°20'01"
71.37
45.44
240.32
S52°44'35"W
Found #4 Rebar
Lot 63
1.00 Acres
154.14
204.12 Total
33.68
Walden Dr.
C2
C63
C3
DRIVEWAY
70'
20'
LEGEND
Areas contain soils with 24 inches or more of useable material and have potential for conventional, modified conventional and low-pressure pipe (lpp) septic systems.
Unsuitable areas.
System lines.
Repair lines.
Temporary Bench Mark (TBM)
Well Location.
GRAPHIC SCALE
1" = 60'
60 0 60 120
ROLLANS SOIL & ENVIRONMENTAL SERVICES
SITE PLAN - 46 DRAINFIELD AREAS

Marcia 704 664 3739

Graylyn 794-6686

IREDELL COUNTY HEALTH DEPARTMENT

STATESVILLE 704-878-5305 MOORESVILLE 704-664-5281

IMPROVEMENT PERMIT / AUTHORIZATION TO CONSTRUCT / OPERATION PERMIT / EXISTING SYSTEM INSPECTION

PERMIT# 134629 PIN# 4676 63 0556.4 DATE April 19, 2006

OWNER OR APPLICANT Charles Thrapile Jonas, NC 27

ADDRESS 109 Wilkinson Rd. Mooresville N.C. 28117 PHONE: Business 704 394-5994 Home

LOCATION Longwood Rd. (S) TL Teeter Rd. TR Walden Dr. 3rd Lot on left

SUBDIVISION Walden Ridge BLOCK / SECTION LOT 64 LOT AREA 1Ac SITE CLASS. PS1 DESIGN FLOW 4 bdrm L.T.A.R. .25

Septic Tank: 1000 Gallons: STS 825 Date 10/23/06

Pump Tank: Gallons: PT Date

Pump Make: Model Serial No.

Nitrification Field: No Fields 1 Square Feet 1440 Linear Feet 480

No Lines 4 Trench Width 36" Max Trench Bottom Depth 36" Gravel Depth 12"

☒ New System ☐ Repair ☐ Expansion System Type: I II III IV V VI

System Description: Conv. 25% Reduction

Repair System Description: LPP825

Maintenance Agreement Required: ☐ Yes ☒ No initially

☒ House/Mod. Home ☐ Mobile Home ☐ Business ☐ Other

No. Bedrooms 4 No. Persons No. Employees

Water Supply: ☒ Individual ☐ Public ☐ Community

☒ Gravity ☐ Pressure ☐ Slab ☒ Crawl Space ☐ Basement w/plumbing ☐ Basement w/o plumbing

Comments/Conditions: 10/31/07 Reviewed Floor plans. Essentially in Compliance with original permit

Comments/Conditions: 4" Installed 5X120' lines move to front left corner of Lot

INITIAL SITE SKETCH

SEE Plan from Rollins Soil & Env. Services

Blue Print AS BUILT SKETCH

Permit can be suspended or revoked if any false information is supplied toward securing the permit/any unauthorized changes are made to the site/any unauthorized changes are made in the installation of the system. Improvement Permit with plat valid without expiration ☐ Improvement Permit with site plan valid for sixty months ☒ Authorization to Construct is valid for a period equal to that of Improvement Permit – not to exceed sixty months.

Signed: Thomas Bush, Jr. date 4-19-06

Improvement Permit by: [illegible] date 4-19-06

Authorization to Construct by: [illegible] date 10/3/07

Installed by: Rowan

Operation Permit by: Tom Moore date 7/08/08

Existing System Inspection by: date

HEALTH DEPT. COPY: WHITE OWNER COPY (FINAL): YELLOW OWNER COPY (INITIAL): PINK

704 664 3739

PAGE 01/02
704-664-3739
JUN 19 2008 08:22