IREDELL COUNTY HEALTH DEPARTMENT

STATESVILLE 704-878-5305 MOORESVILLE 704-664-5281

IMPROVEMENT PERMIT / AUTHORIZATION TO CONSTRUCT / OPERATION PERMIT / EXISTING SYSTEM INSPECTION

PERMIT# 092494 PIN# ~~4676 63 2885 P7~~ 4676 63 0899 DATE 10/27/00

OWNER OR CONTRACTOR Marty Stutts PHONE: Business 872-8422 Home

ADDRESS 109 Wayne Dr. Statesville, NC. 28677

LOCATION 1365 TL Wellford TR Linwood Rd. TL Teeter Rd. ~ .6 mile on (R)

SUBDIVISION No BLOCK / SECTION LOT No LOT AREA ~ 1.0 Ac SITE CLASS. PS DESIGN FLOW 600 L.T.A.R. .3

Septic Tank: 1500 Gallons; STB 1012 Date 6/26/00

Pump Tank: Gallons; PT Date

Pump Make: Model 1999 Serial No. 466

Nitrification Field: No Fields 1 Square Feet ~~1500~~ Linear Feet ~~508~~

No Lines 5@164' Trench Width 3' Max Trench Bottom Depth 3' ~~Gravel Depth~~ 12"

[X] New System [ ] Repair System Type: I (II) III, IV, V, VI

System Description: CONVENTIONAL

Repair System Description: SAME

Maintenance Agreement Required: [ ] Yes [ ] No

[X] House/Mod. Home No. Bedrooms 5

[ ] Mobile Home No. Bathrooms 3

[ ] Business No. Employees

[ ] Other


[ ] Slab [ ] Crawl Space [ ] Basement w/plumbing [ ] Basement wo/plumbing

Water Supply: [ ] Individual [ ] Public [ ] Community


Comments:/Conditions:

Comments:/Conditions:

INITIAL SITE SKETCH

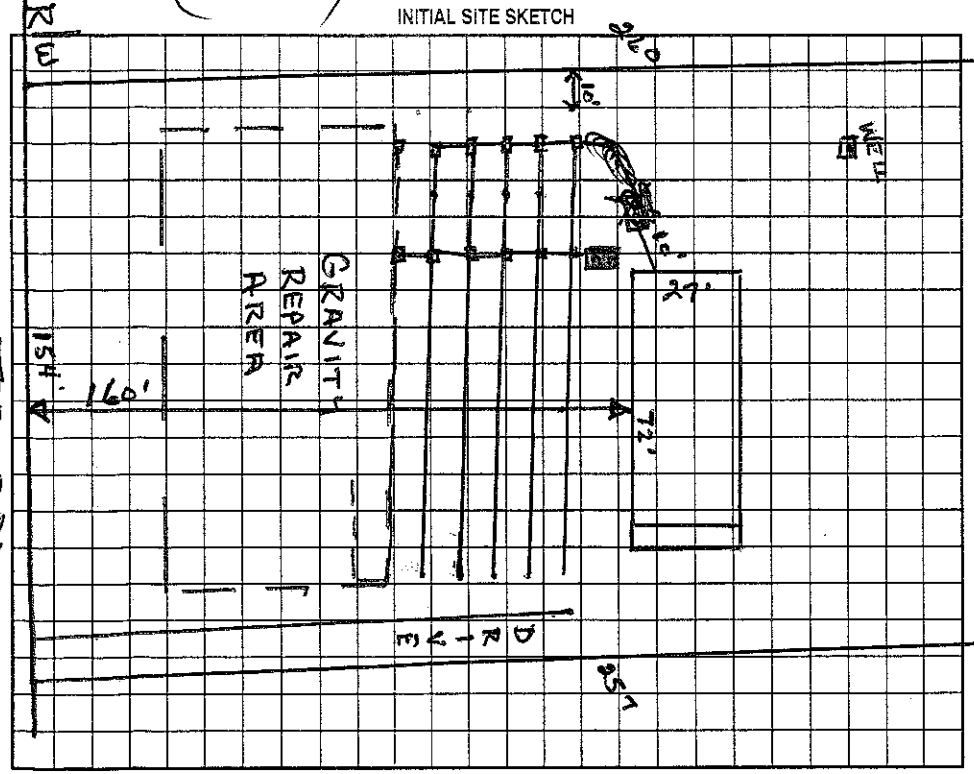

AS BUILT SKETCH

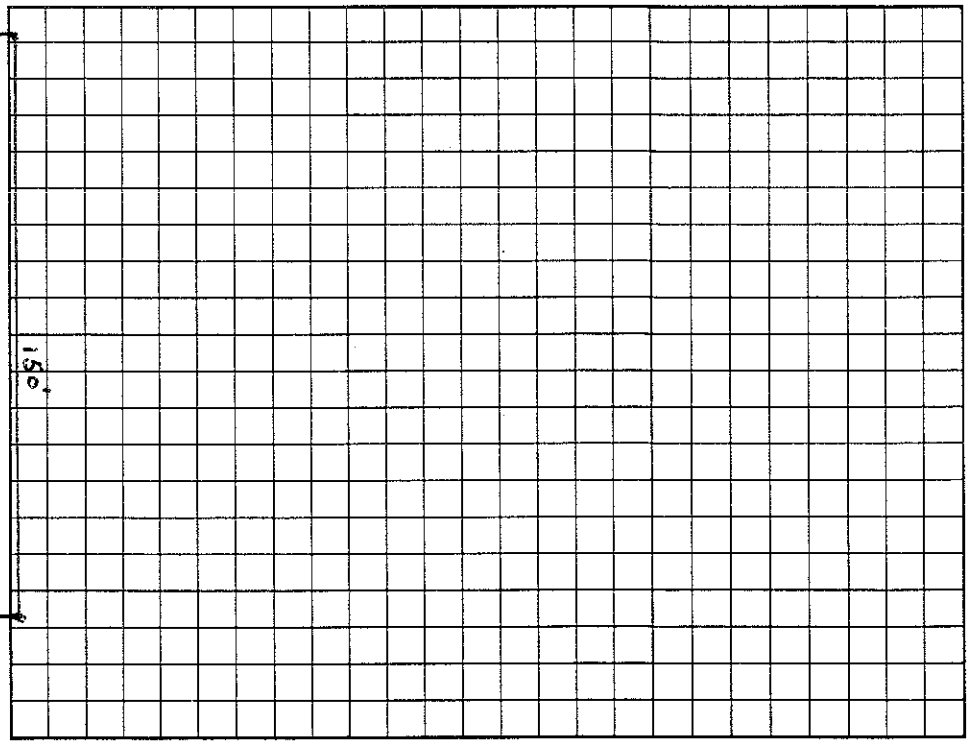

Permit can be suspended or revoked if any false information is supplied toward securing the permit/any unauthorized changes are made to the site/any unauthorized changes are made in the installation of the system. Improvement Permit with plat valid without expiration. Improvement Permit with site plan valid for sixty months. Authorization to Construct is valid for a period equal to that of Improvement Permit – not to exceed sixty months.

Signed: X Mary Stutts date 10-30-00 Installed by: A-1 Backhoe

Improvement Permit by: Wesley Sparks RS. date 10/27/00 Operation Permit by: Wesley Sparks RS date 11/8/00

Authorization to Construct by: Wesley Sparks RS date 10/27/00 Existing System Inspection by: date

HEALTH DEPT. COPY: WHITE OWNER COPY (FINAL): YELLOW OWNER COPY (INITIAL): PINK