Site Address: 157 Halden Ridge Dr. - Mrvl. 28115 [redacted] 2130

IREDELL COUNTY HEALTH DEPARTMENT

STATESVILLE 704-878-5305 MOORESVILLE 704-664-5281

IMPROVEMENT PERMIT / AUTHORIZATION TO CONSTRUCT / OPERATION PERMIT / EXISTING SYSTEM INSPECTION

PERMIT# 134625 PIN# 4676 63 5592 DATE April 19, 2006

OWNER OR APPLICANT Crabtree Group LLC Donald Seager PHONE: Business 704 344-5944 Home

ADDRESS 109-C Williamson Rd, Mooresville, N.C. 28117

LOCATION Finnyard Rd (S) TL Teeter Rd. TR Walden Dr. on left

SUBDIVISION Walden Ridge BLOCK / SECTION - LOT 60 LOT AREA 1.03 ac SITE CLASS. B DESIGN FLOW 440 gpd L.T.A.R. 0.25

Septic Tank: 1000 Gallons: STB 825 Date 11-4-05

Pump Tank: Gallons: PT Date

Pump Make: Model Serial No.

Nitrification Field: No Fields 1 Square Feet 1440 Linear Feet 480

No Lines 4 Trench Width 36" Max Trench Bottom Depth 36"

☒ New System ☐ Repair ☐ Expansion System Type: I II III IV V VI

System Description: Gravity 25% Reduction

Repair System Description: LPPBRS

Maintenance Agreement Required: ☐ Yes ☒ No

Gravel Depth NA ☒ Gravity ☐ Pressure

☒ House/Mod. Home No. Bedrooms 4

☐ Mobile Home No. Persons

☐ Business No. Employees

☐ Other

Water Supply: ☒ Individual ☐ Public ☐ Community

☐ Slab ☒ Crawl Space ☐ Basement w/plumbing ☐ Basement wo/plumbing

Comments:/Conditions:

Comments:/Conditions:

INITIAL SITE SKETCH

SEE Plan from Rollins Soil & Env. Services

AS BUILT SKETCH

Installed Quick 4 for Drainfield (Installed essentially as drawn

Permit can be suspended or revoked if any false information is supplied toward securing the permit/any unauthorized changes are made to the site/any unauthorized changes are made in the installation of the system. Improvement Permit with plat valid without expiration ☐ Improvement Permit with site plan valid for sixty months ☒ Authorization to Construct is valid for a period equal to that of Improvement Permit – not to exceed sixty months.

Signed: [signature] date 4-24-06

Improvement Permit by: [signature] date 4-19-06


Authorization to Construct by: [signature] date 6/11/07

Installed by: Bostian Backhoe & Septic

Operation Permit by: [signature] date 1/14/09

Existing System Inspection by: date

HEALTH DEPT. COPY: WHITE OWNER COPY (FINAL): YELLOW OWNER COPY (INITIAL): PINK

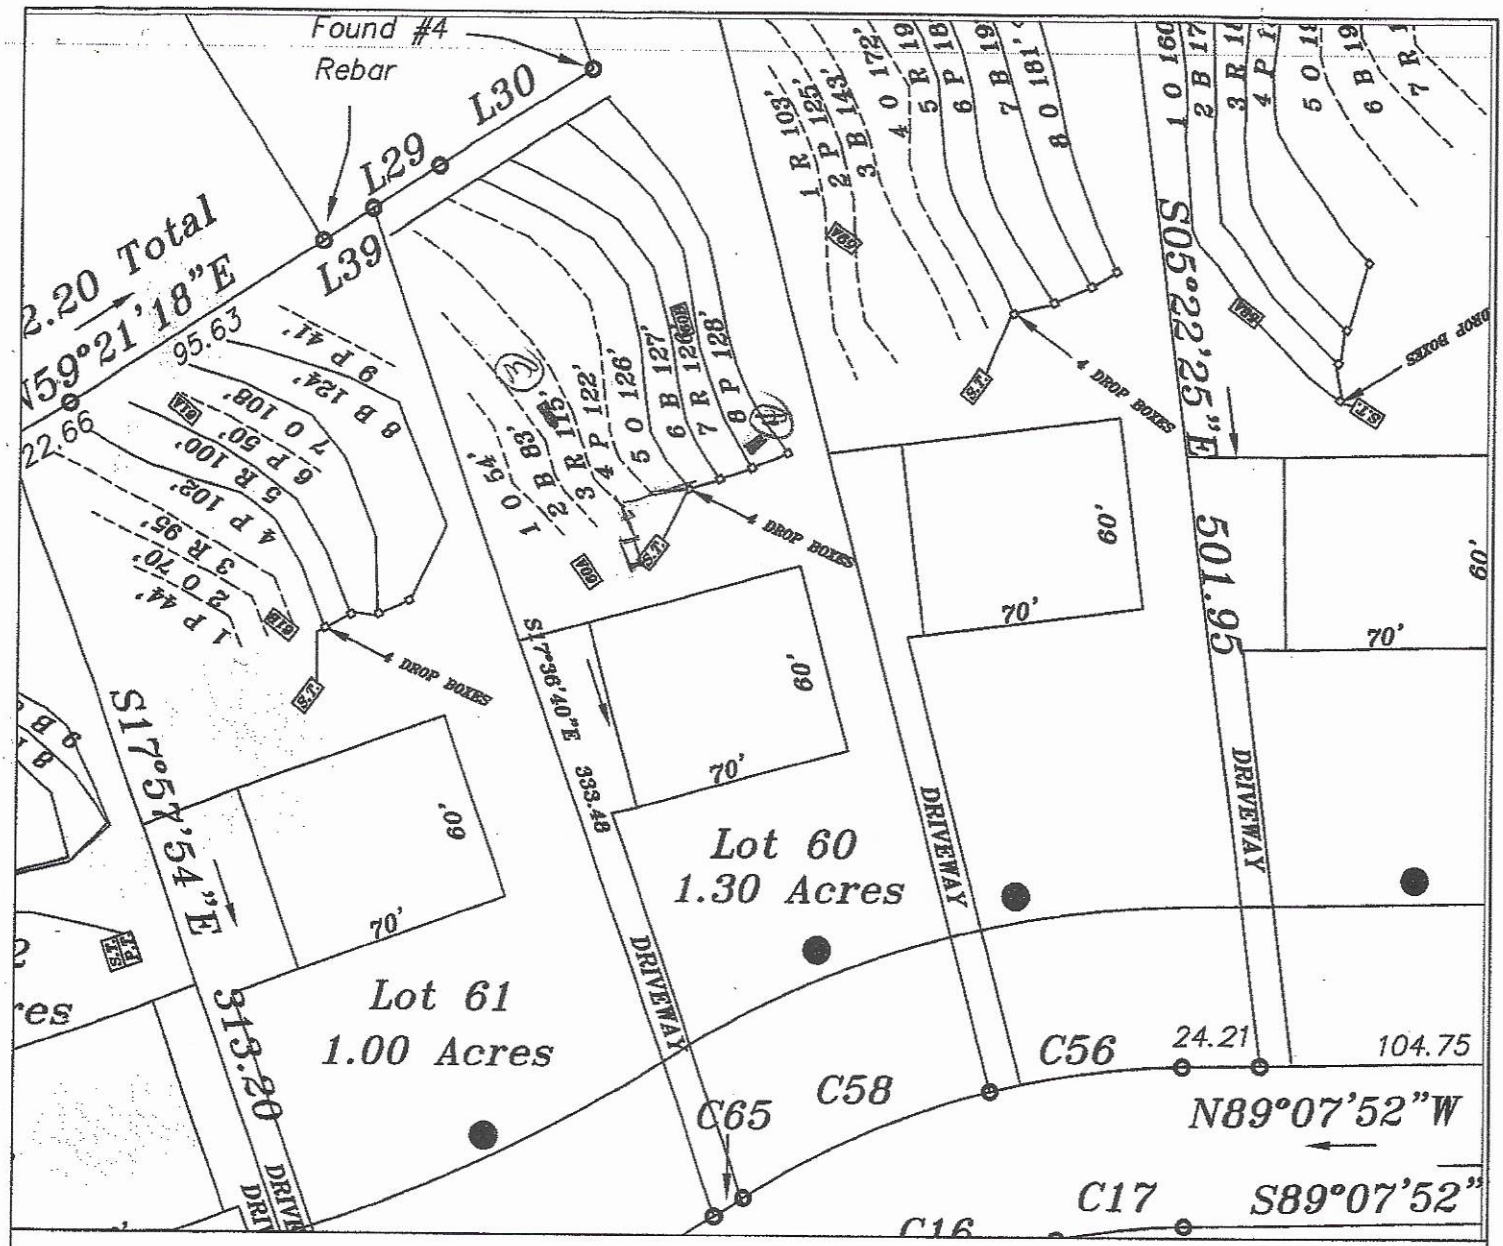

LEGEND

- Areas contain soils with 24 inches or more of useable material and have potential for conventional, modified conventional and low-pressure pipe (lpp) septic systems.
- Unsuitable areas.
- System lines.
- Repair lines.
- Temporary Bench Mark (TBM)
- Well Location.

GRAPHIC SCALE
1" = 60'

60 0 60 120

FOR PRELIMINARY PLANNING PURPOSES ONLY. ALL LOTS WILL REQUIRE FINAL APPROVAL BY THE COUNTY HEALTH DEPARTMENT ON A LOT BY LOT BASIS. THIS MAP SHOULD BY USED AS A GENERAL GUIDE, SOME ADJUSTMENTS WILL BE NECESSARY IN THE FIELD DUE TO SOIL VARIABILITY AND COMPLEX TOPOGRAPHIC FEATURES. THIS MAP ONLY REFLECTS EXISTING SOIL SUITABILITY FOR ON-SITE SEPTIC TANK SYSTEMS.

PLEASE REFER TO ATTACHED SOIL REPORT FOR ADDITIONAL SITE SPECIFIC INFORMATION

ROLLANS SOIL & ENVIRONMENTAL SERVICES
2120 GRAHAM ROAD
MOUNT ULLA, NC 28125
PHONE/FAX: (704) 278-0989
ASHLEY ROLLANS, NC LICENSED SOIL SCIENTIST
MOBILE: (704) 746-5046
EMAIL: ROLLANSFORTCJ@AOL.COM

MAP TITLE: SITE PLAN & DRAINFIELD AREAS

PROJECT NAME: WEDELL GROUP LLC/WILDEN RIDGE SUBDIVISION

LOCATION/DATE: TEETER ROAD, IREDELL COUNTY, NORTH CAROLINA, DECEMBER 2005

JOB # : 01-1069
FILE: C:\JOBS\01-1069
PROJECT MGR.: CBF
FIELD WORK: CBF AND AP
DRAWN BY: CBP AND AP