IREDELL COUNTY HEALTH DEPARTMENT

STATESVILLE 704-878-5305 MOORESVILLE 704-664-5281

IMPROVEMENT PERMIT / AUTHORIZATION TO CONSTRUCT / OPERATION PERMIT / EXISTING SYSTEM INSPECTION

PERMIT # _____ PIN # 4676-63-8180 DATE 11-29-10

OWNER or APPLICANT SUPERIOR POOLS PHONE: Business 704-615-8546 Home: _____

OWNER or APPLICANT ADDRESS 112 RIVERCHASE RD

LOCATION / DIRECTIONS 152 TEETER, WALDEN, RIVERCHASE

SUBDIVISION WALDEN RIDGE BLOCK / SECTION _____ LOT # 13 LOT AREA 1 AC DESIGN FLOW 480GPD L.T.A.R. .25/.125R

Septic Tank Ex. 1000 Gallons: STB 794 Date 9-5-06

Pump Tank Ex. 1000 Gallons: PT _____ Date 6-7-06

Pump Make Ex. GOULDS Model DE41M Serial # _____

Nitrification Field No Fields _____ No Lines _____ Linear Feet _____

Trench Width _____ Max. Trench Bottom Depth NG Gravel Depth _____

☐ New System ☐ Repair ☐ Expansion System Type I II (III) IV V VI

System Description: PM- 25% REDUCTION

Repair System Description: LPP

Maintenance Agreement Required ☐ YES ☒ NO

☐ GRAVITY ☒ PRESSURE

☐ Residence No. Bedrooms 4

☐ Business No. Persons _____

☒ Other No. Employees _____

☐ Slab ☒ Crawl Space


☐ Basement w/plumbing ☐ Basement w/o plumbing

Water Supply: ☒ Private ☐ Public ☐ Community


Comments / Conditions: POOL MUST BE MIN 15' FROM ANY PART OF SEPTIC SYSTEM

Comments / Conditions: POOL

INITIAL SITE SKETCH

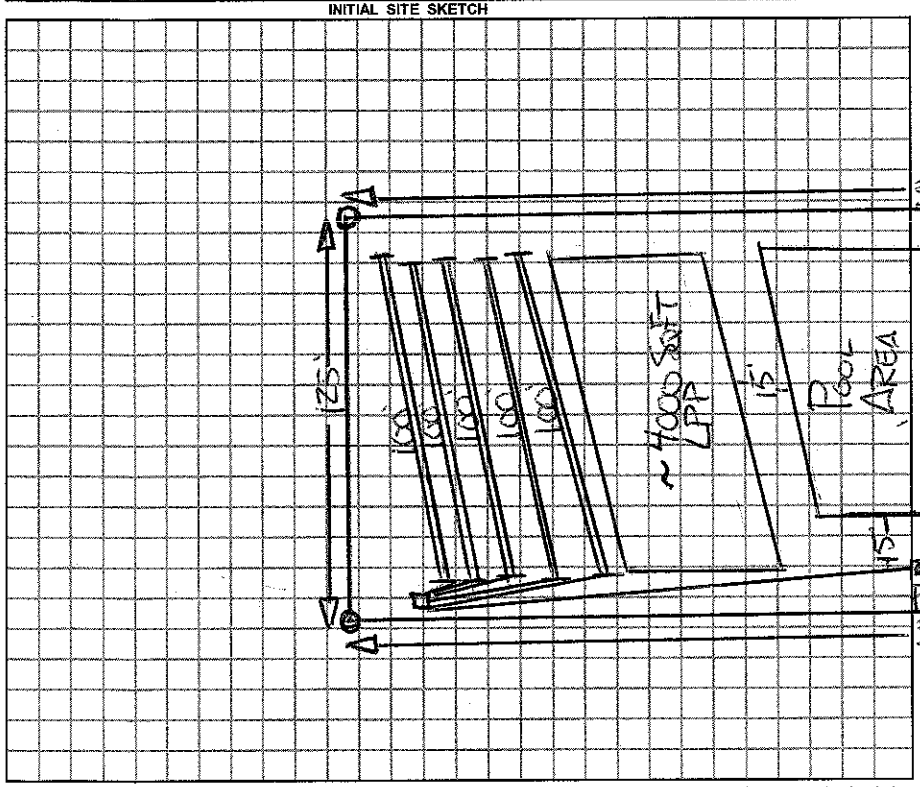

AS BUILT SKETCH

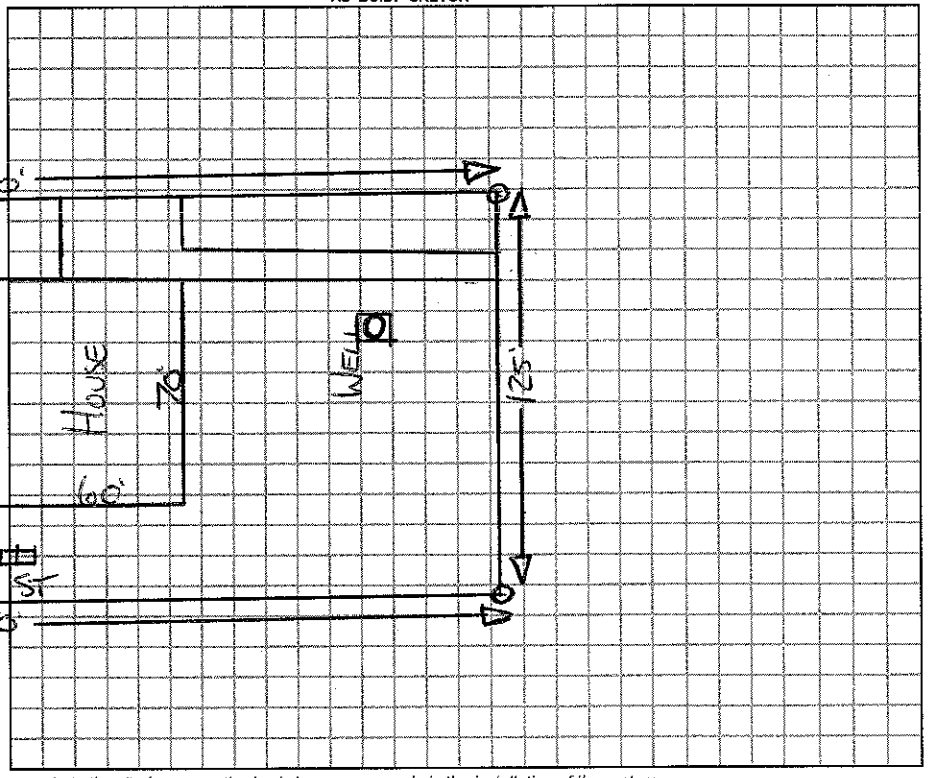

Permit can be suspended or revoked if any false information is supplied toward securing the permit / any unauthorized changes are made to the site / any unauthorized changes are made in the installation of the system.

☐ *IMPROVEMENT PERMIT w / plat valid without expiration.* ☐ *IMPROVEMENT PERMIT w / site plan valid for 60 mos.* ☐ *AUTHORIZATION TO CONSTRUCT valid for period equal to IMPROVEMENT PERMIT-not to exceed 60 mo.*

Owner / Applicant Signature: _____ Date 12-3-10 Installed by: _____

Improvement Permit by: _____ Date _____ Operation Permit by: _____ Date: _____

Authorzation to Construct by: _____ Date _____ Existing System Inspected by: _____ REHS Date: 11-29-10

YOU SHOULD CONTACT A LOCATOR SERVICE PRIOR TO ANY EXCAVATION.

WHITE COPY Environmental Health YELLOW COPY (Final) Owner / Applicant PINK COPY (Initial) Owner / Applicant

IREDELL COUNTY HEALTH DEPARTMENT

STATESVILLE 704-878-5305 MOORESVILLE 704-664-5281

IMPROVEMENT PERMIT / AUTHORIZATION TO CONSTRUCT / OPERATION PERMIT / EXISTING SYSTEM INSPECTION

PERMIT# 134600 PIN# 4676 03 8180 DATE 10/4/06

OWNER OR APPLICANT Mid-Atlantic Bldrs - Ray Short PHONE: Business _____ Home _____

ADDRESS _____

LOCATION _____

SUBDIVISION Walden Ridge BLOCK / SECTION _____ LOT 13 LOT AREA 1.00 Ac SITE CLASS. PS DESIGN FLOW 480 gpd L.T.A.R. .25 initial/.125 Repair

Septic Tank: 1000 Gallons: STB 799 Date 9-5-06

Pump Tank: 1000 Gallons: PT ~~750~~ Date 6-7-06

Pump Make: Gatlds Model DE41M Serial No. _____

Nitrification Field: No. Fields 1 Square Feet 1500 Linear Feet 300

No. Lines 5@100 Trench Width 30 Max Trench Bottom Depth 30

☒ New System ☐ Repair ☐ Expansion System Type: I II III IV V VI

System Description: PM-25% Reduction

Repair System Description: LPP

Maintenance Agreement Required: ☐ Yes ☒ No

☒ House/Mod. Home ☐ Mobile Home ☐ Business ☐ Other

No. Bedrooms 4 No. Persons _____ No. Employees _____

Water Supply: ☒ Individual ☐ Public ☐ Community

☐ Gravity ☒ Pressure ☐ Slab ☒ Crawl Space ☐ Basement w/plumbing ☐ Basement wo/plumbing

Comments/Conditions:

Redraw Permit

Paid $100 (Ray Short)

Comments/Conditions:

INITIAL SITE SKETCH

See New Plans on attached Sheet from Rollins Soil & Env Services

AS BUILT SKETCH

- added one line (100') to achieve length for 25% Red.
- New L.O. w/ Rollins on 10/3/06

Permit can be suspended or revoked if any false information is supplied toward securing the permit/any unauthorized changes are made to the site/any unauthorized changes are made in the installation of the system. Improvement Permit with plat valid without expiration. ☐ Improvement Permit with site plan valid for sixty months ☒ Authorization to Construct is valid for a period equal to that of Improvement Permit – not to exceed sixty months.

Signed: _____ date _____

Improvement Permit by: Jph E Anglin date 10/4/06

Authorization to Construct by: Jph E Anglin date 10/4/06

Installed by: Howards Backhoe

Operation Permit by: Jph E Anglin date 10/11/06

Existing System Inspection by: _____ date _____