COPY] ~~250~~

IREDELL COUNTY HEALTH DEPARTMENT

STATESVILLE 704-878-5305 MOORESVILLE 704-664-5281

IMPROVEMENT PERMIT / AUTHORIZATION TO CONSTRUCT / OPERATION PERMIT / EXISTING SYSTEM INSPECTION

PERMIT# 134600 PIN# 4676 03 8180 DATE 10/4/06

OWNER OR APPLICANT Mid-Atlantic Bldrs - Ray Short PHONE: Business _____ Home _____

ADDRESS _____

LOCATION _____

SUBDIVISION Walden Ridge BLOCK / SECTION _____ LOT 13 LOT AREA 1.00 Ac SITE CLASS. PS DESIGN FLOW 480 gpd L.T.A.R. .25 initial / .125 Repair

Septic Tank: 1000 Gallons: STB 794 Date 9-5-06
Pump Tank: 1000 Gallons: PT ~~794~~ Date 6-7-06
Pump Make: Golds Model DE4IM Serial No. _____
Nitrification Field: No. Fields 1 Square Feet 1500 Linear Feet 300
No. Lines 5@100 Trench Width 36" Max Trench Bottom Depth 30" Gravel Depth N/A ☐ Gravity ☒ Pressure

☒ New System ☐ Repair ☐ Expansion System Type: I II III IV V VI
System Description: PM-25% Reduction LPP
Repair System Description: _____
Maintenance Agreement Required: ☐ Yes ☒ No

☒ House/Mod. Home No. Bedrooms 4
☐ Mobile Home No. Persons _____
☐ Business No. Employees _____
☐ Other _____

Water Supply: ☒ Individual ☐ Public ☐ Community

☐ Slab ☒ Crawl Space ☐ Basement w/plumbing ☐ Basement wo/plumbing

Comments:/Conditions:

* Redraw Permit *
Paid $100 (Ray Short)

Comments:/Conditions:

INITIAL SITE SKETCH

See New Plans on attached Sheet from Rollins Soil & Env Services

AS BUILT SKETCH

- added one line (100') to achieve length for 25% Red.
- New L.O. w/ Rollins on 10/3/06

Permit can be suspended or revoked if any false information is supplied toward securing the permit/any unauthorized changes are made to the site/any unauthorized changes are made in the installation of the system. Improvement Permit with plat valid without expiration ☐ Improvement Permit with site plan valid for sixty months ☒ Authorization to Construct is valid for a period equal to that of Improvement Permit – not to exceed sixty months.

Signed: _____ date _____

Improvement Permit by: Joh E. Anglea date 10/4/06


Authorization to Construct by: Joh E. Anglea date 10/4/06

Installed by: Howards Backhoe

Operation Permit by: Joh E. Anglea date 10/11/06

Existing System Inspection by: _____ date _____

HEALTH DEPT. COPY: WHITE OWNER COPY (FINAL): YELLOW OWNER COPY (INITIAL): PINK

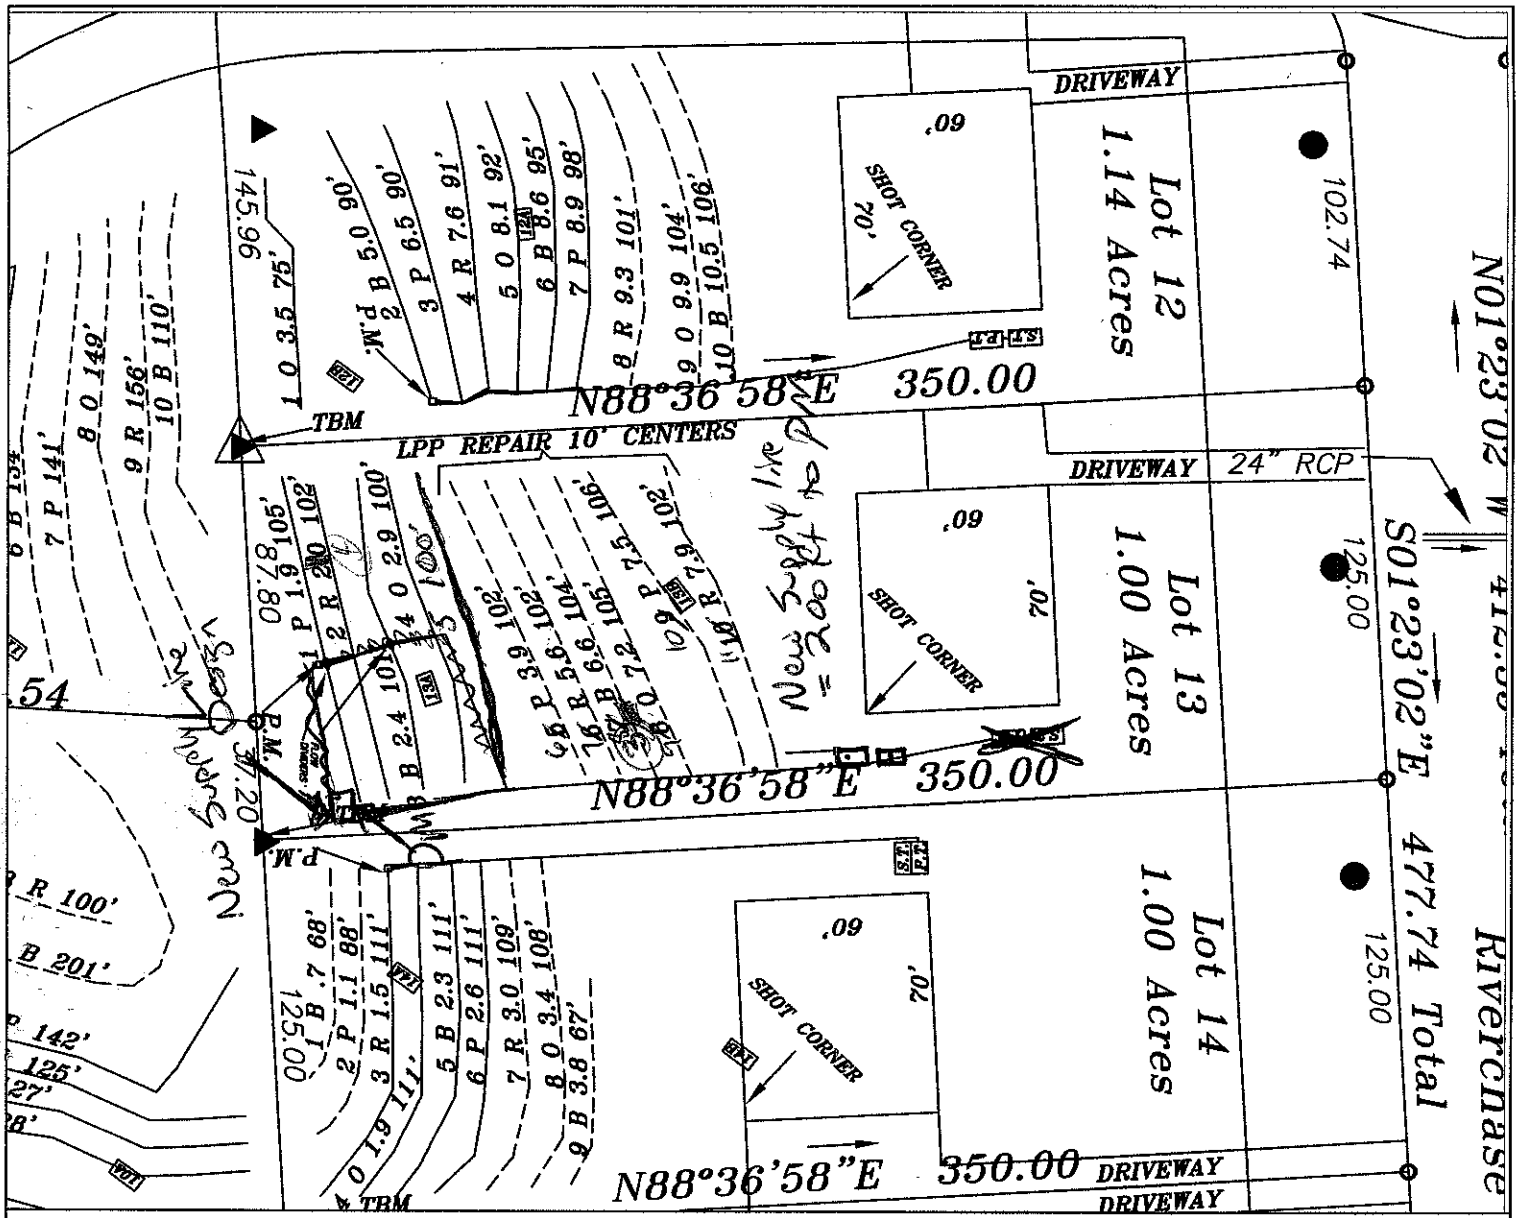

LEGEND

- Areas contain soils with 24 inches or more of useable material and have potential for conventional, modified conventional and low-pressure pipe (lpp) septic systems.
- Unsuitable areas.
- System lines.
- Repair lines.
- Temporary Bench Mark (TBM)
- Well Location.

GRAPHIC SCALE
1" = 60'

60 0 60 120

3840 ± #

FOR PRELIMINARY PLANNING PURPOSES ONLY. ALL LOTS WILL REQUIRE FINAL APPROVAL BY THE COUNTY HEALTH DEPARTMENT ON A LOT BY LOT BASIS. THIS MAP SHOULD BY USED AS A GENERAL GUIDE, SOME ADJUSTMENTS WILL BE NECESSARY IN THE FIELD DUE TO SOIL VARIABILITY AND COMPLEX TOPOGRAPHIC FEATURES. THIS MAP ONLY REFLECTS EXISTING SOIL SUITABILITY FOR ON-SITE SEPTIC TANK SYSTEMS.

PLEASE REFER TO ATTACHED SOIL REPORT FOR ADDITIONAL SITE SPECIFIC INFORMATION

ROLLANS SOIL & ENVIRONMENTAL SERVICES
2120 GRAHAM ROAD
MOUNT ULLA, NC 28125
PHONE/FAX: (704) 278 - 0989
ASHLEY ROLLANS, NC LICENSED SOIL SCIENTIST
MOBILE: (704) 746 - 5046
EMAIL: ROLLANSFORTCJ@AOL.COM

MAP TITLE: SITE PLAN & DRAINFIELD AREAS

PROJECT NAME: IREDELL GROUP LLC/WALDEN RIDGE SUBDIVISION

LOCATION/DATE: TEETER ROAD IREDELL COUNTY, NORTH CAROLINA DECEMBER 2005

JOB # : 01-1069
FILE: C:\JOBS\01-1069
PROJECT MGR.: CBF
FIELD WORK: CBF AND AP
DRAWN BY: CBF AND AP

Revised 10-13
Apr - 25% Red