IREDELL COUNTY HEALTH DEPARTMENT

STATESVILLE 704-878-5305 MOORESVILLE 704-664-5281

IMPROVEMENT PERMIT / AUTHORIZATION TO CONSTRUCT / OPERATION PERMIT / EXISTING SYSTEM INSPECTION

PERMIT# 094938 PIN# 4676 54 7220 DATE 3/29/01

OWNER OR CONTRACTOR Terry Sparks PHONE: Business Home 704-663-0013

ADDRESS 106 Park Creek Dr. Mooresville, NC. 28115

LOCATION 15 SE, R Teeter Rd. on (R) 64 670 Teeter Rd.

SUBDIVISION No BLOCK / SECTION LOT No LOT AREA ~ 18.72 AC SITE CLASS. PS DESIGN FLOW 360 L.T.A.R. .3

Septic Tank: 1000 Gallons; STB 794 Date 11/7/01
Pump Tank: Gallons; PT Date
Pump Make: Model Serial No.
Nitrification Field: No Fields 1 Square Feet 1200 Linear Feet 400
No Lines 4 @ 100' Trench Width 3' Max Trench Bottom Depth 3' Gravel Depth No


☑ New System ☐ Repair System Type: I, (II), III, IV, V, VI
System Description: Gravity Conventional
Repair System Description: Type 3
Maintenance Agreement Required: ☐ Yes ☒ No

☐ House/Mod. Home No. Bedrooms 3
☒ Mobile Home No. Bathrooms 3
☐ Business No. Employees
☐ Other
☐ Slab ☐ Crawl Space ☐ Basement w/plumbing ☐ Basement wo/plumbing

Water Supply:
☒ Individual
☐ Public
☐ Community


Comments:/Conditions:

INITIAL SITE SKETCH

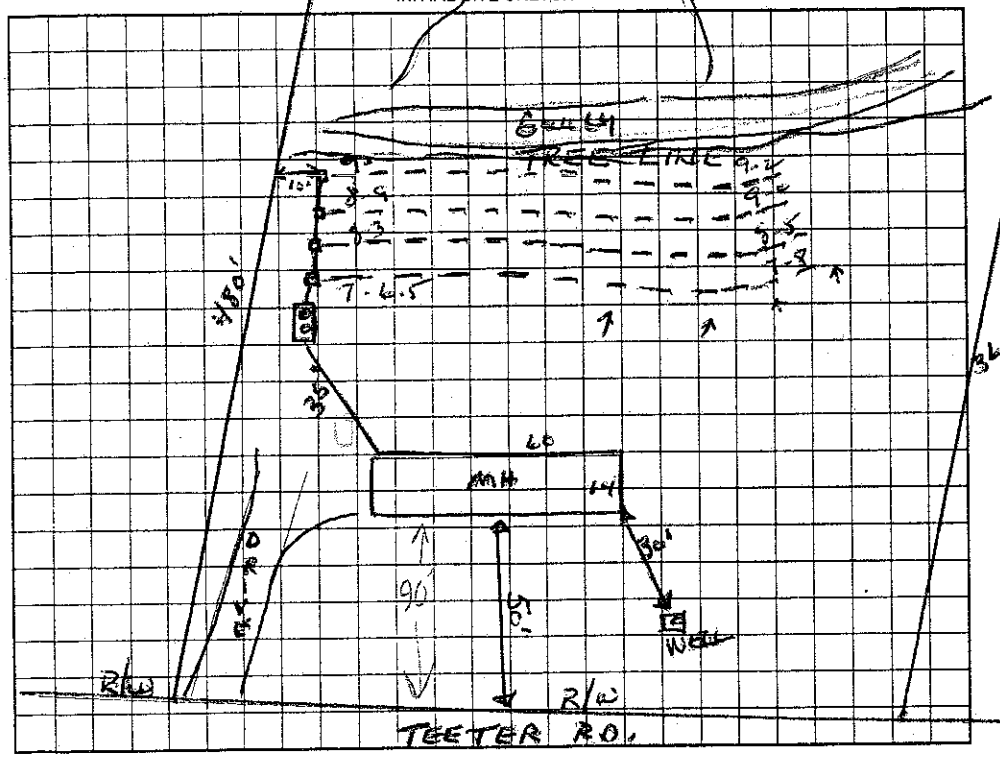

Comments:/Conditions:

AS BUILT SKETCH

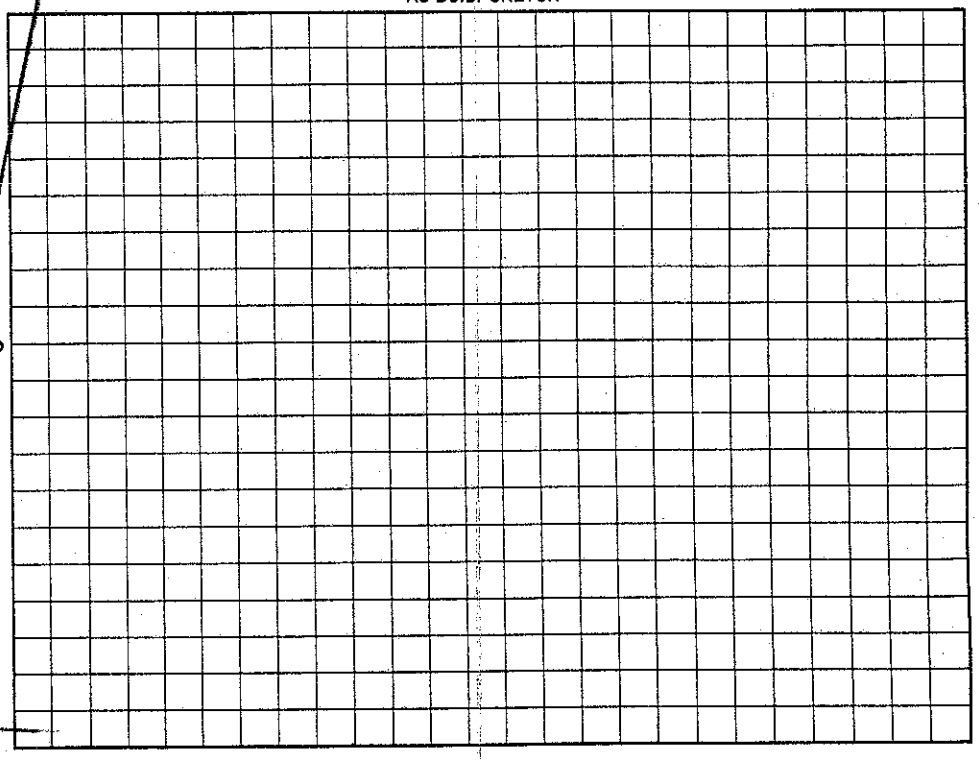

Permit can be suspended or revoked if any false information is supplied toward securing the permit/any unauthorized changes are made to the site/any unauthorized changes are made in the installation of the system. Improvement Permit with plat valid without expiration. Improvement Permit with site plan valid for sixty months. Authorization to Construct is valid for a period equal to that of Improvement Permit – not to exceed sixty months.

Signed: [signature] date 4/4/01

Improvement Permit by: Wesley Sparks RS. date 3/29/01

Authorization to Construct by: Wesley Sparks RS date 3/29/01

Installed by: By Self

Operation Permit by: Wesley Sparks RS. date 2/26/02

Existing System Inspection by: date

HEALTH DEPT. COPY: WHITE OWNER COPY (FINAL): YELLOW OWNER COPY (INITIAL): PINK