IREDELL COUNTY HEALTH DEPARTMENT

Authorization to Construct 4676532016

STATESVILLE 704-878-5305 MOORESVILLE 704-664-5281

IMPROVEMENT PERMIT / ~~CERTIFICATE OF COMPLETION~~ / OPERATION PERMIT / EXISTING SYSTEM INSPECTION

PROPERTY DESCRIPTION NO. 065793 DATE 4/18/97 TAX MAP NO. 4676645586 Lot

OWNER OR CONTRACTOR KERRY STUTTS PHONE: Business Home 857-5808 Watershed: ☑ Yes ☐ No (WSII BW)

ADDRESS 204 CRYSTAL CREEK CT

LOCATION ~~[redacted]~~ 150 E - TR TERRER RD - ON RT ≈ 3 MILES

SUBDIVISION — BLOCK / SECTION — LOT — LOT AREA SITE CLASS PS DESIGN FLOW 360 GPD L.T.A.R. 360 GPD/FT2

Septic Tank: 1000 Gallons; STB 825 Date 7/13/97

Pump Tank: Gallons; PT Date

Pump Make: Model Serial No.

Nitrification Field: No Fields 1 Square Feet 1200 Linear Feet 400

No Lines 5 @ 80' Trench Width 36" Max Trench Bottom Depth 36" Gravel Depth 12"

☑ New System ☐ Repair System Type: I (II) III, IV, V, VI

System Description: GRAVITY CONVENTIONAL

Repair System Description: PUMP CHAMBER FOR SEWAGE

Maintenance Agreement Required: ☐ Yes ☑ No

☑ House/Mod. Home No. Bedrooms 3

☐ Mobile Home No. Bathrooms 2

☐ Business No. Employees

☐ Other


☐ Slab ☑ Crawl Space ☐ Basement w/plumbing ☐ Basement wo/plumbing

Water Supply: ☑ Individual ☐ Community ☐ Public


Comments:

Comments:

INITIAL SITE SKETCH

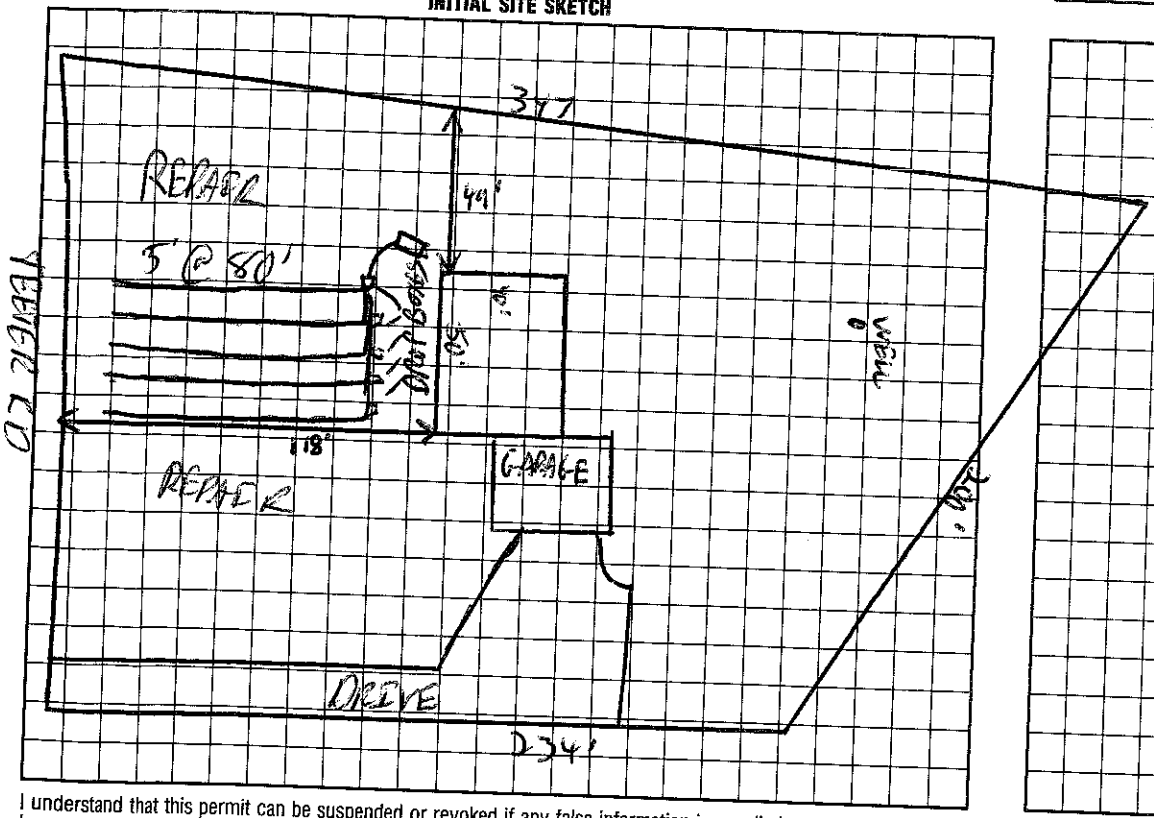

AS BUILT SKETCH

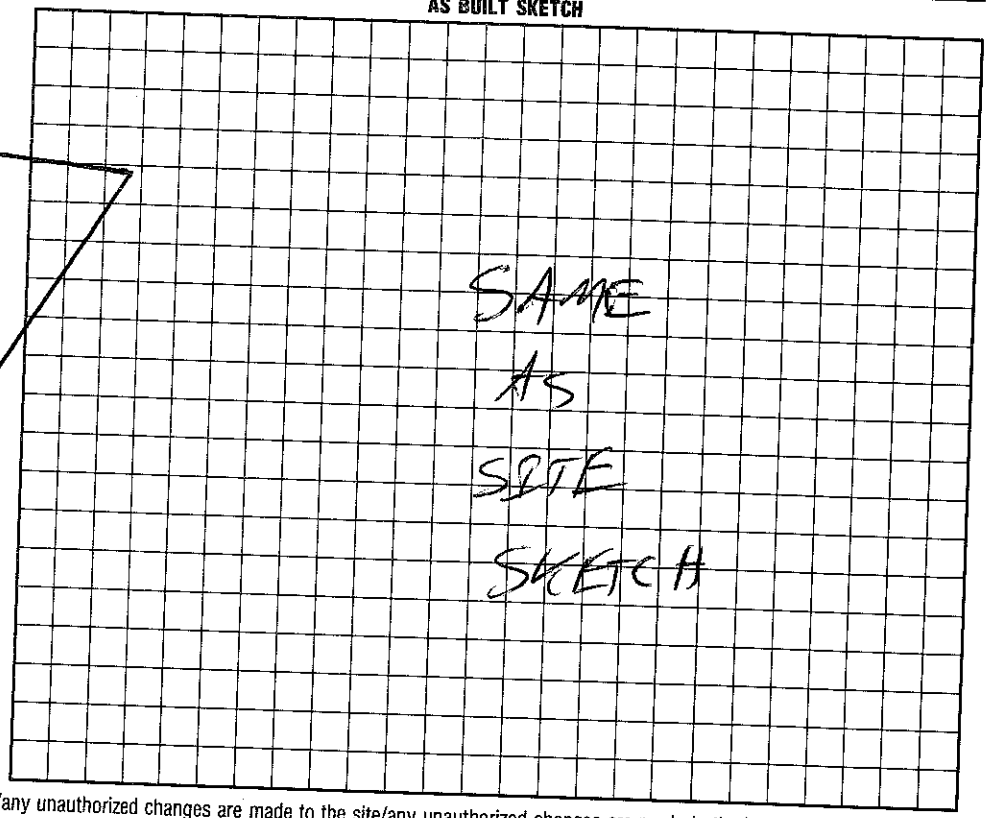

I understand that this permit can be suspended or revoked if any false information is supplied toward securing the permit/any unauthorized changes are made to the site/any unauthorized changes are made in the installation of the system. Improvement Permit is valid for 60 months from date of issuance.

Signed: Kerry Dane Stutts 4-18-97

Improvement Permit by: C. [signature] date 4/18/97

~~Existing System Inspection~~ Authorization to Construct by: C. [signature] date 4/18/97

Installed by: BARBER SEPTIC SERVICE INC.

Certificate of Completion by: date

Operation Permit by: C. [signature] date 8/20/97

HEALTH DEPT. COPY: WHITE INSPECTION COPY (FINAL): GREEN OWNER COPY (FINAL): YELLOW INSPECTION COPY (INITIAL): PINK OWNER COPY (INITIAL): GOLD