IREDELL COUNTY HEALTH DEPARTMENT

STATESVILLE 704-878-5305 MOORESVILLE 704-664-5281

IMPROVEMENT PERMIT / AUTHORIZATION TO CONSTRUCT / OPERATION PERMIT / EXISTING SYSTEM INSPECTION

PERMIT# 076158 PIN# 4676 64 8019 DATE 10/8/98

OWNER OR CONTRACTOR Robin M Stutts PHONE: Business Home 664-9706

ADDRESS 1630 Lyndie Hwy Mooresville, NC. 28115

LOCATION 150 E Teeter Rd. 2.3 miles X Bridge on (L) 629 Teeter Rd.

SUBDIVISION N/A BLOCK / SECTION LOT LOT AREA ~2.9 Ac SITE CLASS. PS DESIGN FLOW 360 L.T.A.R. .25

Septic Tank: 1000 Gallons; STB 714 Date 12/15/98

Pump Tank: 1000 Gallons; PT 27 Date 3/24/99

Pump Make: Model Serial No.

Nitrification Field: No Fields 1 Square Feet 1440 Linear Feet 480

No Lines 4 Trench Width 36" Max Trench Bottom Depth 28" Gravel Depth 12"

[X] New System [ ] Repair System Type: I, II, (III) IV, V, VI

System Description: PressMan → Conventional

Repair System Description:

Maintenance Agreement Required: [ ] Yes [X] No

[X] House/Mod. Home No. Bedrooms 3

[ ] Mobile Home No. Bathrooms 2

[ ] Business No. Employees

[ ] Other


[ ] Slab [X] Crawl Space [ ] Basement w/plumbing [ ] Basement wo/plumbing

Water Supply: [X] Individual [ ] Public [ ] Community


Comments:/Conditions:

Comments:/Conditions: Electrical & Alarm Checked 8/20/99 MH

INITIAL SITE SKETCH

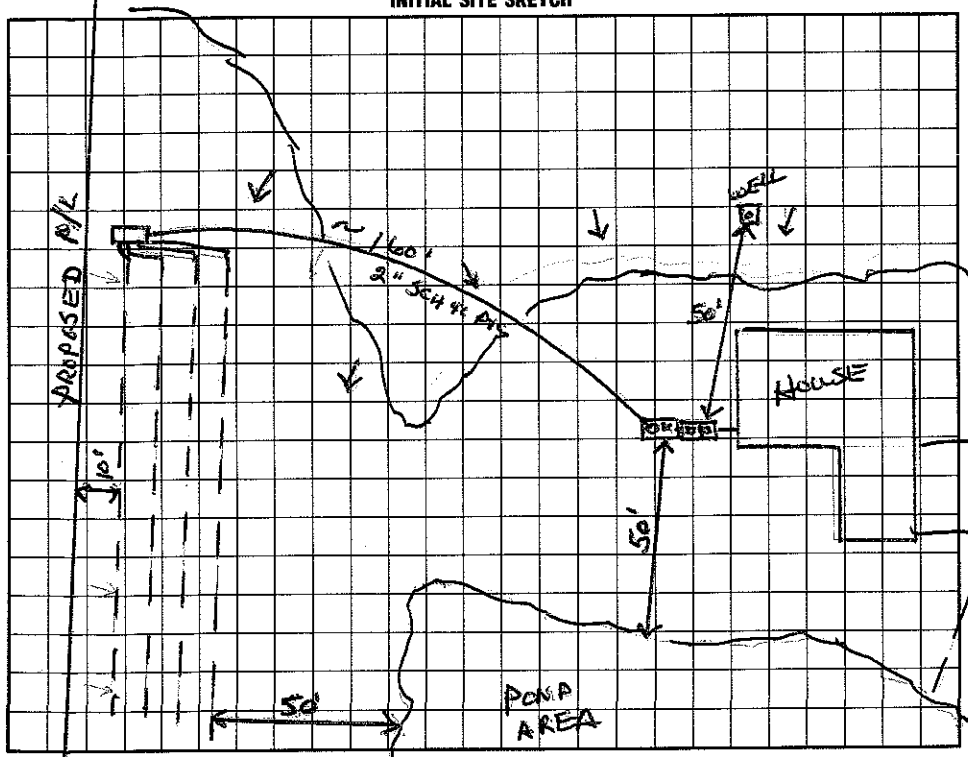

AS BUILT SKETCH

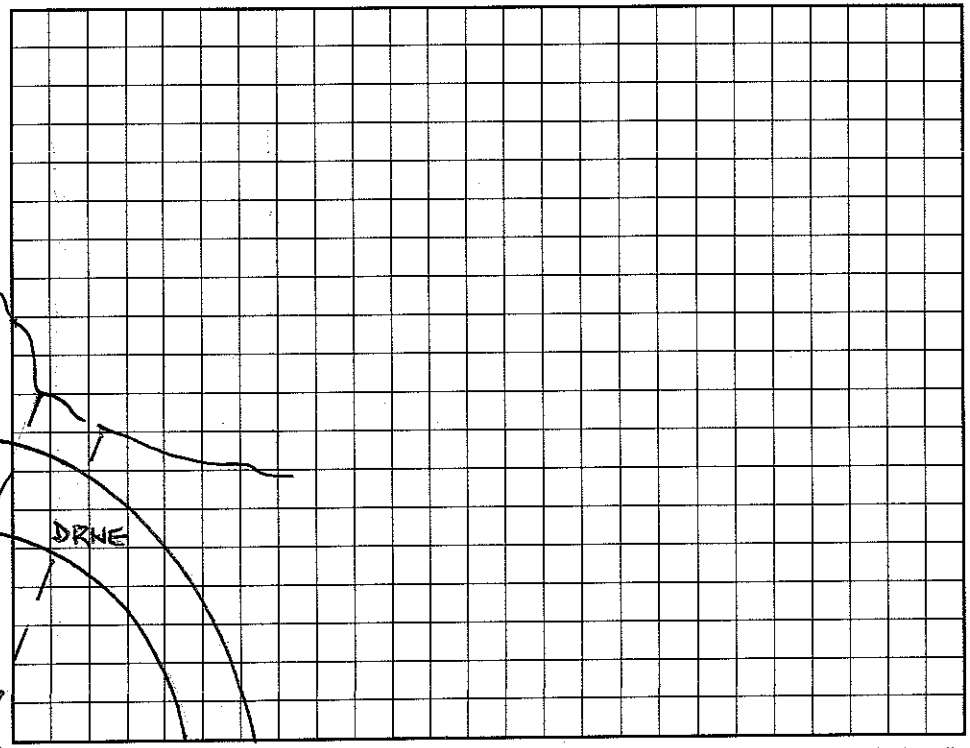

I understand that this permit can be suspended or revoked if any false information is supplied toward securing the permit/any unauthorized changes are made to the site/any unauthorized changes are made in the installation of the system. Improvement Permit with plat valid without expiration. Improvement Permit with site plan valid for sixty months. Authorization to Construct is valid for a period equal to that of Improvement Permit – not to exceed sixty months.

Signed: *Robin M. Stutts date 10/6/99

Improvement Permit by: Wesley Sparks R.S. date 10/9/98

Authorization to Construct by: Wesley Sparks R.S. date 10/9/98

Installed by: ERBISON

Operation Permit by: Maria Dotson R.S. date 8/20/99

Existing System Inspection by: date

HEALTH DEPT. COPY: WHITE INSPECTION COPY (FINAL): GREEN OWNER COPY (FINAL): YELLOW INSPECTION COPY (INITIAL): PINK OWNER COPY (INITIAL): GOLD