IREDELL COUNTY HEALTH DEPARTMENT

STATESVILLE 704-878-5305 350.00 Paid MOORESVILLE 704-664-5281

IMPROVEMENT PERMIT / AUTHORIZATION TO CONSTRUCT / OPERATION PERMIT / EXISTING SYSTEM INSPECTION

PERMIT# Repair PIN# 4676690770 DATE 3/20/06

OWNER OR APPLICANT Donald Brumley PHONE: Business Home 704 664 4124

ADDRESS 390 Brumley Rd Mooresville NC 28115

LOCATION Linwood Rd, TL Brumley, on Lt #390

SUBDIVISION BLOCK / SECTION LOT LOT AREA 1.72 Ac SITE CLASS. PS DESIGN FLOW 360 L.T.A.R.

Septic Tank: Existing Gallons: STB Date

Pump Tank: Gallons: PT Date

Pump Make: Model Serial No.

Nitrification Field: No Fields 1 Square Feet 900 Linear Feet 300

No Lines 3 Trench Width 36" Max Trench Bottom Depth 36" Gravel Depth (18") ☒ Gravity ☐ Pressure

☒ New System ☐ Repair ☐ Expansion System Type: I (II) III IV V VI

System Description:

Repair System Description: Gravity Conventional

Maintenance Agreement Required: ☐ Yes ☒ No

☒ House/Mod. Home No. Bedrooms 3

☐ Mobile Home No. Persons

☐ Business No. Employees

☐ Other


Water Supply: ☒ Individual ☐ Public ☐ Community

☐ Slab ☒ Crawl Space ☐ Basement w/plumbing ☐ Basement wo/plumbing


Comments:/Conditions: Can use Accepted system with no Linear Reduction

Comments:/Conditions:

INITIAL SITE SKETCH

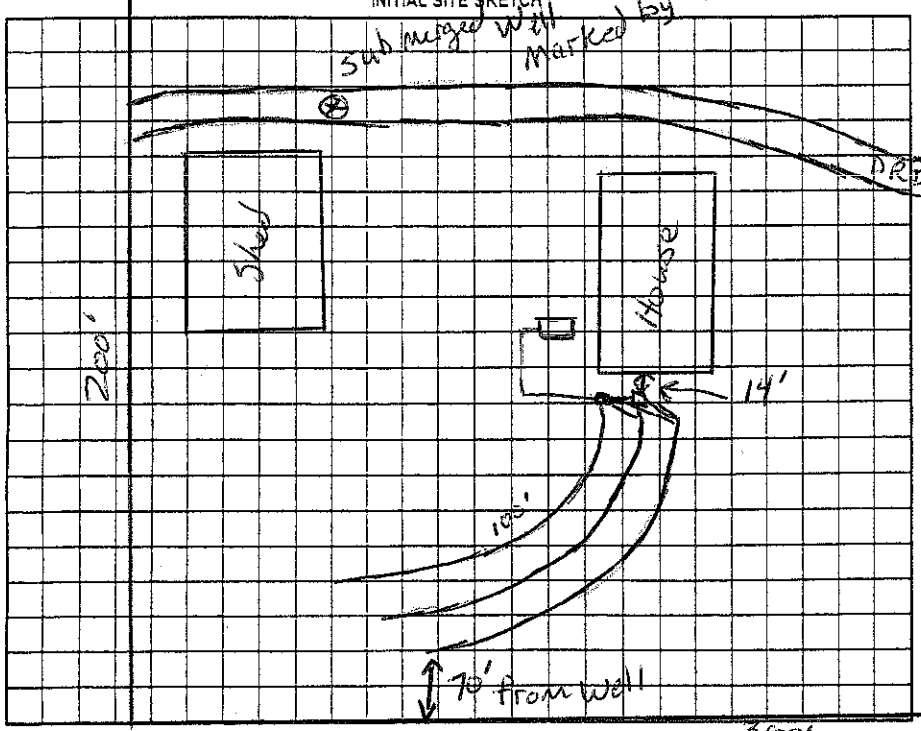

AS BUILT SKETCH

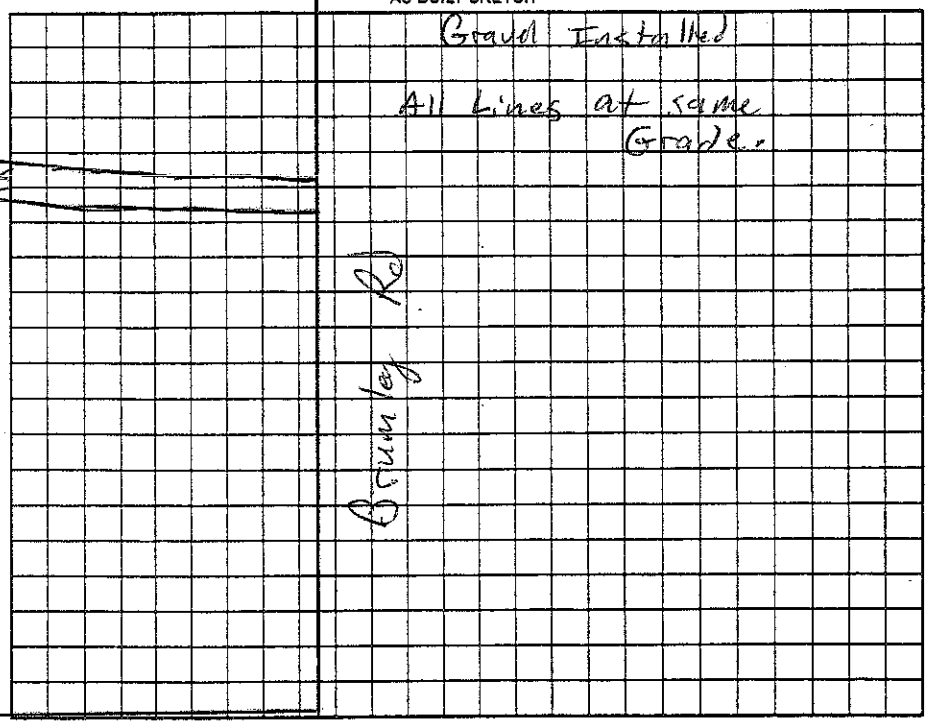

Permit can be suspended or revoked if any false information is supplied toward securing the permit/any unauthorized changes are made to the site/any unauthorized changes are made in the installation of the system. Improvement Permit with plat valid without expiration. ☐ Improvement Permit with site plan valid for sixty months ☒ Authorization to Construct is valid for a period equal to that of Improvement Permit – not to exceed sixty months.

Signed: Doug Brumley date 3-25-06

Improvement Permit by: RS date 3/20/06

Authorization to Construct by: RS date 3/20/06

Installed by: Joe Thompson

Operation Permit by: RS date 3/29/06

Existing System Inspection by: date

HEALTH DEPT COPY: WHITE OWNER COPY (FINAL): YELLOW OWNER COPY (INITIAL): PINK