Site Address: 184 Riverchase Ln - Mrsvl.

IREDELL COUNTY HEALTH DEPARTMENT

STATESVILLE 704-878-5305 MOORESVILLE 704-664-5281

IMPROVEMENT PERMIT / AUTHORIZATION TO CONSTRUCT / OPERATION PERMIT / EXISTING SYSTEM INSPECTION

PERMIT # 140 393 PIN # 4676715444 4676126401 DATE 9-17-09

OWNER or APPLICANT Mid-Atlantic PHONE: Business 828 478-2761 Home:

OWNER or APPLICANT ADDRESS P.O. Box 3792 Mooresville, NC 28117

LOCATION / DIRECTIONS Main St. N TR Linwood TL Reeter TR Walden TR RiverChase on right

SUBDIVISION Walden Ridge. BLOCK / SECTION LOT # 216 * Part 37 LOT AREA 1.18Ac. DESIGN FLOW 480gpd L.T.A.R. .3

Septic Tank 1000 Gallons: STB 750 Date 8-27
Pump Tank 1000 Gallons: PT 363 Date 7-13
Pump Make Gravity Model WE07124 Serial #
Nitrification Field No Fields 1 No Lines 4 Linear Feet 400'
Trench Width 36" Max. Trench Bottom Depth 36" Gravel Depth N/A

☒ New System ☐ Repair ☐ Expansion System Type I II (III) IV V VI
System Description: Pump-PM-25% Reduction
Repair System Description: Pump-LP-PPBPS
Maintenance Agreement Required ☐ YES ☒ NO Not initially
☐ GRAVITY ☒ PRESSURE

☒ Residence No. Bedrooms 4
☐ Business No. Persons
☐ Other No. Employees
☐ Slab ☐ Crawl Space
☒ Basement w/plumbing ☐ Basement w/o plumbing

☒ Water Supply ☒ Private ☐ Public ☐ Community

Comments / Conditions: Initial site evaluation done by Rollans Soil & Environmental Services Reviewed floor plans 5/23/13 in compliance with Septic plan. Note: Bonus Room should have Cased or arched entry.

Comments / Conditions: * Must keep DrainField at least 25Ft from basement wall. Rear Side property line with driveway * Keep tanks 15ft from Basement.

INITIAL SITE SKETCH

See plan by Rollans Soil & Environmental Services

AS BUILT SKETCH

This permit/plan approval replaces previous permit issued 9/5/07.

** Rear Property line with drive

400' INSTALLED

CHECKED FEB 24 2014
LINES & TANKS
BA

CHECKED MAR 24 2014
Pressure + Akrn + Circuits
ALP

Location of the proposed 15'x32' roof addition does not appear to impact the existing on-site septic system or well.**NOTE: #205441

Jane Grey REHS Date: 9-9-14
IREHD Environmental Health Division

* SEE SITE PLAN SUBMITTED BY MICHAEL ATHANAS *

Permit can be suspended or revoked if any false information is supplied toward securing the permit / any unauthorized changes are made to the site / any unauthorized changes are made in the installation of the system.

☐ *IMPROVEMENT PERMIT w / plat valid without expiration* ☐ *IMPROVEMENT PERMIT w / site plan valid for 60 mos.* ☐ *AUTHORIZATION TO CONSTRUCT valid for period equal to IMPROVEMENT PERMIT-not to exceed 60 mo.*

Owner / Applicant Signature: Date 9/28/09

Improvement Permit by: RS Date 9/17/09

Authorzation to Construct by: RS 5/23/13

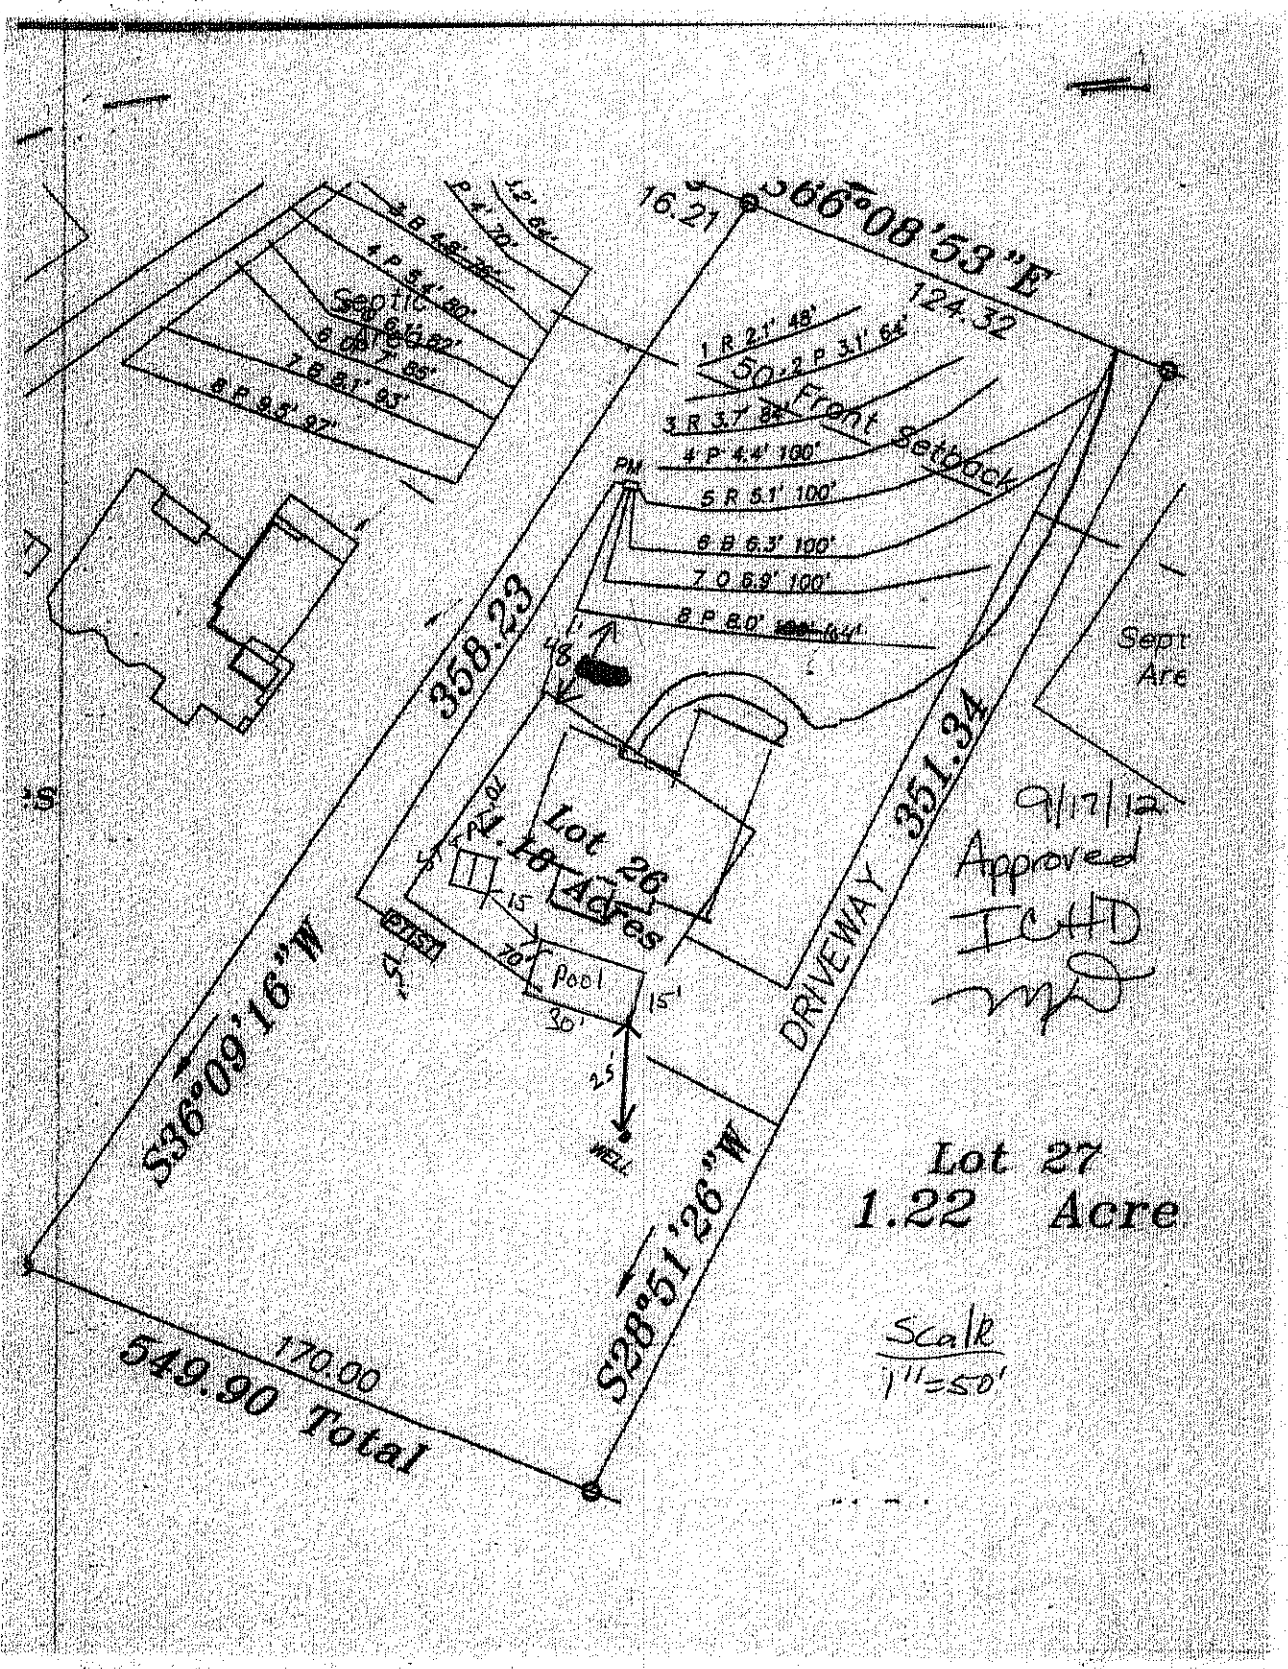
Installed by: GROUND BREAKERS

Operation Permit by: Date: 3-24-14

Existing System Inspected by: Date:

YOU SHOULD CONTACT A LOCATOR SERVICE PRIOR TO ANY EXCAVATION!

WHITE COPY Environmental Health YELLOW COPY (Final) Owner / Applicant PINK COPY (Initial) Owner / Applicant


S66°08'53"E
124.32
16.21
1 R 2.1' 48'
50.2 P 3.1' 64'
3 R 3.7' 82'
4 P 4.4' 100'
5 R 5.1' 100'
6 B 6.3' 100'
7 O 8.9' 100'
8 P 8.0'
Front Setback
PM
358.23
S36°09'16"W
Lot 26
1.18 Acres
Pool
30'
15'
WELL
DRIVEWAY
351.34
S28°51'26"W
170.00
549.90 Total
Septic Area
9/17/12
Approved
ICHD
Lot 27
1.22 Acre
Scale
1"=50'