IREDELL COUNTY HEALTH DEPARTMENT


ENVIRONMENTAL HEALTH DIVISION

PAGE 2: ***SITE PLAN WORKSHEET***

SEE THE "SAMPLE SITE PLAN" BELOW. ***INCOMPLETE SITE PLANS WILL BE RETURNED TO YOU FOR COMPLETION AND MAY RESULT IN A DELAY IN THE ISSUANCE OF YOUR SEPTIC SYSTEM PERMIT!!!***

Place an (X) beside each item as you complete the site plan:

- (X) Property Line measurements are clearly identified
- (X) All proposed structures are indicated
- (X) Front and side setbacks from property line
- (X) Preferred driveway location and well location
- (X) Area you prefer your septic system to be placed
- (X) North arrow, or other sufficient indicator of direction

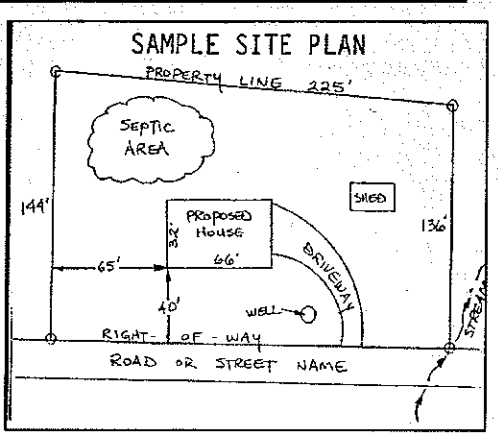

Circle N/A on the following if appropriate:

Location of septic systems and wells within 100' of your property N/A
Location of easements and rights of ways on your property N/A
Location of any designated wetlands on the property N/A

USE THIS SPACE TO DRAW YOUR SITE PLAN

Show: proposed house or business footprint, wells, water lines, patios, pools and decks, and any other item that will occupy space on the site

Refer to Site Plan.

Signature: _____ 9-9-14

Property owner or owner's legal representative signature (SIGNATURE REQUIRED) — DATE

IREDELL COUNTY HEALTH DEPARTMENT

STATESVILLE 704-878-5305 MOORESVILLE 704-664-5281

IMPROVEMENT PERMIT / AUTHORIZATION TO CONSTRUCT / OPERATION PERMIT / EXISTING SYSTEM INSPECTION

PERMIT # 140393 PIN # 4676711544 DATE 9-17-09

OWNER or APPLICANT Mid-Atlantic PHONE: Business 828 478-2761 Home:

OWNER or APPLICANT ADDRESS P.O. Box 3792 Mooresville NC 28117

LOCATION / DIRECTIONS Main St. R TR Linwood TL Peeler TR Walden TR RiverChase on right

SUBDIVISION Walden Ridge BLOCK / SECTION LOT # 216 LOT AREA 1.18Ac. DESIGN FLOW 480gpd L.T.A.R. .3

Septic Tank 1000 Gallons: STB 7600 Date 8-27
Pump Tank 1000 Gallons: PT 3643 Date 9-23
Pump Make Ewing Model WE07424 Serial #
Nitrification Field No Fields 1 No Lines 4 Linear Feet 400'
Trench Width 36" Max. Trench Bottom Depth 36" Gravel Depth N/A ☐ GRAVITY ☒ PRESSURE

☒ New System ☐ Repair ☐ Expansion System Type I II III IV V VI
System Description: Pump-Pm-25%Reduction
Repair System Description: Pump-LP-PPBPS
Maintenance Agreement Required ☐ YES ☒ NO Not initially

☒ Residence No. Bedrooms 4
☐ Business No. Persons
☐ Other No. Employees
☐ Slab ☐ Crawl Space
☒ Basement w/plumbing ☐ Basement w/o plumbing

Water Supply: ☒ Private ☐ Public ☐ Community

Comments / Conditions: Initial Site evaluation done by Rollans Soil & Environmental Services Reviewed floor plans 5/23/13 is compliance with Septic plan. Note: Bonus Room should have closed or arched entry.

Comments / Conditions: * Must keep Drainfield at least 25Ft from basement wall. Hug side property line with driveway * Keep tanks 15Ft From Basement.

INITIAL SITE SKETCH

See plan by Rollans Soil & Environmental Services

AS BUILT SKETCH

This permit/plan approval replaces previous permit issued 9/5/07.

** Hug Property line with drive

400' INSTALLED

CHECKED FEB 24 2014
LINES & TANKS
BA

CHECKED MAR 24 2014
Pressure & Accy Circuits
ALP

Permit can be suspended or revoked if any false information is supplied toward securing the permit / any unauthorized changes are made to the site / any unauthorized changes are made in the installation of the system.

☐ IMPROVEMENT PERMIT w / site valid without expiration ☐ IMPROVEMENT PERMIT w / site plan valid for 60 mos. ☐ AUTHORIZATION TO CONSTRUCT valid for period equal to IMPROVEMENT PERMIT-not to exceed 60 mo.

Owner / Applicant Signature: Date 9/28/09

Improvement Permit by: RS Date 9/17/09

Authorization to Construct by: RS 5/23/13

Installed by: GROUNDBREAKERS


Operation Permit by: Date: 3-24-14

Existing System Inspected by: Date:


YOU SHOULD CONTACT A LOCATOR SERVICE PRIOR TO ANY EXCAVATION!

WHITE COPY Environmental Health YELLOW COPY (Final) Owner / Applicant PINK COPY (Initial) Owner / Applicant

POOL AREA	445 SF
POOL PERIMETER	84'
DECK AREA	539 SF
POOL VOLUME	14,184 GALLONS

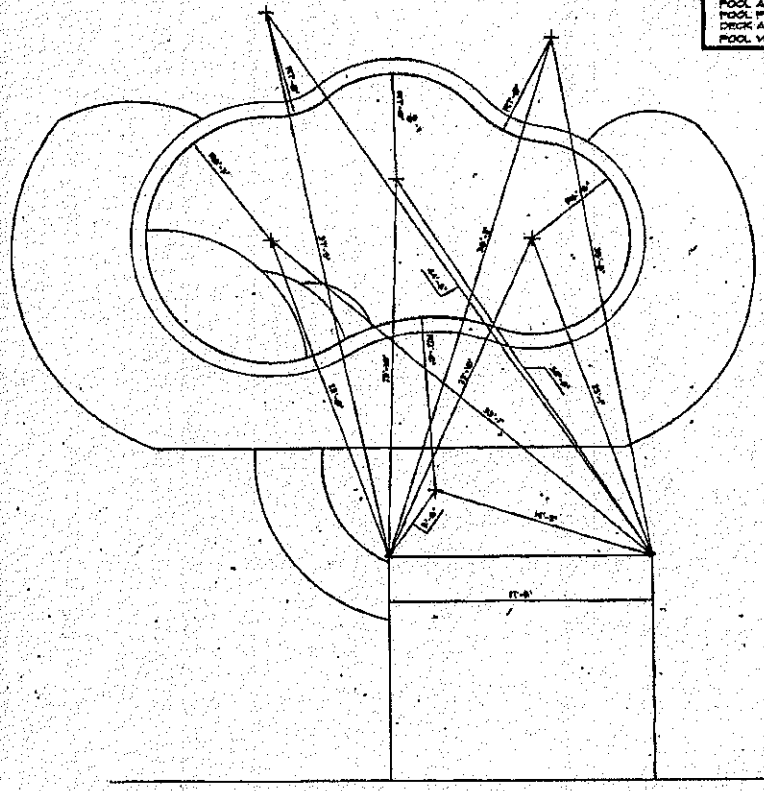

1 SP-1 1/4" = 1'-0" POOL DIMENSIONS

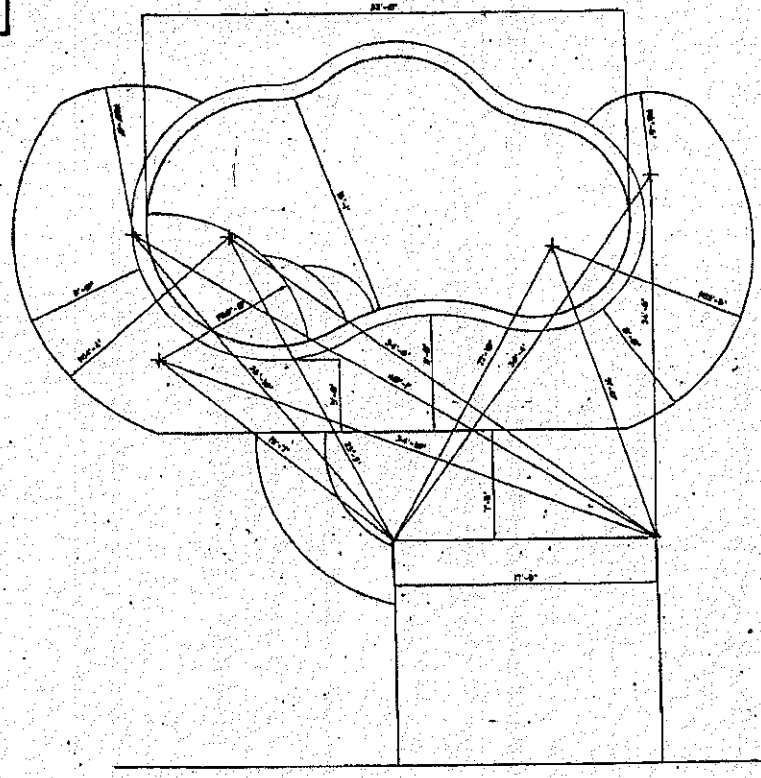

2 SP-1 1/4" = 1'-0" ADDITIONAL DIMENSIONS