IREDELL COUNTY HEALTH DEPARTMENT - *ENVIRONMENTAL HEALTH* ☐ STATESVILLE OFFICE 704-878-5305 ☐ MOORESVILLE OFFICE 704-664-5281

IMPROVEMENT PERMIT / AUTHORIZATION TO CONSTRUCT / OPERATION PERMIT / EXISTING SYSTEM INSPECTION

PERMIT # 172689 Zo PIN # 4676713555 DATE 6-14-~~06~~ 12

OWNER Michael Whitfield APPLICANT: Aloha Pools PHONE: Home/Cell # Tim 980 722-1453 Business # 704597-7171

SITE ADDRESS 190 Riverchase Ln OWNER / APPLICANT ADDRESS 6401 B Orr Rd Charlotte NC

SITE DIRECTIONS Main St N TR Linwood TL Teeter TR Walden Dr. TR Riverchase nearend

SUBDIVISION Walden Ridge BLOCK / SECTION LOT # 27 LOT AREA 1.22 Ac DESIGN FLOW 480gpd L.T.A.R.

Septic Tank 1600 Gallons: STB Date

Pump Tank 1000 Gallons: P T Date

Pump Make Model Serial #

No. Nitrification Fields: 1 No. Lines 4 Linear Feet 400'

Trench Width 36" Max. Trench Bottom Depth 36"

☐ New System ☒ Existing ☐ Repair ☐ Expansion System Type I II III IV V VI

System Description: 1 Pump-PM-25% Reduction

Repair System Description: LPP PPBPS

Maintenance Agreement Required ☐ YES ☐ NO

Gravel Depth N/A ☐ GRAVITY ☒ PRESSURE

☒ Residence No. Bedrooms 4

☐ Business No. Persons

☐ Other No. Employees

☐ Slab ☒ Crawl Space


☐ Basement w/plumbing ☐ Basement w/o plumbing

Water Supply: ☒ Private ☐ Public ☐ Community

Comments / Conditions: Existing Septic System appears to be functioning OK at time of inspection.

☒ Must Keep Pool "Cut" at least 15ft from Septic System! Do Not drive over Septic System.

INITIAL SITE SKETCH

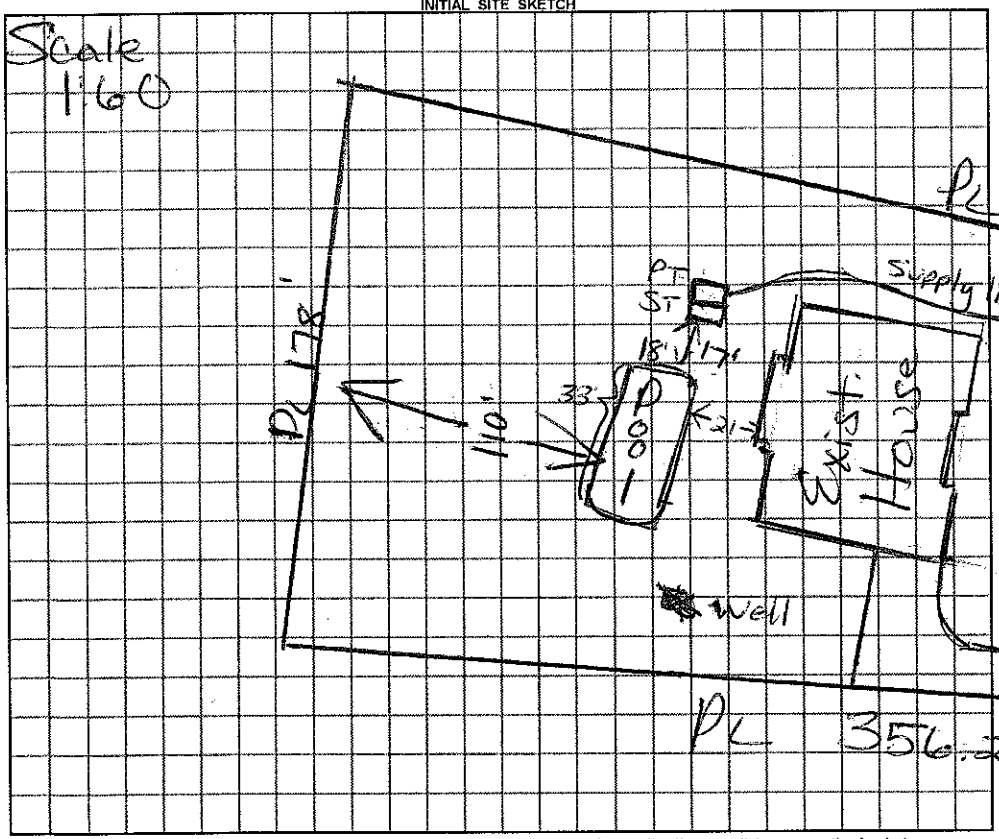

AS BUILT SKETCH

Permit can be suspended or revoked if any false information is supplied toward securing the permit / any unauthorized changes are made to the site / any unauthorized changes are made in the installation of the system.

☐ ***IMPROVEMENT PERMIT*** with plat valid without expiration. ☐ ***IMPROVEMENT PERMIT*** with plat valid without expiration. site plan valid 60 mo. ☐ ***AUTHORIZATION TO CONSTRUCT*** valid for period equal to IMPROVEMENT PERMIT--not to exceed 60 mo.

Owner / Applicant Signature: X Tim Potter Agent Date

IMPROVEMENT PERMIT by: REHS Date

AUTHORIZATION TO CONSTRUCT by: REHS Date

Installed by: Installed 6/27/08

OPERATION PERMIT by: REHS Date

Existing System Inspected by: REHS Date 6/14/12

YOU SHOULD CONTACT A LOCATOR SERVICE PRIOR TO ANY EXCAVATION

White Copy – Environmental Health YELLOW COPY (Final) Owner / Applicant PINK COPY (Initial) Owner / Applicant