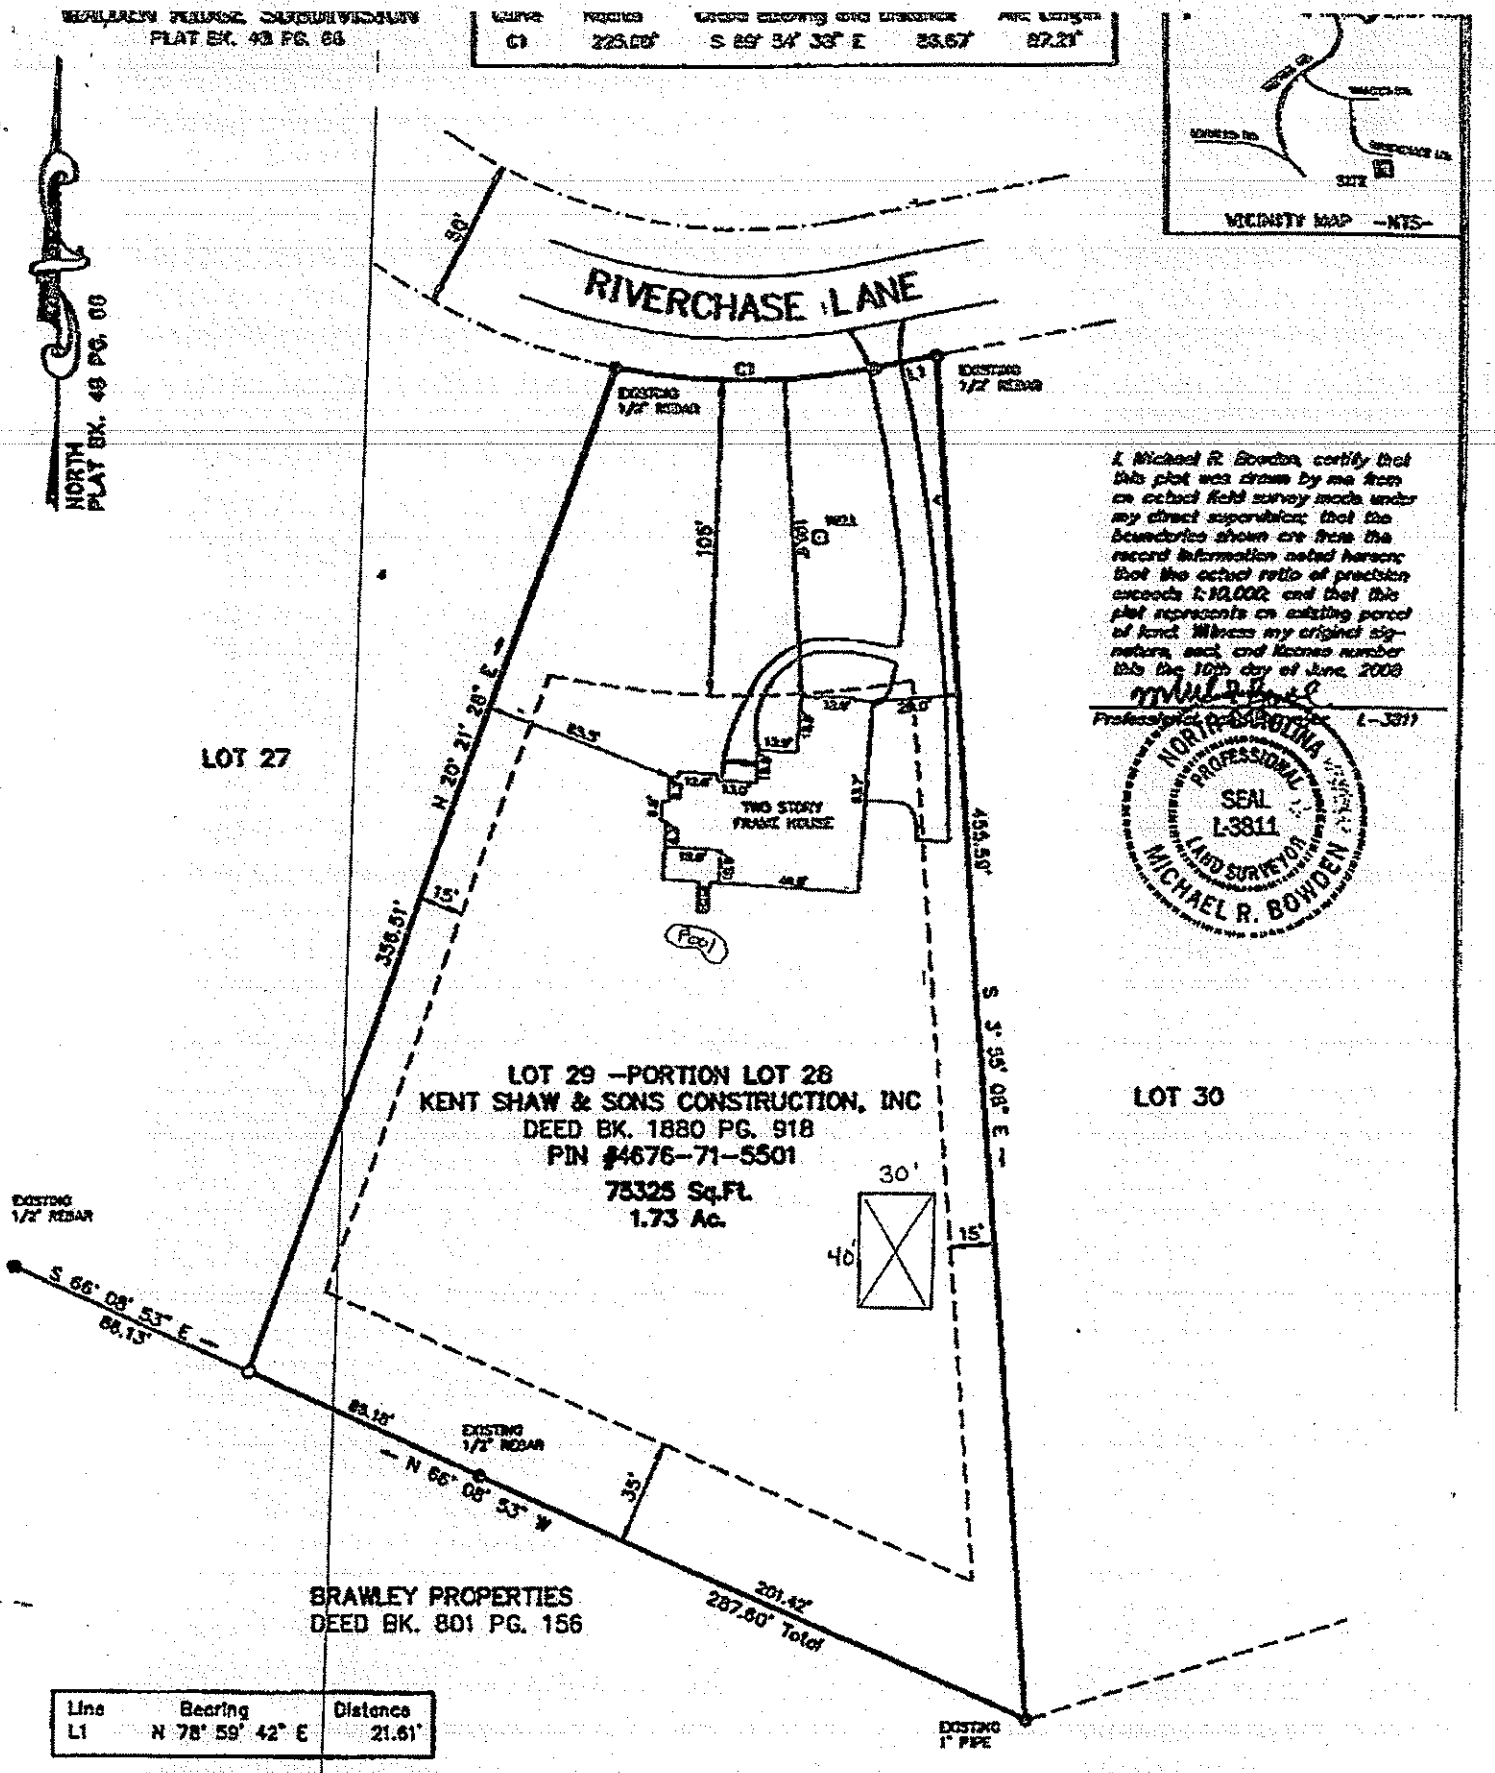

RIVERCHASE LANE
50'
C1
225.00'
S 89° 54' 38" E
88.67'
87.21'
EXISTING 1/2" REBAR
EXISTING 1/2" REBAR
L1
NORTH
PLAT BK. 49 PG. 68
VICINITY MAP -NTS-
SITE
I, Michael R. Bowden, certify that this plat was drawn by me from an actual field survey made under my direct supervision; that the boundaries shown are from the record information noted hereon; that the actual ratio of precision exceeds 1:10,000; and that this plat represents an existing parcel of land. Witness my original signature, seal, and license number this the 10th day of June, 2008
Professional Registered Surveyor L-3811
NORTH CAROLINA PROFESSIONAL SEAL L-3811 LAND SURVEYOR MICHAEL R. BOWDEN
LOT 27
N 20° 21' 28" E
85.5'
106'
WELL
TWO STORY FRAME HOUSE
POOL
358.51'
15'
455.80'
S 3° 55' 08" E
LOT 29 -PORTION LOT 28
KENT SHAW & SONS CONSTRUCTION, INC
DEED BK. 1880 PG. 918
PIN #4676-71-5501
75325 Sq.Ft.
1.73 Ac.
LOT 30
30'
40'
15'
EXISTING 1/2" REBAR
S 66° 08' 53" E
89.13'
89.18'
EXISTING 1/2" REBAR
N 66° 08' 53" W
35'
BRAWLEY PROPERTIES
DEED BK. 801 PG. 156
201.42'
287.60' Total
EXISTING 1" PIPE
Line Bearing Distance
L1 N 78° 59' 42" E 21.61'
● = EXISTING IRON AS NOTED
○ = 1/2" REBAR SET
⊕ = POINT - NOTHING SET
50 25 0 50 100
SCALE OF DRAWING IS 1 INCH = 50 FEET
Survey For:
David W. Lucas
Denise K. Lucas
196 RIVERCHASE LANE
CODDLE CREEK TOWNSHIP

IREDELL COUNTY HEALTH DEPARTMENT

STATESVILLE 704-878-5305 MOORESVILLE 704-664-5281

IMPROVEMENT PERMIT / AUTHORIZATION TO CONSTRUCT / OPERATION PERMIT / EXISTING SYSTEM INSPECTION

PERMIT# 135498 PIN# 4676715501 DATE 9-12-07

OWNER OR APPLICANT Kent Shaw PHONE: Business 704 528 4494 Home 704-528-4421

ADDRESS PO Box 1061 Troutman NC

LOCATION Main St N TR: Linwood TL: Teeter TR Walden TR Riverchase on right

SUBDIVISION Walden Ridge BLOCK / SECTION ____ LOT 29 & 2098 LOT AREA 1.73 Ac SITE CLASS PS DESIGN FLOW 480 gpd L.T.A.R. .3 gpd/ft²

Septic Tank: 1000 Gallons: STB 1000 Date: Washer

Pump Tank: ____ Gallons: PT ____ Date ____

Pump Make: ____ Model ____ Serial No. ____

Nitrification Field, No Fields 1 Square Feet 1200 Linear Feet 400

No Lines 7 Trench Width 36" Max Trench Bottom Depth 36"

☒ New System ☐ Repair ☐ Expansion System Type: I ☐ II III IV V VI

System Description: 25% reduction gravity

Repair System Description: LP PPRPS

Maintenance Agreement Required: ☐ Yes ☒ No

☒ House/Mod. Home ☐ Mobile Home ☐ Business ☐ Other


No. Bedrooms 4 No. Persons 8 No. Employees ____

Water Supply: ☒ Individual ☐ Public ☐ Community

Gravel Depth N/A ☒ Gravity ☐ Pressure ☐ Slab ☒ Crawl Space ☐ Basement w/plumbing ☐ Basement w/o plumbing


Comments/Conditions: 1" = 60'

INITIAL SITE SKETCH

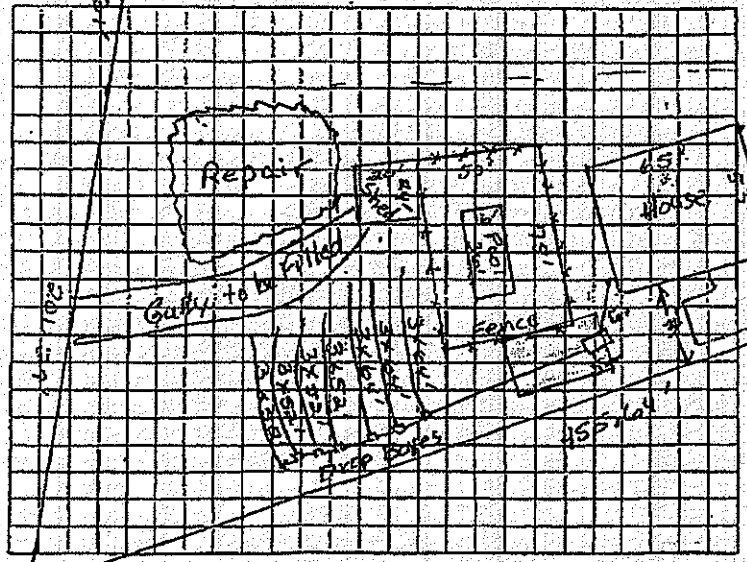

Comments/Conditions: Keep drainlines 5'+ from filled gully

AS BUILT SKETCH

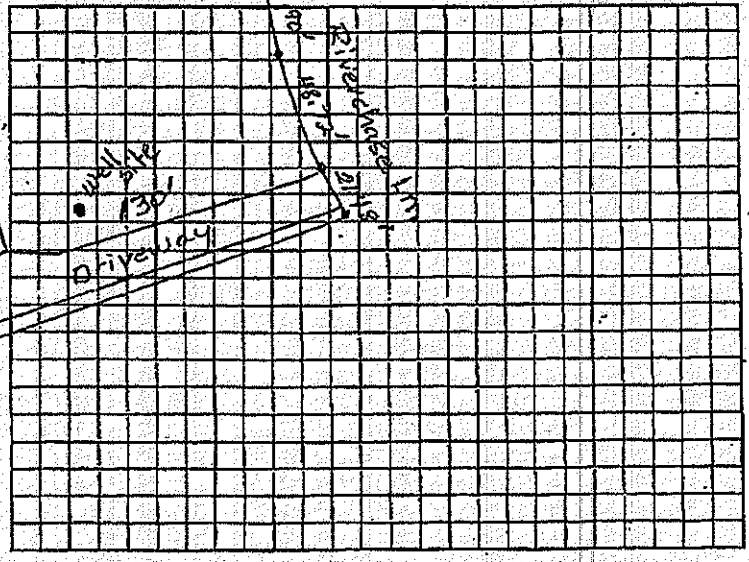



Permit can be suspended or revoked if any false information is supplied toward securing the permit/any unauthorized changes are made to the site/any unauthorized changes are made in the installation of the system. Improvement Authorization to Construct is valid for a period equal to that of Improvement Permit – not to exceed sixty months.

Permit with plat valid without expiration ☐ Improvement Permit with site plan valid for sixty months ☒

Signed: [signature] date 9-13-07 Installed by: Craig Thompson

Improvement Permit by: Judy Melville date 9-12-07 Operation Permit by: Wesley Sparks REHS date 3/14/08

Authorization to Construct by: Judy Melville date 9-12-07 Existing System Inspection by: ____ date ____

HEALTH DEPT. COPY: WHITE OWNER COPY (FINAL): YELLOW OWNER COPY (INITIAL): PINK

06/27/2008 09:09 7046523239 PAGE 01