# IREDELL COUNTY HEALTH DEPARTMENT

## IMPROVEMENT PERMIT / AUTHORIZATION TO CONSTRUCT / OPERATION PERMIT / EXISTING SYSTEM INSPECTION

STATESVILLE 704-878-5305 MOORESVILLE 704-664-5281

11-1-31

PERMIT# 136330 PIN# 4676-71-6970

OWNER OR APPLICANT IREDELL GROUP, LLC / Mid Atlantic DATE 7-27-06

ADDRESS 109-C WILLIAMSON ROAD, MOORESVILLE, NC 28117 PHONE: Business Home 704-663-4050

LOCATION NC 152 E, TR TEETER RD, TL WALDEN DR, TR RIVERCHASE LANE, AT END ON LEFT

SUBDIVISION WALDEN RIDGE BLOCK / SECTION LOT 35 LOT AREA 1.50 ACRES SITE CLASS. PS DESIGN FLOW 480 L.T.A.R. 0.25 GPD/FT²

Septic Tank: 1000 Gallons; STB AT Date 10-10-06

Pump Tank: Gallons; PT Date

Pump Make: Model Serial No.

Nitrification Field: No Fields I Square Feet EQ.P 1920 Linear Feet 480

No Lines FOUR Trench Width 36" Max Trench Bottom Depth 22" Gravel Depth N/A

☑ New System ☐ Repair ☐ Expansion System Type: I II III IV V VI

System Description: 25% REDUCTION GRAVITY

Repair System Description: 50% REDUCTION, LOW PRESSURE

Maintenance Agreement Required: ☐ Yes ☑ No

☑ Gravity ☐ Pressure

☑ House/Mod. Home ☐ Mobile Home ☐ Business ☐ Other

No. Bedrooms 4 No. Persons No. Employees


Water Supply: ☑ Individual ☐ Public ☐ Community

☐ Slab ☑ Crawl Space ☐ Basement w/plumbing ☐ Basement wo/plumbing


Comments:/Conditions: ① KEEP SYSTEM MINIMUM 100' FROM WELL ② INSTALL 25% REDUCTION SYSTEM ON CONTOUR AS SHOWN, NO DEEPER THAN 22"

Comments:/Conditions:

INITIAL SITE SKETCH

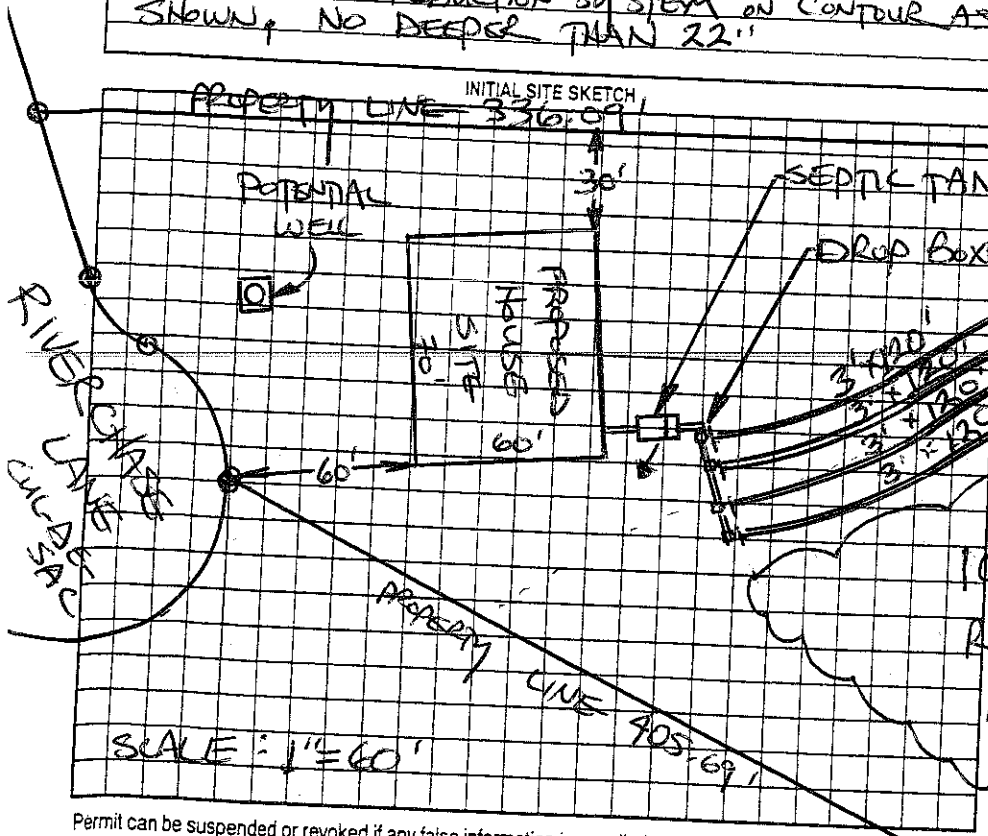


AS BUILT SKETCH

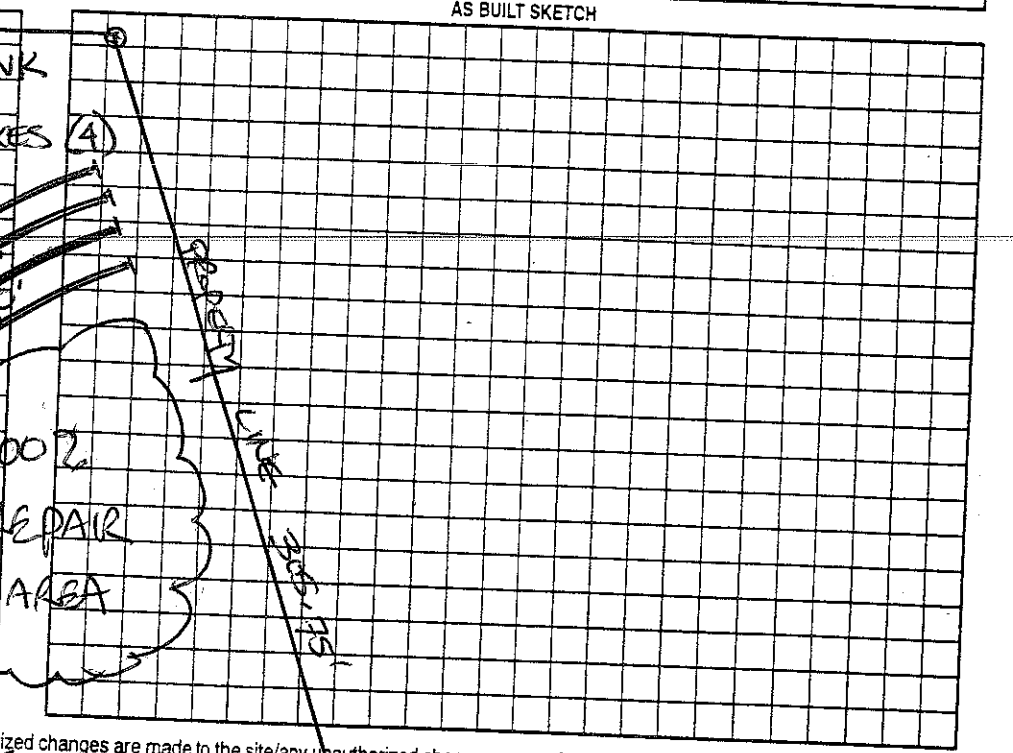


Permit can be suspended or revoked if any false information is supplied toward securing the permit/any unauthorized changes are made to the site/any unauthorized changes are made in the installation of the system. Improvement Permit with plat valid without expiration ☐ Improvement Permit with site plan valid for sixty months ☑ Authorization to Construct is valid for a period equal to that of Improvement Permit – not to exceed sixty months.

Signed: Steve Hedrick date 8-1-06

Improvement Permit by: STEVE HEDRICK date 7-27-06

Authorization to Construct by: RS date 8/4/06

Installed by: Howard's Backhoe

Operation Permit by: John E Oliphant date 1/31/07

Existing System Inspection by: date

HEALTH DEPT. COPY: WHITE OWNER COPY (FINAL): YELLOW OWNER COPY (INITIAL): PINK