IREDELL COUNTY HEALTH DEPARTMENT

STATESVILLE 704-878-5305 MOORESVILLE 704-664-5281

IMPROVEMENT PERMIT / AUTHORIZATION TO CONSTRUCT / OPERATION PERMIT / EXISTING SYSTEM INSPECTION

PERMIT# 140406 PIN# 4676-72-2174 DATE 2-12-07

OWNER OR APPLICANT Mid-Atlantic Bldrs PHONE: Business 704-202-5568 Home

ADDRESS P.O. Box 3792 Mooresville NC

LOCATION N. Main St, Rt Linwood, LT Teeter, Rt into Walden Ridge (Walden Drive), RT Riverchase, on LT

SUBDIVISION Walden Ridge BLOCK / SECTION LOT 39 LOT AREA 1.00 Ac SITE CLASS. PS DESIGN FLOW 480 L.T.A.R. .50

Septic Tank: 1000 Gallons; STB Date

Pump Tank: Gallons; PT Date

Pump Make: Model Serial No.

Nitrification Field: No Fields 1 Square Feet 1200 Linear Feet 400

No Lines 4@100' Trench Width 36" Max Trench Bottom Depth 36"

☒ New System ☐ Repair ☐ Expansion System Type: I II III IV V VI

System Description: Gravity - 25% Red

Repair System Description: Same

Maintenance Agreement Required: ☐ Yes ☒ No

☒ House/Mod. Home No. Bedrooms 4

☐ Mobile Home No. Persons

☐ Business No. Employees

☐ Other


Water Supply: ☐ Individual ☐ Public ☐ Community

Gravel Depth NA ☒ Gravity ☐ Pressure ☐ Slab ☒ Crawl Space ☐ Basement w/plumbing ☐ Basement wo/plumbing


Comments:/Conditions:

Comments:/Conditions:

INITIAL SITE SKETCH

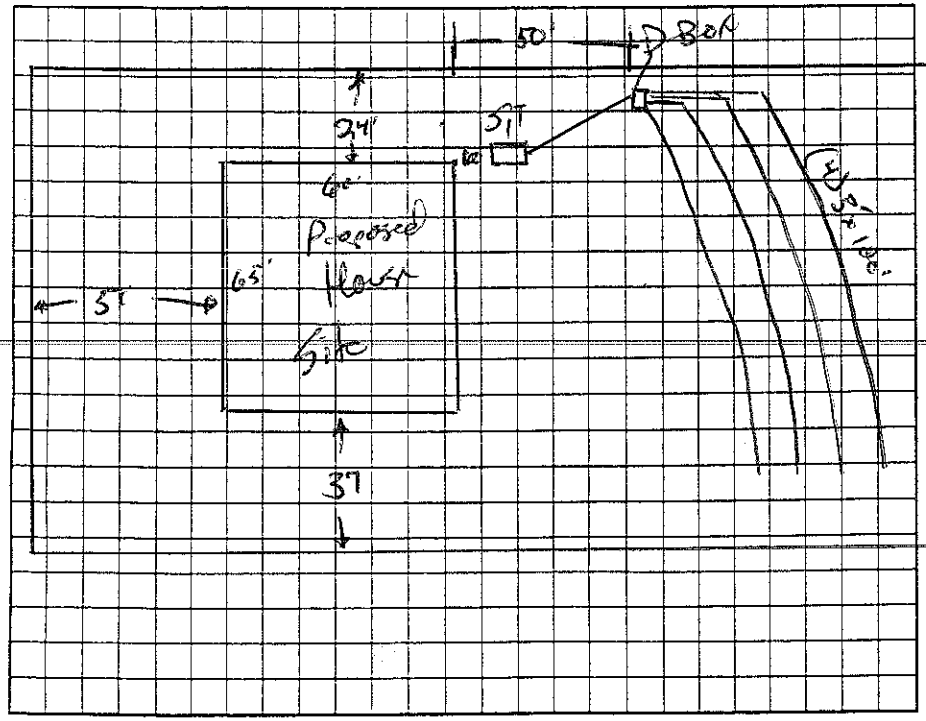

AS BUILT SKETCH

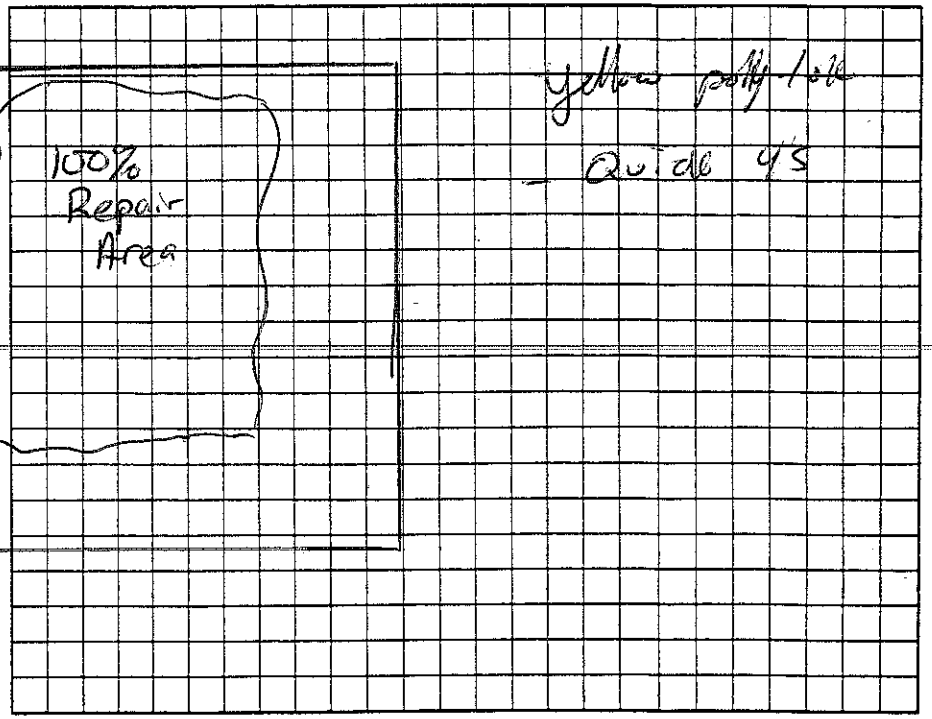

Permit can be suspended or revoked if any false information is supplied toward securing the permit/any unauthorized changes are made to the site/any unauthorized changes are made in the installation of the system. Improvement Permit with plat valid without expiration. ☐ Improvement Permit with site plan valid for sixty months ☒ Authorization to Construct is valid for a period equal to that of Improvement Permit – not to exceed sixty months.

Signed: date 2/12/07 Installed by: Craig Thompson

Improvement Permit by: date 2-12-07 Operation Permit by: date 5-16-07

Authorization to Construct by: date 2-12-07 Existing System Inspection by: date

HEALTH DEPT. COPY: WHITE OWNER COPY (FINAL): YELLOW OWNER COPY (INITIAL): PINK