...LL COUNTY HEALTH DEPARTMENT

STA...VILLE 704-878-5305 MOORESVILLE 704-664-5281

...MPROVEMENT PERMIT / AUTHORIZATION TO CONSTRUCT / OPERATION PERMIT / EXISTING SYSTEM INSPECTION

PERMIT# 13956 PIN# 4676722348 DATE 2/26/07

OWNER OR APPLICANT Ray Short / Mid Atlantic Bldrs PHONE: Business Home

ADDRESS Denver NC 28037

LOCATION N. Main St Rt Linwood, Lt Teeter, Rt into Walden, Rt Riverchase Ln, Property on Rt on Walnut Hill corner

SUBDIVISION Walden Ridge BLOCK / SECTION LOT 41 LOT AREA 1.00 Acre SITE CLASS. P3 DESIGN FLOW 480 L.T.A.R. .50

Septic Tank: 1000 Gallons: STB 1012 Date 1/3/07

Pump Tank: Gallons: PT Date

Pump Make: Model Serial No.

Nitrification Field: No Fields 1 Square Feet 1200 Linear Feet 400

No Lines 4@100' Trench Width 36" Max Trench Bottom Depth 36" Gravel Depth N/A

☒ New System ☐ Repair ☐ Expansion System Type: I II III IV V VI

System Description: Gravity - 25% Reduction

Repair System Description: Gravity/Pressure - 25% Red

Maintenance Agreement Required: ☐ Yes ☒ No

☒ House/Mod. Home ☐ Mobile Home ☐ Business ☐ Other

No. Bedrooms 4 No. Persons No. Employees


Water Supply: ☒ Individual ☐ Public ☐ Community

☐ Gravity ☐ Pressure ☐ Slab ☒ Crawl Space ☐ Basement w/plumbing ☐ Basement wo/plumbing


Comments:/Conditions: Follow Contours with drain lines
- A minimum 15 Foot setback from pool to any part of septic system (tanks, lines, etc)

Comments:/Conditions:

INITIAL SITE SKETCH

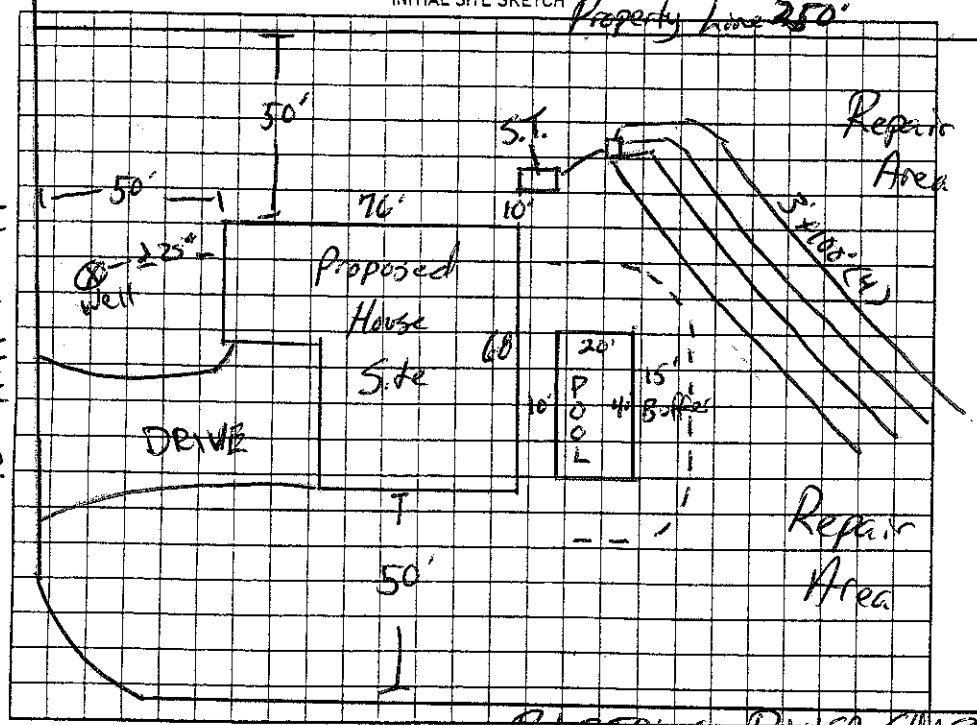

AS BUILT SKETCH

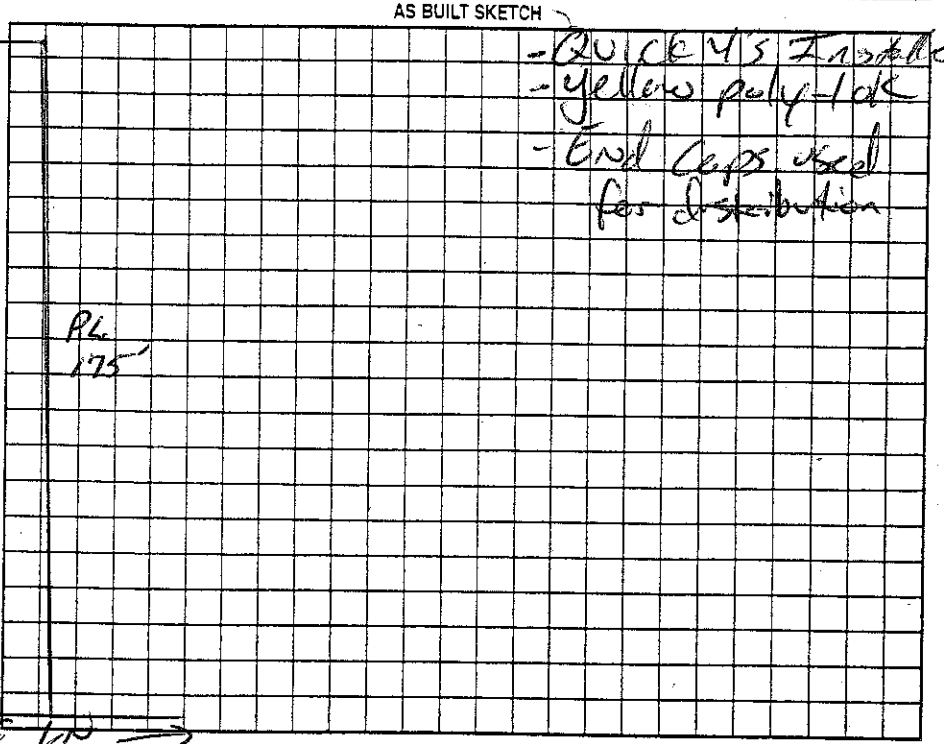

P.L. 250' ← RIVER CHASE LN →

Permit can be suspended or revoked if any false information is supplied toward securing the permit/any unauthorized changes are made to the site/any unauthorized changes are made in the installation of the system. Improvement Permit with plat valid without expiration ☐ Improvement Permit with site plan valid for sixty months ☒ Authorization to Construct is valid for a period equal to that of Improvement Permit – not to exceed sixty months.

Signed: John E Alt date 2/27/07 Installed by: Carter Thompson Grading

Improvement Permit by: John E Alt date 2/27/07 Operation Permit by: John E Alt date 7/17/07

...orization to Construct by: John E Alt date 2/27/07 Existing System Inspection by: date

HEALTH DEPT. COPY: WHITE OWNER COPY (FINAL): YELLOW OWNER COPY (INITIAL): PINK