IREDELL COUNTY HEALTH DEPARTMENT

STATESVILLE 704-878-5305 MOORESVILLE 704-664-5281

IMPROVEMENT PERMIT / AUTHORIZATION TO CONSTRUCT / OPERATION PERMIT / EXISTING SYSTEM INSPECTION

PERMIT # 146091 PIN # 4676723461 DATE 10-20-08

OWNER or APPLICANT Paul Allen PHONE: Business 704 902-7654 Home: (704) 799-2454

OWNER or APPLICANT ADDRESS 153 Riverchase Ln. Mooresville, NC 28115

LOCATION / DIRECTIONS Main St TR Linwood TL Teeter TR Walden Ridge TR Riverchase TL Walnut Hill Ct on Rt.

SUBDIVISION Walden Ridge BLOCK / SECTION LOT # 42 LOT AREA 1.0 Acre DESIGN FLOW 600 gpd L.T.A.R. 3

Septic Tank 1500 Gallons: STB 444 Date 9-8-08 ☒ New System ☐ Repair ☐ Expansion System Type I II III IV V VI

Pump Tank Gallons: P.T Date

Pump Make Model Serial #

System Description: Gravity - 25% Reduction

Nitrification Field No Fields 1 No Lines 4 Linear Feet ~600'

Repair System Description: LP Panel Block

Trench Width 36 Max. Trench Bottom Depth 36" Gravel Depth N/A

Maintenance Agreement Required ☐ YES ☒ NO

☒ GRAVITY ☐ PRESSURE


☒ Residence No. Bedrooms 6 ☐ Business No. Persons ☐ Other No. Employees ☐ Slab ☐ Crawl Space ☒ Basement w/plumbing ☐ Basement w/o plumbing

Water Supply: ☒ Private ☐ Public ☐ Community

Comments / Conditions


Comments / Conditions: This permit replaces previous permit dated 1-25-08 Drawn as installed, used Quick 4 for drainfield

INITIAL SITE SKETCH

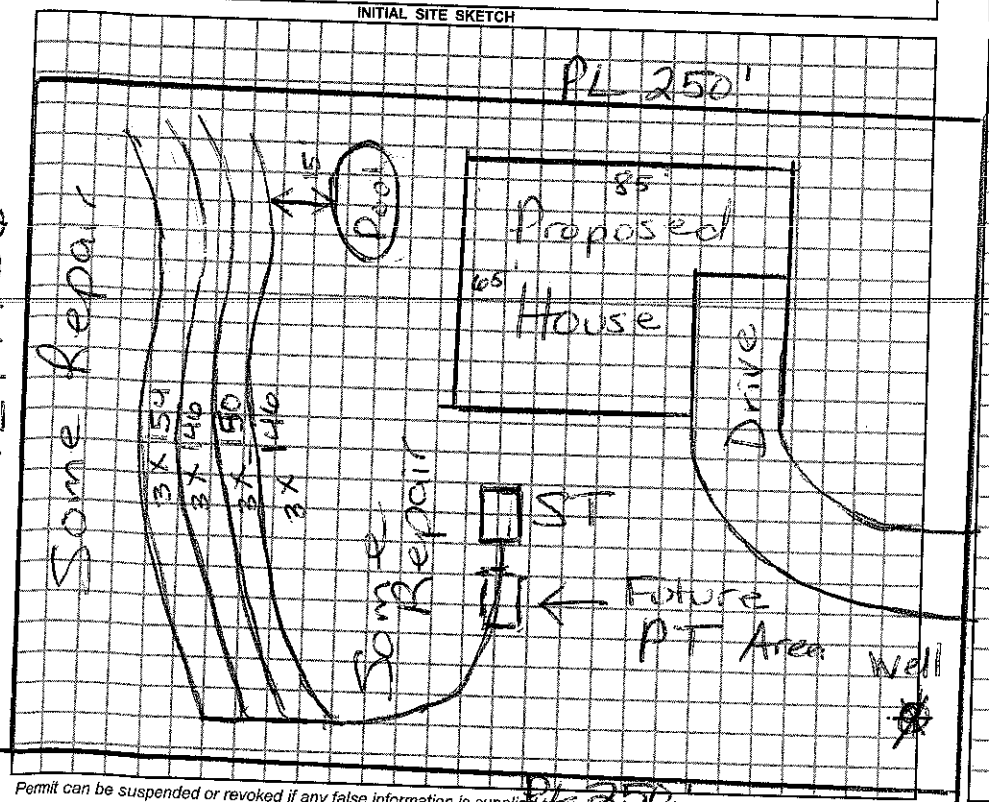

PL 174.56

AS BUILT SKETCH

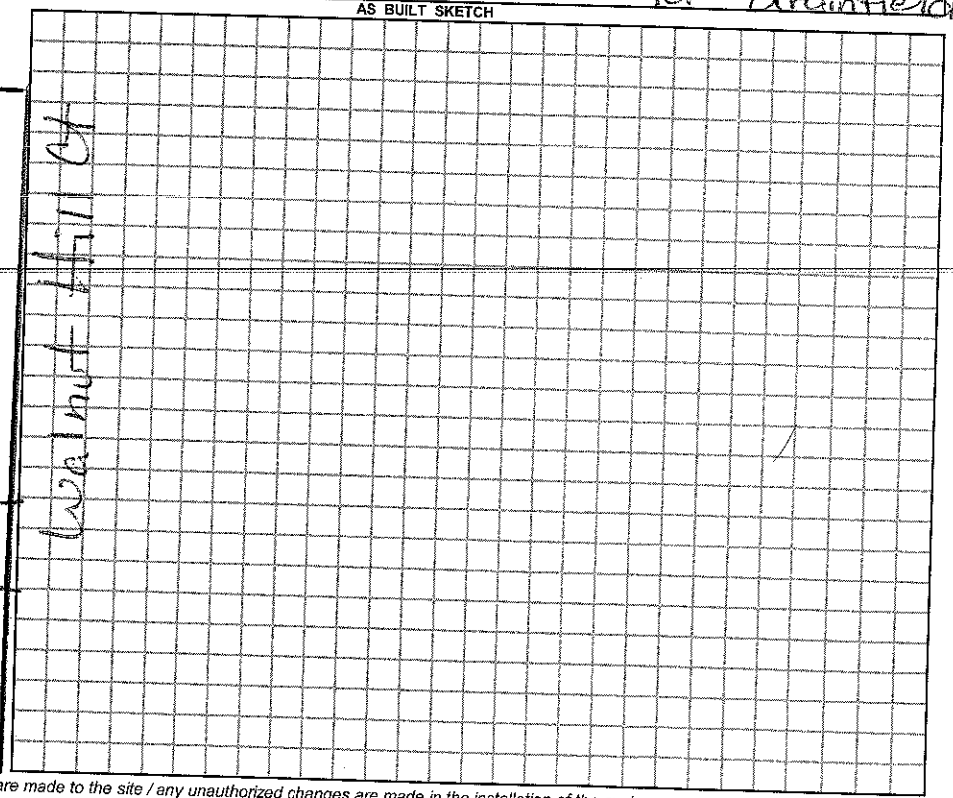

Permit can be suspended or revoked if any false information is supplied toward securing the permit / any unauthorized changes are made to the site / any unauthorized changes are made in the installation of the system.

☐ IMPROVEMENT PERMIT w / plat valid without expiration ☐ IMPROVEMENT PERMIT w / site plan valid for 60 mos. ☐ AUTHORIZATION TO CONSTRUCT valid for period equal to IMPROVEMENT PERMIT-not to exceed 60 mo.

Owner / Applicant Signature: Date 11/10/08

Improvement Permit by: Maria H. Watson RS Date 10/20/08

Authorization to Construct by: Maria H. Watson RS Date 10/20/08

YOU SHOULD CONTACT A LOCATOR SERVICE PRIOR TO ANY EXCAVATION.

Installed by: Richard Abernathy

Operation Permit by: Maria H. Watson RS Date: 11/10/08

Existing System Inspected by: Date:

WHITE COPY Environmental Health YELLOW COPY (Final) Owner / Applicant PINK COPY (Initial) Owner / Applicant