IREDELL COUNTY HEALTH DEPARTMENT

STATESVILLE 704-878-5305 | MOORESVILLE 704-664-5281

550.00 Paid

IMPROVEMENT PERMIT / AUTHORIZATION TO CONSTRUCT / OPERATION PERMIT / EXISTING SYSTEM INSPECTION

PERMIT# 13831120 PIN# 4676723744 DATE 10/4/06

OWNER OR APPLICANT MID-Atlantic Bldrs, Inc PHONE: Business (828) 478-2761 Home

ADDRESS PO Box 3742 Mooresville 28117

LOCATION N. Main St Rt on Linwood, Lt on Teeter, Rt on Walden Dr, Follow to Walnut Hill - on Lt

SUBDIVISION Walden Ridge BLOCK / SECTION LOT 48 LOT AREA 1.021 Ac SITE CLASS. P5 DESIGN FLOW 480gpd L.T.A.R. .30

Septic Tank: 1000+ Gallons; STB 794 Date 2-15-07
Pump Tank: 1000 Gallons; PT 34 Date 3-11-07
Pump Make: Goulds Model PC5TM Serial No.
Nitrification Field: No. Fields 1 Square Feet 1200 Linear Feet 400
No Lines 4@100' Trench Width 36" Max Trench Bottom Depth 36" Gravel Depth N/A

☒ New System ☐ Repair ☐ Expansion System Type: I II III IV V VI
System Description: PM to Gravity - 25% Red
Repair System Description: PDBPS - LP
Maintenance Agreement Required: ☐ Yes ☒ No

☒ House/Mod. Home No. Bedrooms 4
☐ Mobile Home No. Persons
☐ Business No. Employees
☐ Other


Water Supply: ☒ Individual ☐ Public ☐ Community

☐ Gravity ☒ Pressure ☐ Slab ☐ Crawl Space ☒ Basement w/plumbing ☐ Basement wo/plumbing

Comments:/Conditions: Follow Contours - Keep tank & PM 15' from house - Supply line 10' from house - Lines must be 10' from Prop line

Comments:/Conditions:

INITIAL SITE SKETCH

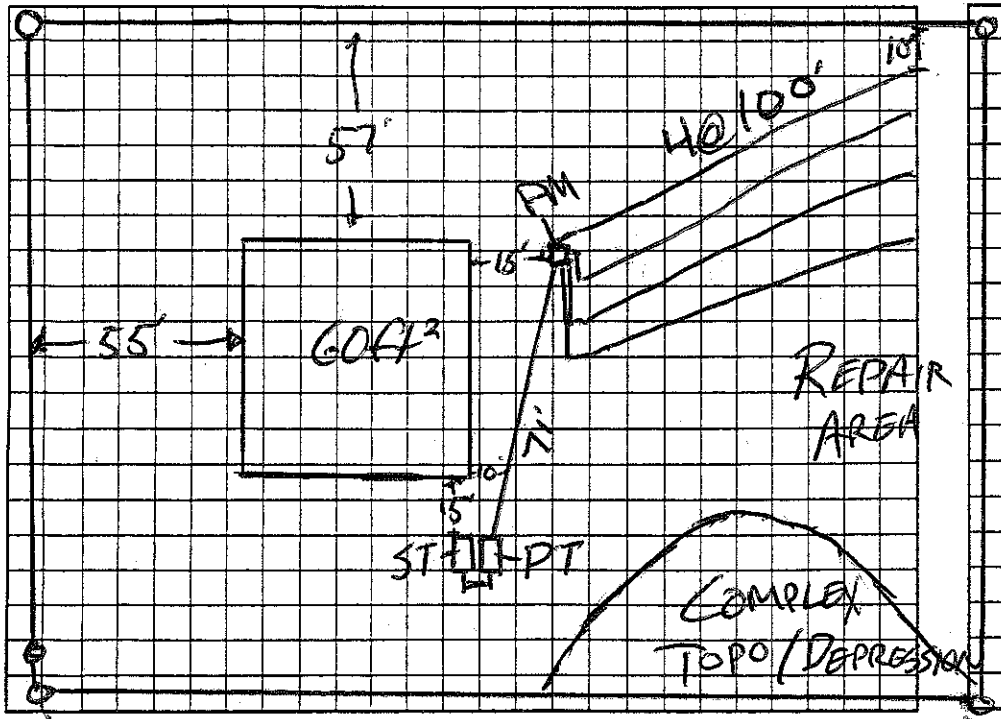

AS BUILT SKETCH

Walnut Hill Ct

Permit can be suspended or revoked if any false information is supplied toward securing the permit/any unauthorized changes are made to the site/any unauthorized changes are made in the installation of the system. Improvement Permit with plat valid without expiration ☐ Improvement Permit with site plan valid for sixty months ☒ Authorization to Construct is valid for a period equal to that of Improvement Permit – not to exceed sixty months.

Signed: [redacted] date 10-4-06 Installed by: Howard's Backhoe

Improvement Permit by: John E Auth date 10/4/06 Operation Permit by: John E Auth date 5-7-07

Authorization to Construct by: John E Auth date 10/4/06 Existing System Inspection by: date

HEALTH DEPT. COPY: WHITE OWNER COPY (FINAL): YELLOW OWNER COPY (INITIAL): PINK