3:30

IREDELL COUNTY HEALTH DEPARTMENT

STATESVILLE 704-878-5305 MOORESVILLE 704-664-5281

IMPROVEMENT PERMIT / AUTHORIZATION TO CONSTRUCT / OPERATION PERMIT / EXISTING SYSTEM INSPECTION

PERMIT# 134606 PIN# 4676 73 0692 DATE April 18, 2006

OWNER OR APPLICANT Ehrhardt Group LLC / POINTE CONST INC. PHONE: Business 704 344-5994 Home

ADDRESS 109 C Williamson Rd. / Mooresville N.C. 28117

LOCATION Linwood Rd (S) TL Tooter Rd. TR Walden Ridge on left just before cul-de-sac

SUBDIVISION Walden Ridge BLOCK / SECTION LOT 56 LOT AREA 1.34 Ac SITE CLASS. PS DESIGN FLOW 480gpd L.T.A.R. .03

Septic Tank: 1000 Gallons; STB 312 Date 9-5-07

Pump Tank: 1000 Gallons; PT 38 Date 9-12-07

Pump Make: Gould's Model PES1M Serial No. 500067987

Nitrification Field: No Fields 1 Square Feet 1200 Linear Feet 400

No Lines 3 Trench Width 36" Max Trench Bottom Depth 36" Gravel Depth NA ☐ Gravity ☒ Pressure ☐ Slab ☒ Crawl Space ☒ Basement w/plumbing ☐ Basement wo/plumbing

☒ New System ☐ Repair ☐ Expansion System Type: I II III IV V VI

System Description: PM 25% Reduction

Repair System Description: LPP BPS -

Maintenance Agreement Required: ☐ Yes ☒ No Initially

☒ House/Mod. Home ☐ Mobile Home ☐ Business ☐ Other

No. Bedrooms 4 No. Persons ___ No. Employees ___

Water Supply: ☒ Individual ☐ Public ☐ Community

Comments:/Conditions:

Comments:/Conditions: DRH

Drainlines checked 5/8/08 AC Tanks checked 5/9/08

INITIAL SITE SKETCH

SEE Plan from Rollins Soil & Env. Services

AS BUILT SKETCH


Permit can be suspended or revoked if any false information is supplied toward securing the permit/any unauthorized changes are made to the site/any unauthorized changes are made in the installation of the system. Improvement Permit with plat valid without expiration ☐ Improvement Permit with site plan valid for sixty months ☒ Authorization to Construct is valid for a period equal to that of Improvement Permit – not to exceed sixty months.

Signed: Thomas Brooks date 4-24-06 Installed by: Richard Abernathy

Improvement Permit by: [signature] date 4-18-06 Operation Permit by: Wesley Sparks R.S. date 10/2/08

Authorization to Construct by: Wesley Sparks R.S. date 11/14/06 Existing System Inspection by: ___ date ___

HEALTH DEPT. COPY: WHITE OWNER COPY (FINAL): YELLOW OWNER COPY (INITIAL): PINK

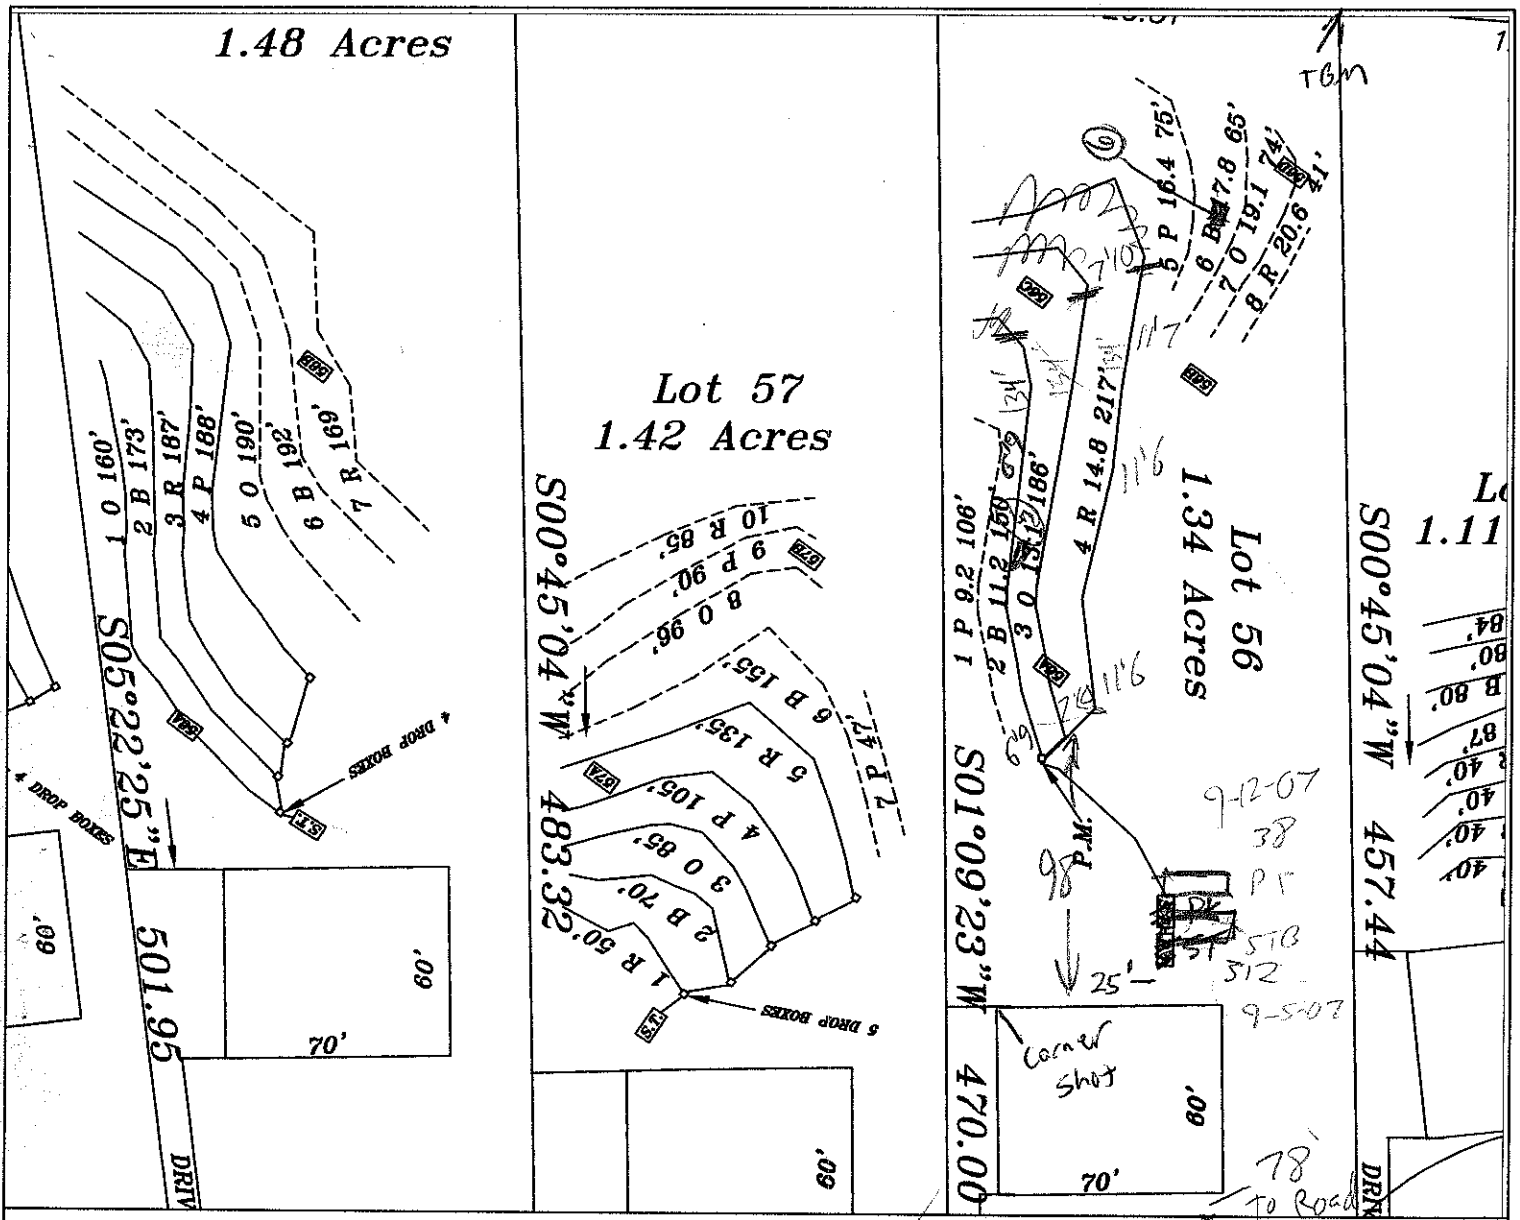

LEGEND

- Areas contain soils with 24 inches or more of useable material and have potential for conventional, modified conventional and low-pressure pipe (lpp) septic systems.
- Unsuitable areas.
- System lines.
- Repair lines.
- Temporary Bench Mark (TBM)
- Well Location.

GRAPHIC SCALE
1" = 60'

60 0 60 120

FOR PRELIMINARY PLANNING PURPOSES ONLY. ALL LOTS WILL REQUIRE FINAL APPROVAL BY THE COUNTY HEALTH DEPARTMENT ON A LOT BY LOT BASIS. THIS MAP SHOULD BY USED AS A GENERAL GUIDE, SOME ADJUSTMENTS WILL BE NECESSARY IN THE FIELD DUE TO SOIL VARIABILITY AND COMPLEX TOPOGRAPHIC FEATURES. THIS MAP ONLY REFLECTS EXISTING SOIL SUITABILITY FOR ON-SITE SEPTIC TANK SYSTEMS.

PLEASE REFER TO ATTACHED SOIL REPORT FOR ADDITIONAL SITE SPECIFIC INFORMATION

ROLLANS SOIL & ENVIRONMENTAL SERVICES
2120 GRAHAM ROAD
MOUNT ULLA, NC 28125
PHONE/FAX: (704) 278 - 0989
ASHLEY ROLLANS, NC LICENSED SOIL SCIENTIST
MOBILE: (704) 746 - 5046
EMAIL: ROLLANSFORTCJ@AOL.COM

MAP TITLE: SITE PLAN & DRAINFIELD AREAS

PROJECT NAME: REDELL GROUP LLC/WALDEN RIDGE SUBDIVISION

LOCATION/DATE: TEETER ROAD, REDELL COUNTY, NORTH CAROLINA, DECEMBER 2006

JOB # : 01-1069
FILE: C:\JOBS\01-1069
PROJECT MGR.: CBF
FIELD WORK: CBF AND AP
DRAWN BY: CBP AND AP