3:30

IREDELL COUNTY HEALTH DEPARTMENT

STATESVILLE 704-878-5305 MOORESVILLE 704-664-5281

IMPROVEMENT PERMIT / AUTHORIZATION TO CONSTRUCT / OPERATION PERMIT / EXISTING SYSTEM INSPECTION

PERMIT# 134603 PIN# 4676 73 2262 DATE 2/26/07

OWNER OR APPLICANT Pointe Construction PHONE: Business 704-902-7654 Home 704-799-2454

ADDRESS 318 Glenwood Dr. Mooresville, NC. 28115

LOCATION Lakewood Rd S TL Tuter TR Walden Ridge TR Riverchase, Corner lot on (L)

SUBDIVISION Walden Ridge BLOCK / SECTION LOT 51 LOT AREA 1.3Ac SITE CLASS. PS DESIGN FLOW 480 L.T.A.R. .3

Septic Tank: 1000 Gallons; STB 312 Date 2-26-07

Pump Tank: 1000 Gallons; PT 27 Date 8-5-07

Pump Make Goulds Model PE5TM Serial No.

Nitrification Field: No Fields 1 Square Feet 1200 Linear Feet 400

No Lines 4@100 Trench Width 3' Max Trench Bottom Depth 3'

1/2 HP

New System ☐ Repair ☐ Expansion System Type: I II (III) IV V VI

System Description: PM – 25% Reduction

Repair System Description: LP – 16" PVC

Maintenance Agreement Required: ☐ Yes ☒ No

Gravel Depth NA ☐ Gravity ☐ Pressure

☒ House/Mod. Home No. Bedrooms 4

☐ Mobile Home No. Persons

☐ Business No. Employees

☐ Other


Water Supply: ☒ Individual ☐ Public ☐ Community

☐ Slab ☐ Crawl Space ☒ Basement w/plumbing ☐ Basement wo/plumbing


Comments/Conditions: NEW DRIVE

Comments:/Conditions: Set 27# Head @ 11/8/07 Installed checked Tank, lines & pressure

INITIAL SITE SKETCH

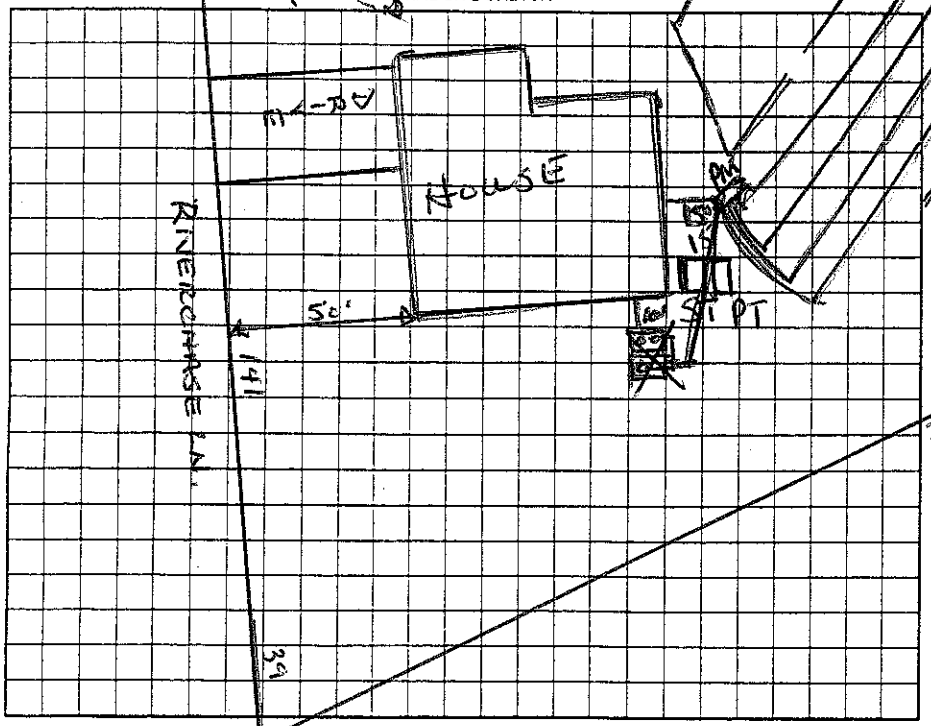

AS BUILT SKETCH

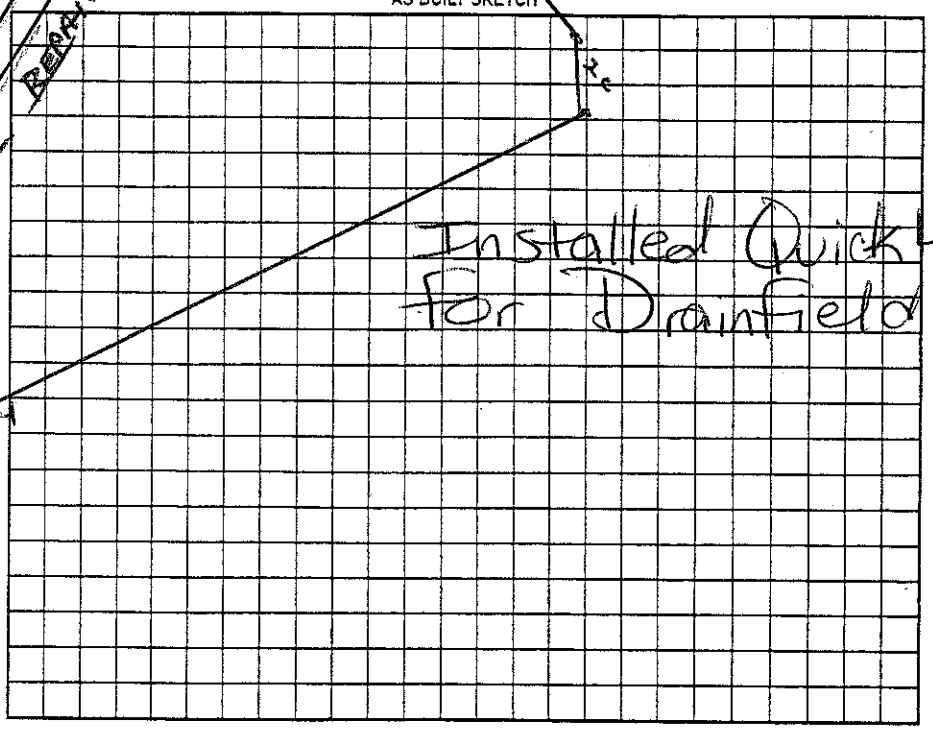

Permit can be suspended or revoked if any false information is supplied toward securing the permit/any unauthorized changes are made to the site/any unauthorized changes are made in the installation of the system. Improvement Permit with plat valid without expiration ☐ Improvement Permit with site plan valid for sixty months ☐ Authorization to Construct is valid for a period equal to that of Improvement Permit - not to exceed sixty months.

Signed: Paul Allen date 3-14-07

Improvement Permit by: Wesley Sparks R.S. date 2/26/07

Authorization to Construct by: Wesley Sparks R.S. date 2/26/07

Installed by: Richard Abernathy

Operation Permit by: Wesley Sparks R.S. date 1/31/08

Existing System Inspection by: date

HEALTH DEPT. COPY: WHITE OWNER COPY (FINAL): YELLOW OWNER COPY (INITIAL): PINK