IREDELL COUNTY HEALTH DEPARTMENT

Statesville Office (704) 878-5305 Mooresville Office (704) 660-3625 PERMIT # 217233

IMPROVEMENT PERMIT / AUTHORIZATION TO CONSTRUCT / OPERATION PERMIT / EXISTING SYSTEM

PIN # 4676-73-2602

APPLICANT: Dale Seelman / Ray Cox APPLICANT ADDRESS: PO Box 4856 Mooresville NC 28117

SITE ADDRESS: 181 Walden Dr - Mooresville PHONE: ALT. PHONE:


SITE DIRECTIONS: Main St/Hwy 152 N, TR Linwood, TL Teeter, TR Walden, Lot on L in Cul-de-sac

SUBDIVISION: Walden Ridge SECTION: -1- LOT # 55 LOT AREA: 1.1 ac DESIGN FLOW: 480 gpd L.T.A.R.: 0.325


Septic Tank	1000 (gal)	STB 825	Date 1-4-17	☑ New System ☐ Repair ☐ Expansion	System Type: I II III IV V VI	☑ Residence	No. Bedrooms 4	Water Supply
Pump Tank	(gal)	PT	Date	System Description: Gravity 25% Reduction		☐ Business	No. Persons 8	☑ Private
Pump Make	Model		Serial #	Repair System Description: LP PPBPS		☐ Other	No. Employees	☐ Public
# Nitrification Fields 1	# Lines 6		Linear Ft: 370'	Maintenance Agreement Required:	☐ YES ☑ NO	☐ Slab	☐ Crawl Space	☐ Community
Trench Width 36"	Max. Trench Bottom Depth 28"		Gravel Depth N/A	☑ GRAVITY	☐ PRESSURE	☑ Basement w/plumbing	☐ Basement w/o plumbing	

Comments / Conditions: Maintain minimum 15' off of the gully edge or any cut greater than 2'. Maintain 25' off center line of drainage ditch; Install lines as shown, any modification will impact pool area.

INITIAL SITE SKETCH

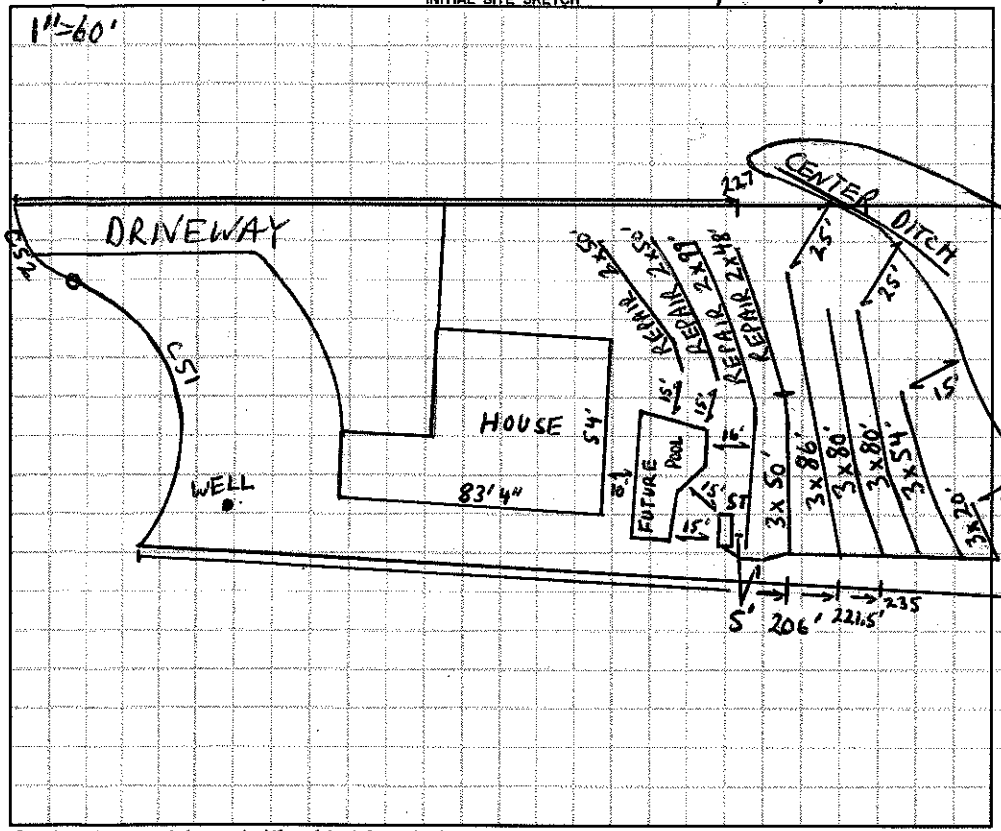

AS BUILT SKETCH

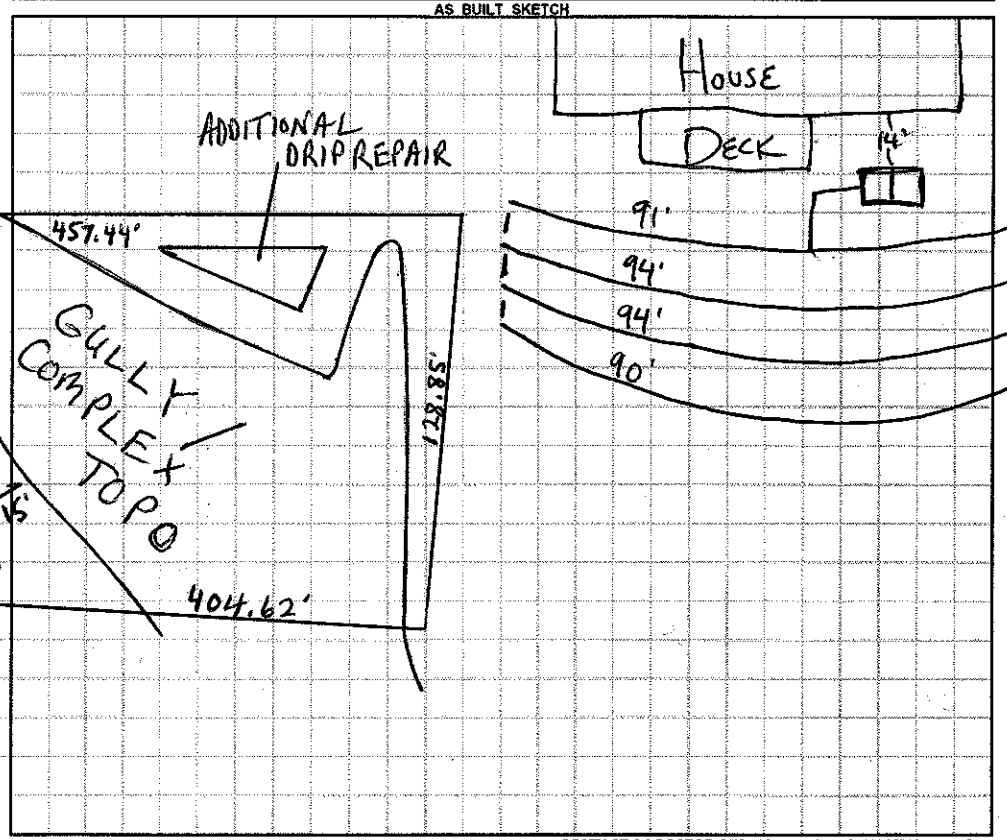

Permit can be suspended or revoked if any false information is supplied toward securing the permit / any unauthorized changes are made to the site / any unauthorized changes are made in the installation of the system. **CONTACT A LOCATOR SERVICE PRIOR TO ANY EXCAVATION**

☐ **IMPROVEMENT PERMIT** *with plat valid without expiration.* ☒ **IMPROVEMENT PERMIT** *with site plan valid for 60 mos.* ☒ **AUTHORIZATION TO CONSTRUCT** *valid for period equal to IMPROVEMENT PERMIT--not to exceed 60 mo.*

Owner / Applicant Signature: Dale X Seelman Date: 4/25/16 Installed by: Rowan Septic

IMPROVEMENT PERMIT by: Date: 4-20-16 OPERATION PERMIT by: Date: 7-9-17

AUTHORIZATION TO CONSTRUCT by: Date: 4-21-16 Existing System Inspected by: Date:

Health Dept. Copy - WHITE Applicant (Final Approval) - YELLOW Applicant (Conditional Approval) - PINK