IREDELL COUNTY HEALTH DEPARTMENT

STATESVILLE 704-878-5305 X MOORESVILLE 704-664-5281

IMPROVEMENT PERMIT / AUTHORIZATION TO CONSTRUCT / OPERATION PERMIT / EXISTING SYSTEM INSPECTION

PERMIT # 13195 PIN # 4676735640 DATE 11-28-2012

OWNER or APPLICANT ML Young Construction PHONE: Business 7043635571 Home: 7046642774

OWNER or APPLICANT ADDRESS 224 Fourtrax Mooresville, NC 28115

LOCATION / DIRECTIONS Main St. TR Linwood TL Teeter Rd TR Walden, Dr at end just past Riverchase

SUBDIVISION Walden Ridge BLOCK / SECTION LOT # 53 LOT AREA 1.4Ac DESIGN FLOW 480gpd L.T.A.R. .3

Septic Tank 1000 Gallons: STB 825 Date 6-27-13

Pump Tank Gallons: PT Date

Pump Make Model Serial #

Nitrification Field No Fields 1 No Lines 4 Linear Feet 400'

Trench Width 36" Max. Trench Bottom Depth 36" Gravel Depth N/A

☒ New System ☐ Repair ☐ Expansion System Type I II III IV V VI

System Description: Gravity - 25% Reduction

Repair System Description: Pump - LP - PPBPS

Maintenance Agreement Required ☐ YES ☒ NO

☒ GRAVITY ☐ PRESSURE

☒ Residence No. Bedrooms 4

☐ Business No. Persons

☐ Other No. Employees

☐ Slab ☐ Crawl Space

☒ Basement w/plumbing ☐ Basement w/o plumbing

Water Supply: ☒ Private ☐ Public ☐ Community


Comments / Conditions

- Keep Septic System 100ft from Well & 15ft side gradient from basement & 10ft to PL


Comments / Conditions

- Builder/Owner will use Grinder pump for Basement plumbing. Must discharge into House plumbing & Not directly into Septic Tank.

INITIAL SITE SKETCH

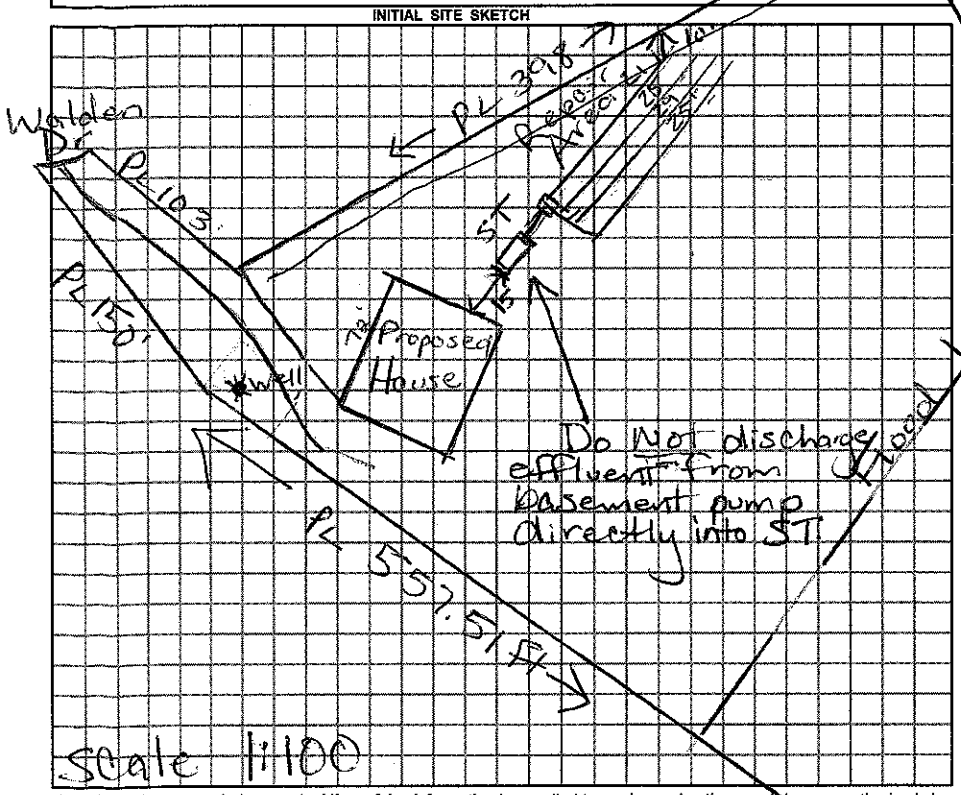

AS BUILT SKETCH

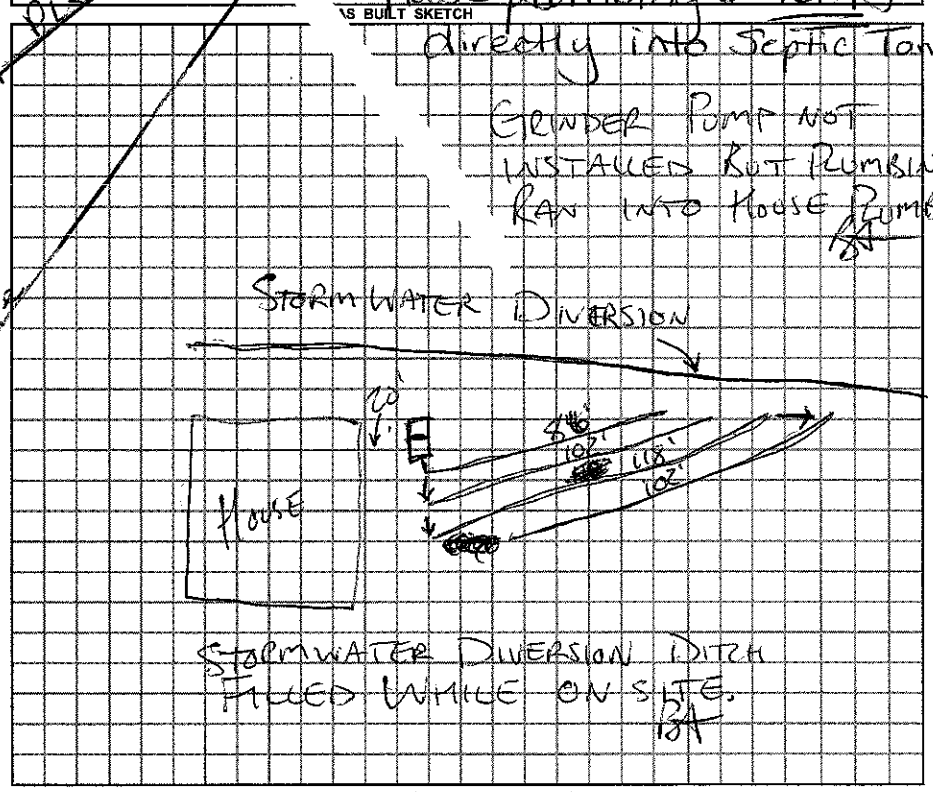

Permit can be suspended or revoked if any false information is supplied toward securing the permit / any unauthorized changes are made to the site / any unauthorized changes are made in the installation of the system.

☐ *IMPROVEMENT PERMIT w / plat valid without expiration.* ☒ *IMPROVEMENT PERMIT w / site plan valid for 60 mos.* ☒ *AUTHORIZATION TO CONSTRUCT valid for period equal to IMPROVEMENT PERMIT-not to exceed 60 mo.*

Owner / Applicant Signature: Date 12-4-12

Improvement Permit by: Date 11/28/12

Authorization to Construct by: Date 11/28/12

YOU SHOULD CONTACT A LOCATOR SERVICE PRIOR TO ANY EXCAVATION.

Installed by: Rowan Septic

Operation Permit by: Date: 8-22-13

Existing System Inspected by: Date:

WHITE COPY Environmental Health YELLOW COPY (Final) Owner / Applicant PINK COPY (Initial) Owner / Applicant