IREDELL COUNTY HEALTH DEPARTMENT

STATESVILLE 704-878-5305 MOORESVILLE 704-664-5281

IMPROVEMENT PERMIT / AUTHORIZATION TO CONSTRUCT / OPERATION PERMIT / EXISTING SYSTEM INSPECTION

PERMIT# 078961 PIN# 4676668958 4676 764884 DATE 1/28/99

OWNER OR CONTRACTOR LAVETTE TEETER PHONE: Business Home 664-1947

ADDRESS 604 BRIARWOOD DR. MOORESVILLE NC 28115

LOCATION 152E - TR TEETER RD - 1.5 MILE ON RT - .3 MILE OF RD.

SUBDIVISION — BLOCK / SECTION — LOT — LOT AREA 259.21AC SITE CLASS. PS DESIGN FLOW 360 L.T.A.R. .30 PD/LTR

Septic Tank: 1000 Gallons; STB 794 Date 10/4/99

Pump Tank: Gallons; PT Date

Pump Make: Model Serial No.

Nitrification Field: No Fields 1 Square Feet 1200 Linear Feet 400

No Lines 5@80' Trench Width 36" Max Trench Bottom Depth 36" Gravel Depth 12"

☑ New System ☐ Repair System Type: I, II, III, IV, V, VI

System Description: GRAVITY CONVENTIONAL

Repair System Description: SAME

Maintenance Agreement Required: ☐ Yes ☑ No

☑ House/Mod. Home No. Bedrooms 3

☐ Mobile Home No. Bathrooms 2

☐ Business No. Employees

☐ Other


☐ Slab ☑ Crawl Space ☐ Basement w/plumbing ☐ Basement wo/plumbing

Water Supply: ☑ Individual ☐ Public ☐ Community


Comments:/Conditions: CLEAN OUT EVERY 50' IN SUPPLY LINE FROM TANK TO DIST. DEVICE

Comments:/Conditions:

INITIAL SITE SKETCH NOT TO SCALE

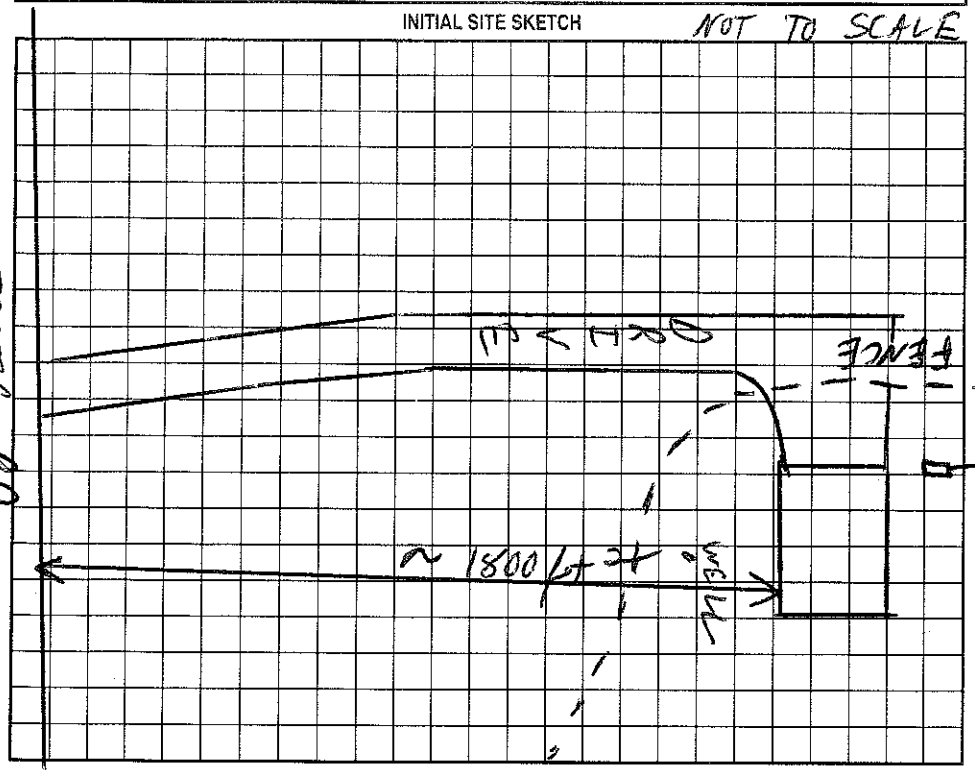

AS BUILT SKETCH

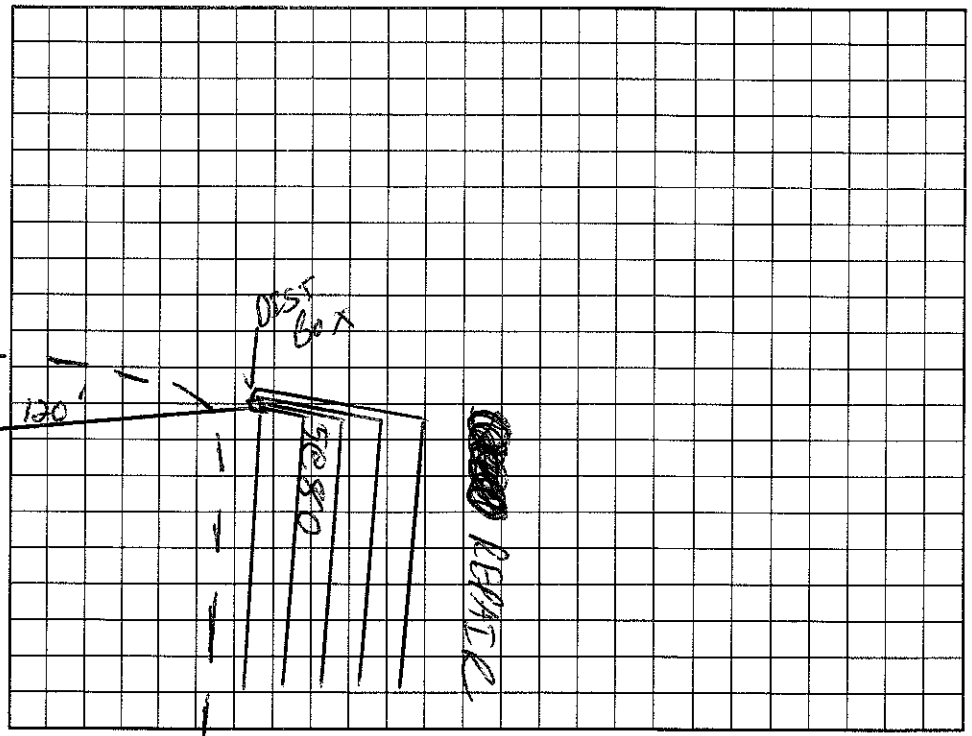

Permit can be suspended or revoked if any false information is supplied toward securing the permit/any unauthorized changes are made to the site/any unauthorized changes are made in the installation of the system. Improvement Permit with plat valid without expiration. Improvement Permit with site plan valid for sixty months. Authorization to Construct is valid for a period equal to that of Improvement Permit – not to exceed sixty months.

Signed: C. Lavette Teeter date 2-2-99 Installed by: Larry Beam

Improvement Permit by: C. [illegible] ES date 1/28/99 Operation Permit by: Wesley Hawkins RS date 5/1/00

Authorization to Construct by: C. [illegible] ES date 1/28/99 Existing System Inspection by: date

HEALTH DEPT. COPY: WHITE OWNER COPY (FINAL): YELLOW OWNER COPY (INITIAL): PINK