Site Address: 190 Rain Shadow Drive - Mirol.

IREDELL COUNTY HEALTH DEPARTMENT

STATESVILLE 704-878-5305 MOORESVILLE 704-664-5281

IMPROVEMENT PERMIT / AUTHORIZATION TO CONSTRUCT / OPERATION PERMIT / EXISTING SYSTEM INSPECTION

PERMIT# 14805 & 21523 N# 4676956328.000 4676-84-8904 DATE 8-14-08

OWNER OR APPLICANT David R. McKay, LLC PHONE: Business 664-9080 Home

ADDRESS 505 TEETER RD. Mooresville, NC 28115

LOCATION 152 E TR TEETER RD. Approx. 2 mi TL Hollybrook Subd. To Cul De Sac on RT

SUBDIVISION Hollybrook BLOCK / SECTION — LOT 10 LOT AREA 1.174 SITE CLASS. PS DESIGN FLOW 480 L.T.A.R. .3 GPD/FT²

Septic Tank: 1000 Gallons: STB 794 Date 6-24-15

Pump Tank: _____ Gallons: PT _____ Date _____

Pump Make: _____ Model _____ Serial No. _____

Nitrification Field: No Fields 1 Square Feet _____ Linear Feet 400'

No Lines 3 Trench Width 36" Max Trench Bottom Depth 36" Gravel Depth _____

☒ New System ☐ Repair ☐ Expansion System Type: I (II) III IV V VI

System Description: 25% REDUCTION

Repair System Description: 25% REDUCTION

Maintenance Agreement Required: ☐ Yes ☒ No

☒ House/Mod. Home No. Bedrooms 4

☐ Mobile Home No. Persons _____

☐ Business No. Employees _____

☐ Other _____

Water Supply: ☒ Individual ☐ Public ☐ Community

☐ Gravity ☐ Pressure ☐ Slab ☒ Crawl Space ☐ Basement w/plumbing ☐ Basement wo/plumbing

Comments:/Conditions:

Comments:/Conditions:

INITIAL SITE SKETCH

* SEE PLAN FROM WASTEWATER SOLUTIONS BY STEVE CAMEY - GSS CONSULTANTS INC.

AS BUILT SKETCH


Permit can be suspended or revoked if any false information is supplied toward securing the permit/any unauthorized changes are made to the site/any unauthorized changes are made in the installation of the system. Improvement Permit with plat valid without expiration ☐ Improvement Permit with site plan valid for sixty months ☒ Authorization to Construct is valid for a period equal to that of Improvement Permit – not to exceed sixty months.

Signed: _____ date 4-13-07 Installed by: WASTEWATER SOLUTIONS

Improvement Permit by: _____ date 8-29-06 COM 8-15-06 Operation Permit by: _____ date 3-17-16

Authorization to Construct by: _____ date 12-18-15 Existing System Inspection by: _____ date _____

HEALTH DEPT. COPY: WHITE OWNER COPY (FINAL): YELLOW OWNER COPY (INITIAL): PINK

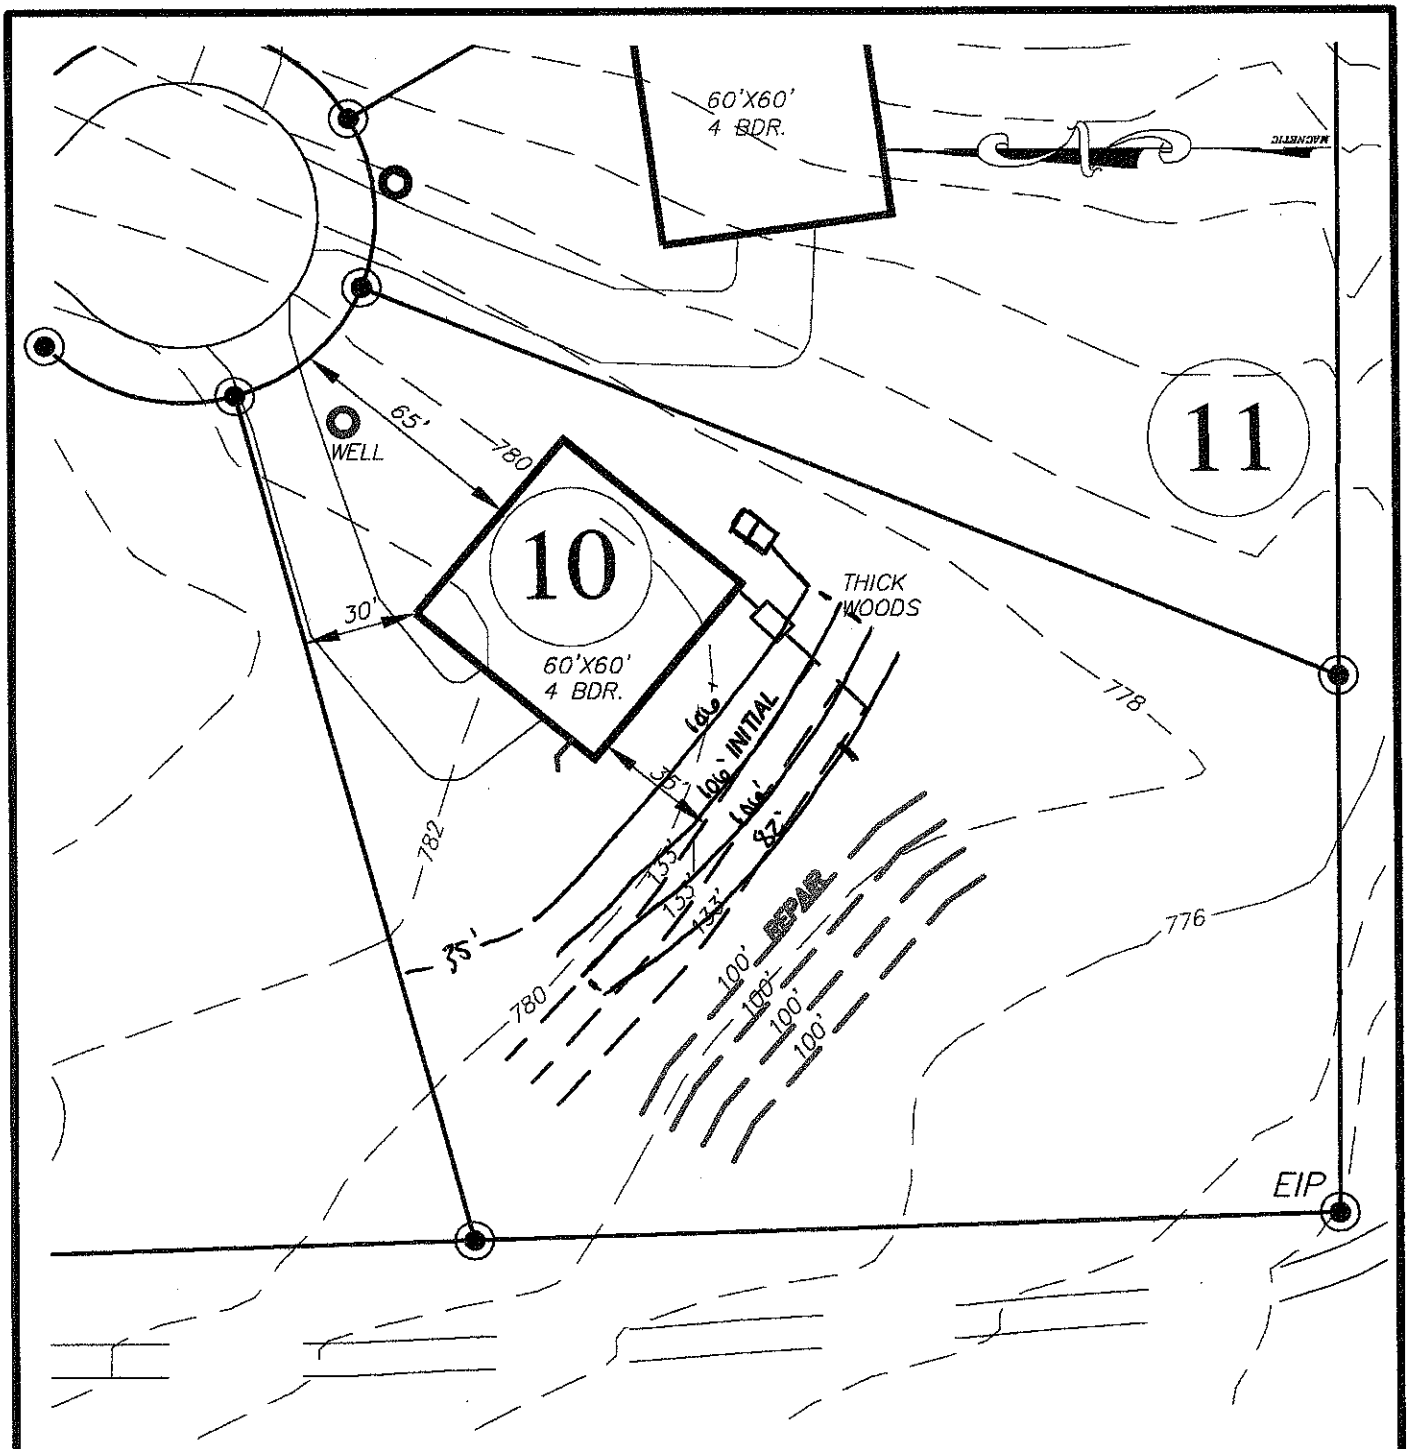

Hollybrook

FOR

DAVID R. MCKAY, LLC. & BETTY MCKAY, LLC.

505 TEETER ROAD
Mooresville, NC 28115
(704) 664-9080

IREDELL COUNTY; CODDLE CREEK NORTH CAROLINA

SEPTIC FIELD LAYOUT
LOT # 10

BAR SCALE 1"=50'

0 25 50 100